

As Built 2017 Contract Maintenance Projects Douglas County, Colorado

Roads	
HMA Overlay	Interstate
Concrete	US Highway
County Boundary	State Highway
Municipalities	Toll Highway
Parks	Major Road
Pike National Forest	Local Road
Lakes	Private
Intermittent Lakes	Forest Road
Streams	Platted Not Built
	Gated Community
	Access Easement
	Entrance/Exit Ramp



1:190,000


1 0 1

Scale in Miles

Douglas County Public Works Department: GIS Disclaimer



All GIS data and information products provided by the Douglas County Public Works Department are for illustrative purposes only. While products are considered to be accurate when provided, Douglas County does not warrant that they are error free. Douglas County Public Works Department shall not be liable for direct, indirect, incidental, or consequential damages arising from the use of such products. The recipient, and/or user, acknowledges and agrees that the use of such products is at their sole risk. Questions concerning this or any other product provided by Douglas County Public Works Department, including errors, corrections and/or updates should be directed to:

Douglas County Public Works Engineering
100 Third St. Castle Rock, CO, 80104
(303) 660-7490
Engineering@douglas.co.us


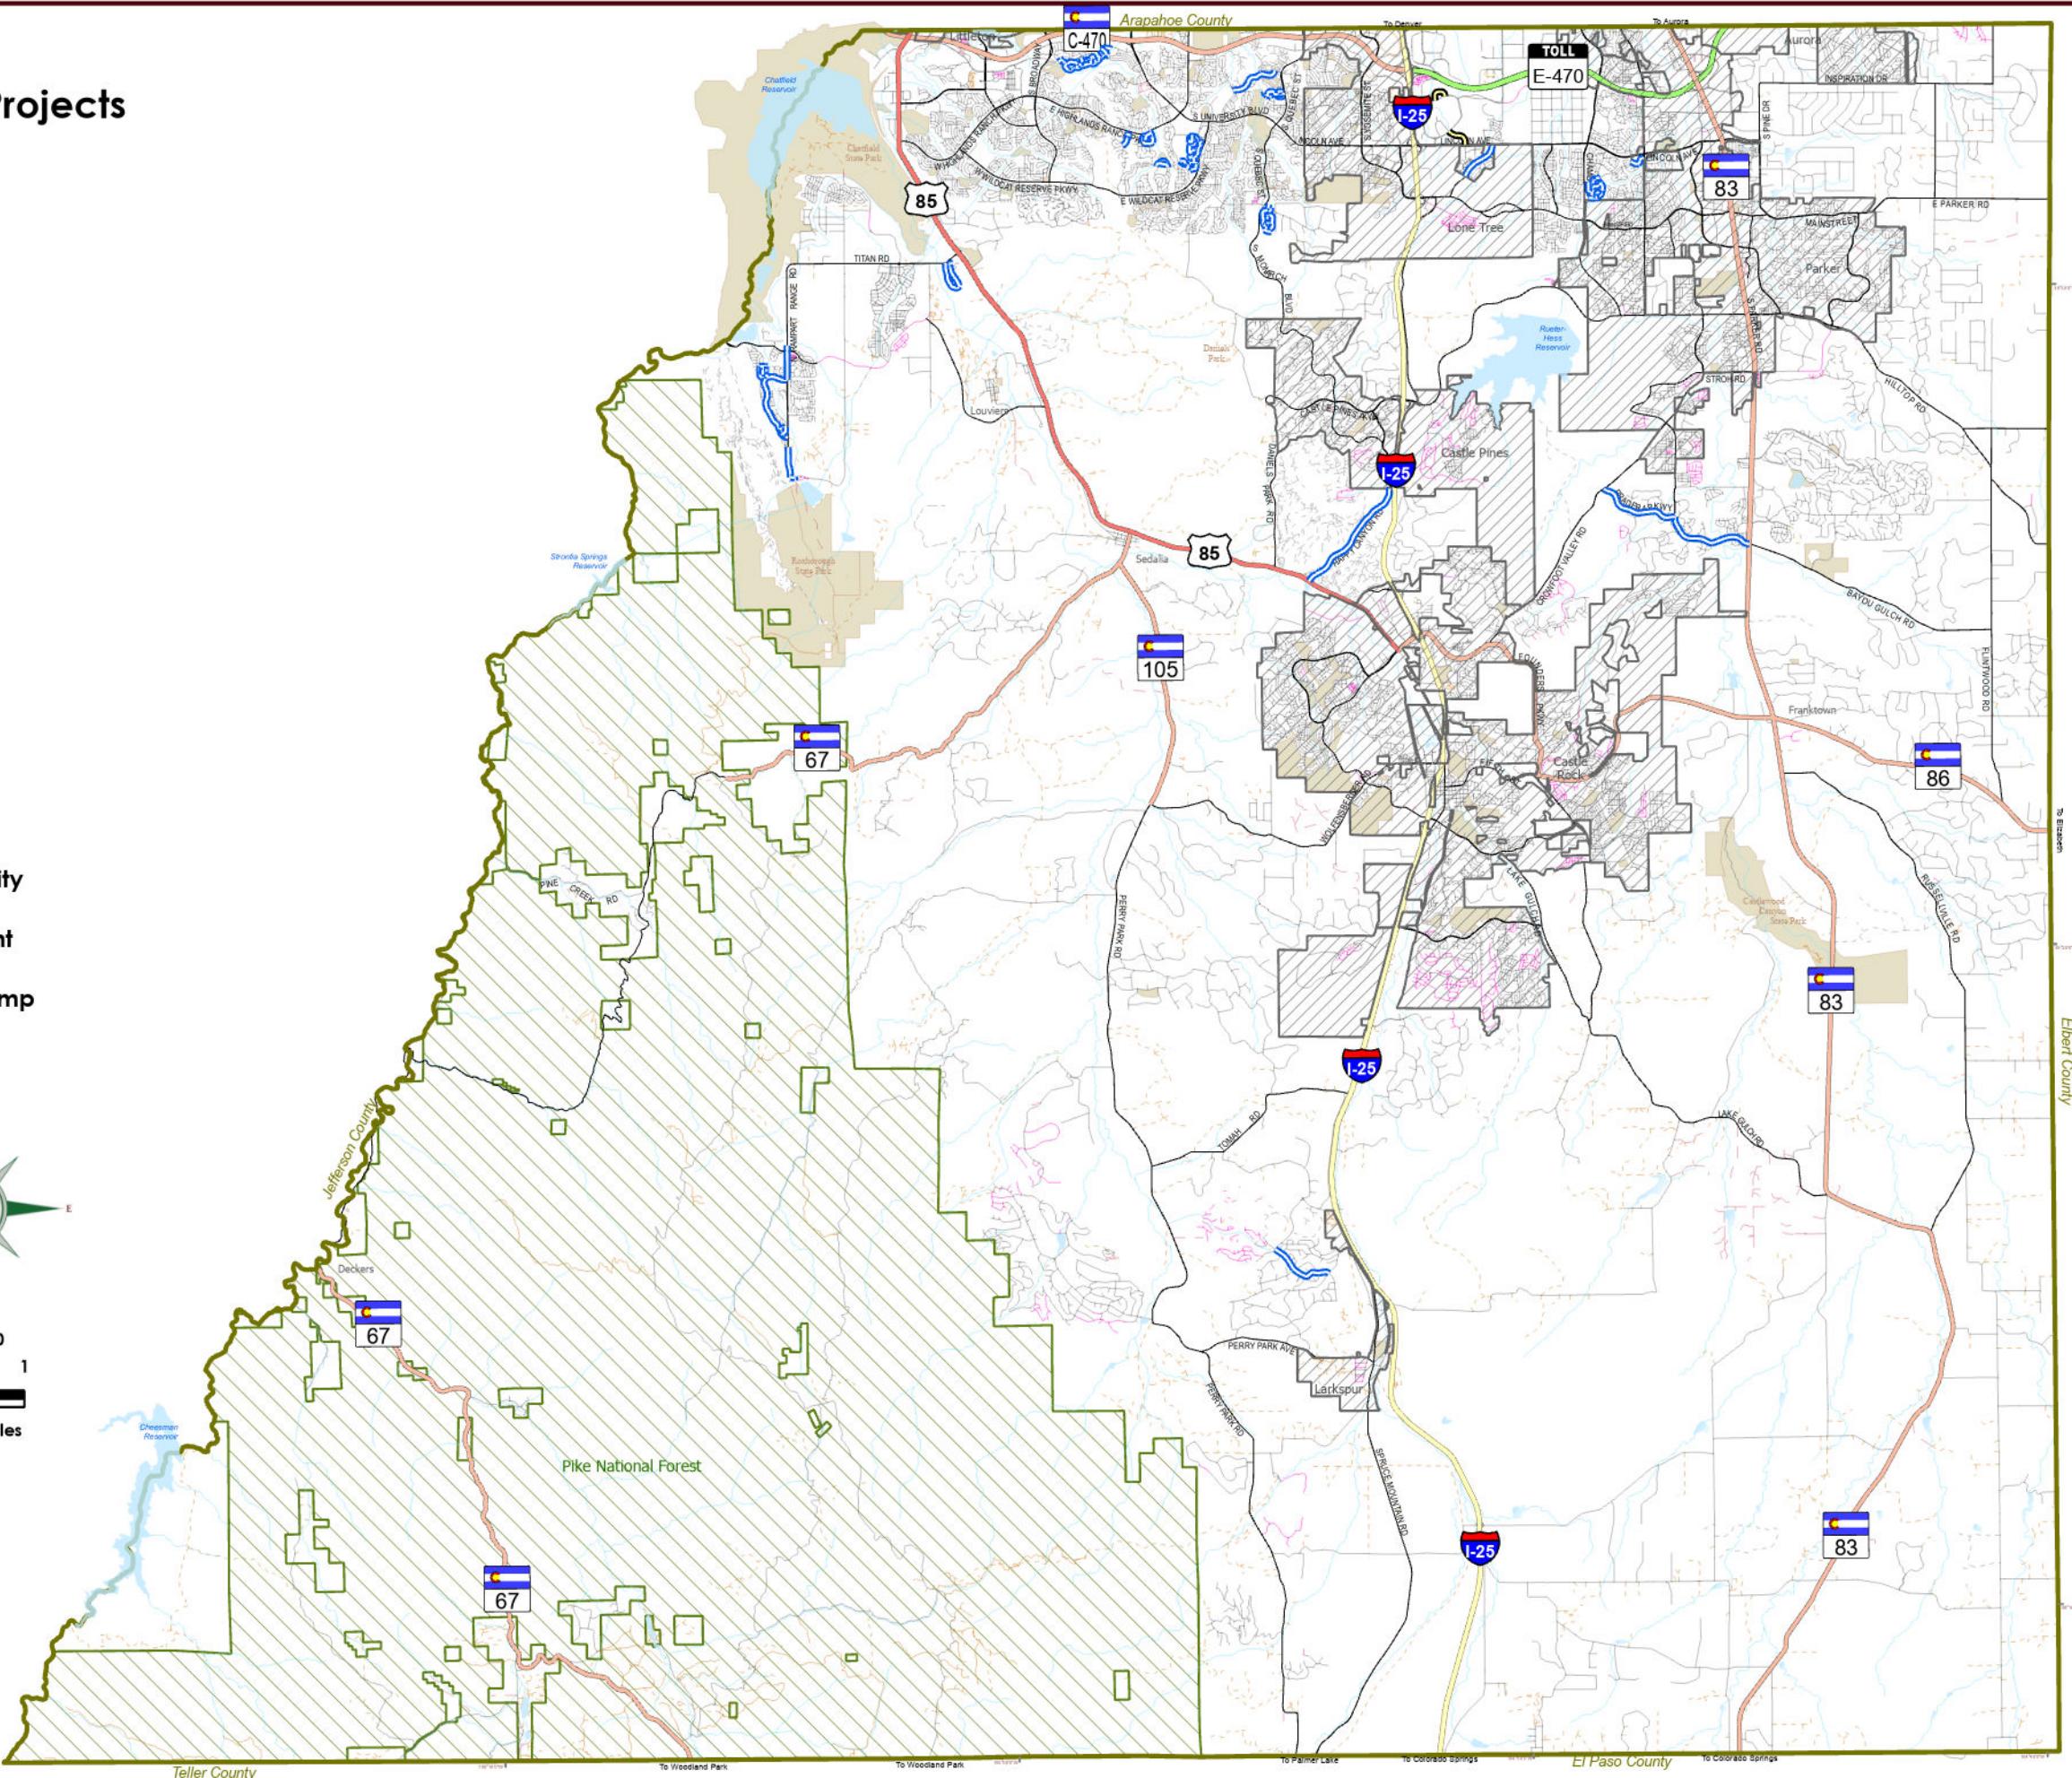


**As Built
2017 Contract Maintenance Projects
Douglas County, Colorado**

- HMA Overlay
- County Boundary
- Municipalities
- Parks
- Streams
- Roads
- US Highway
- State Highway
- Major Road
- Local Road
- Private
- Platted Not Built
- Gated Community
- Access Easement
- Entrance/Exit Ramp

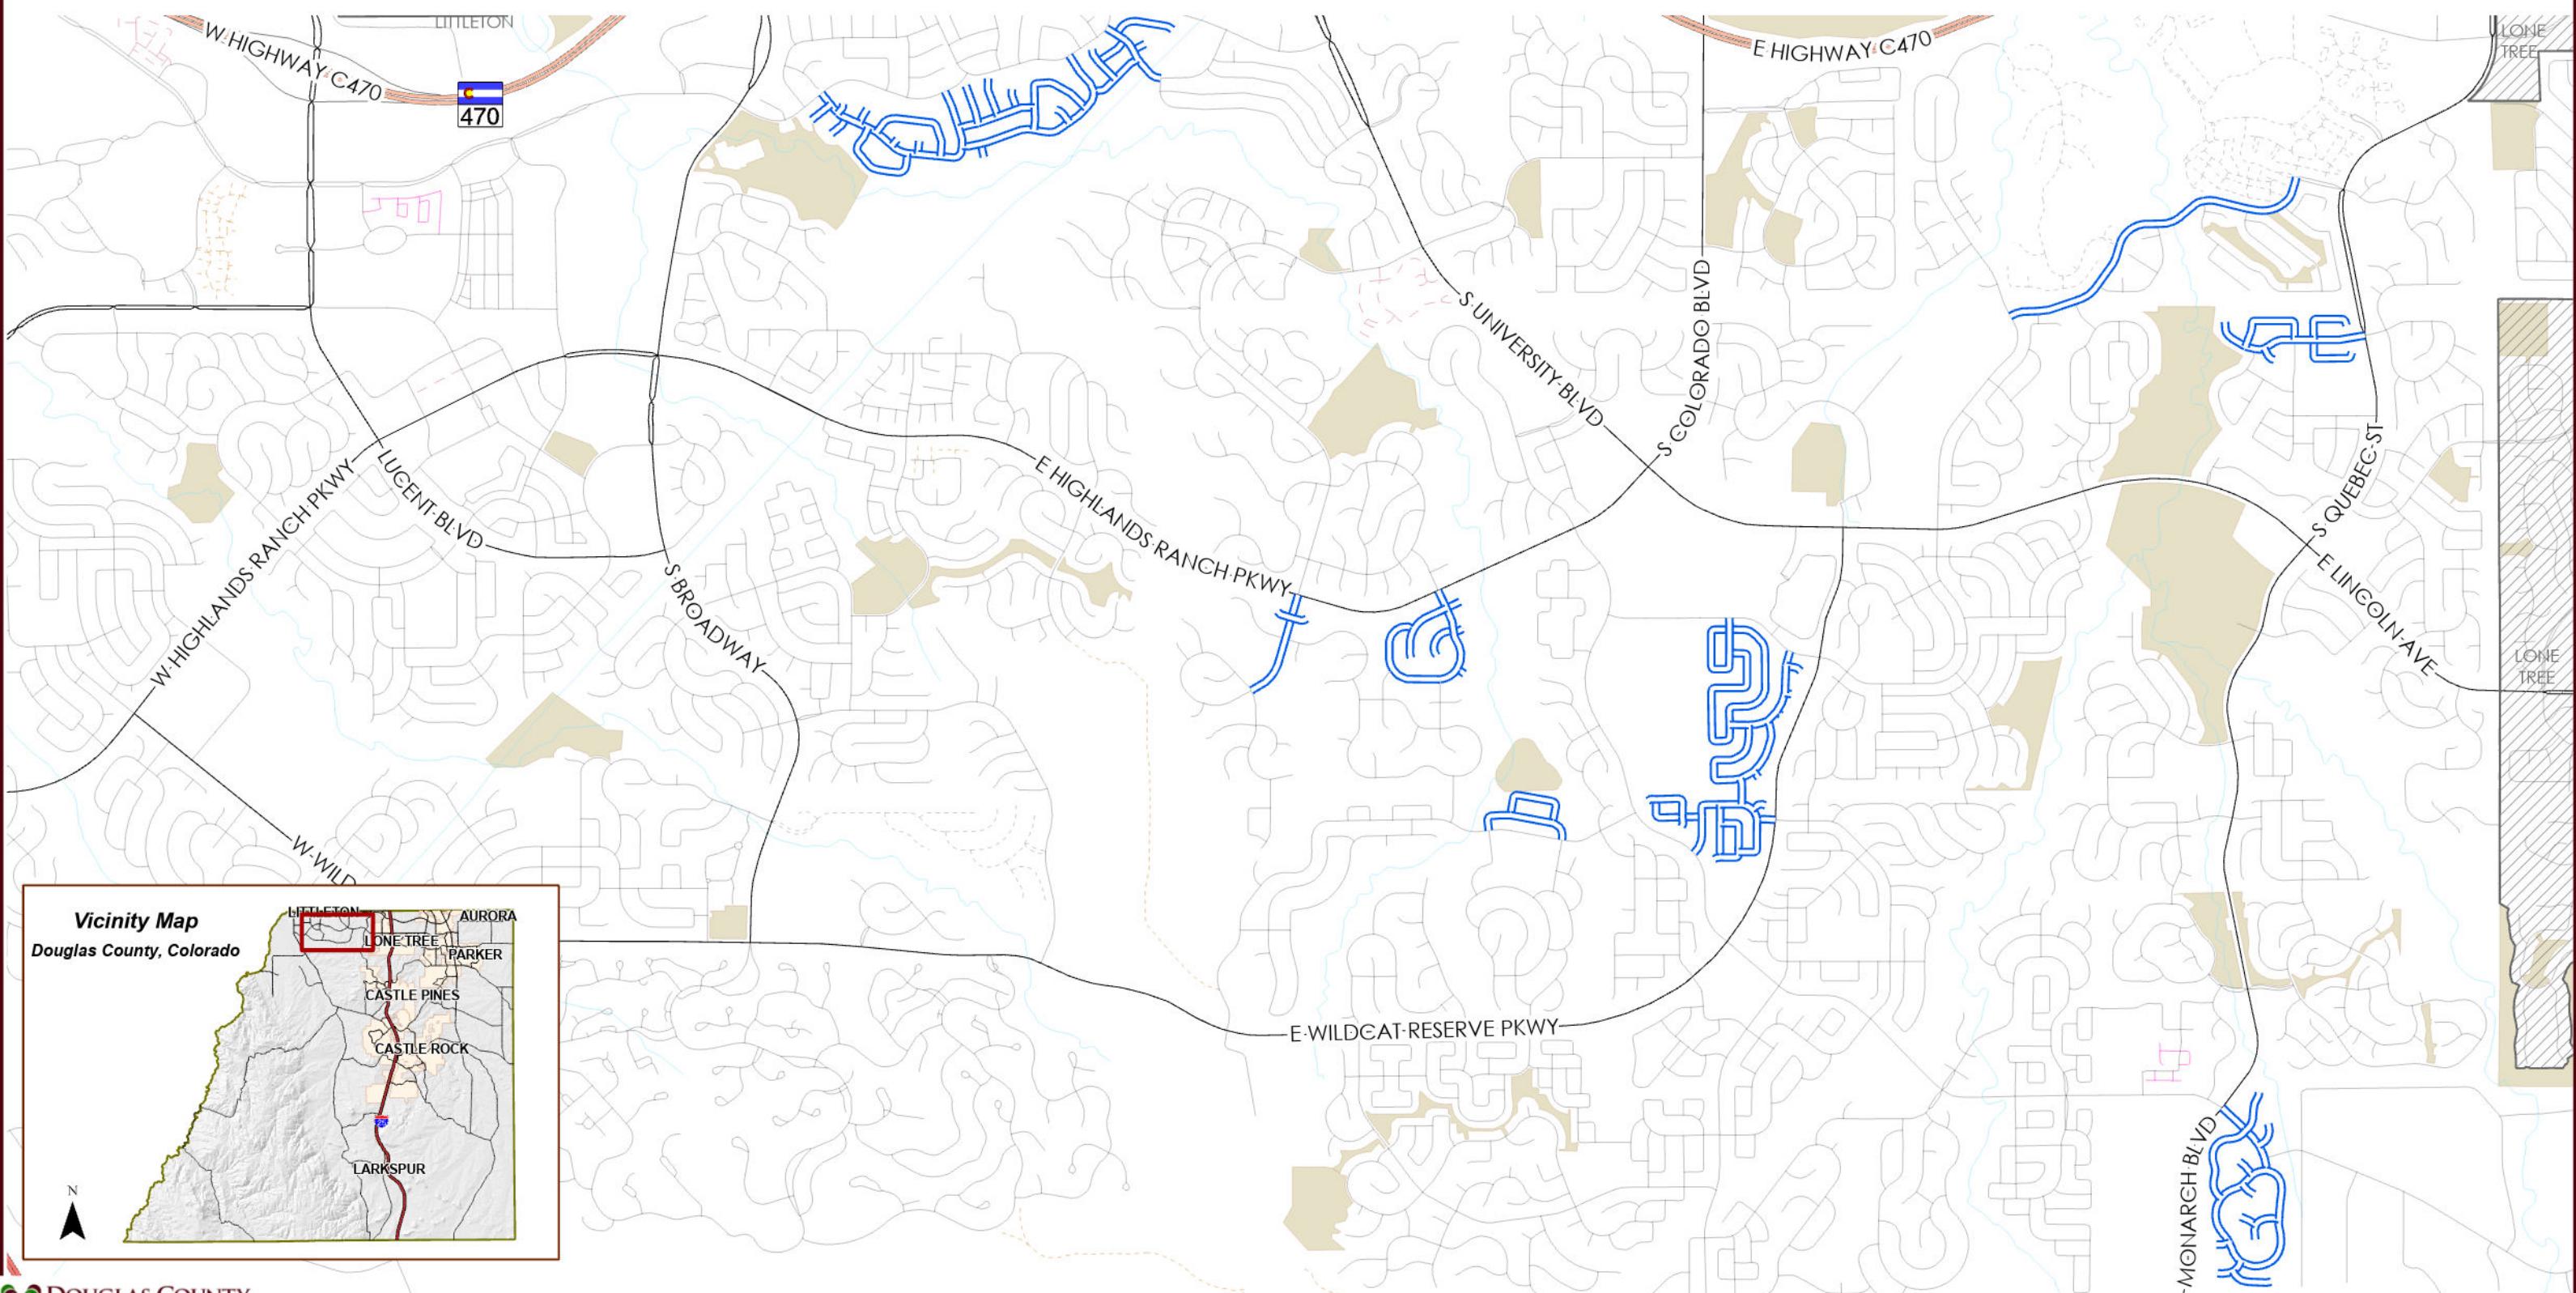
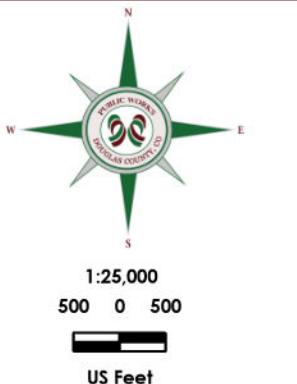


As Built 2017 Contract Maintenance Projects Douglas County, Colorado

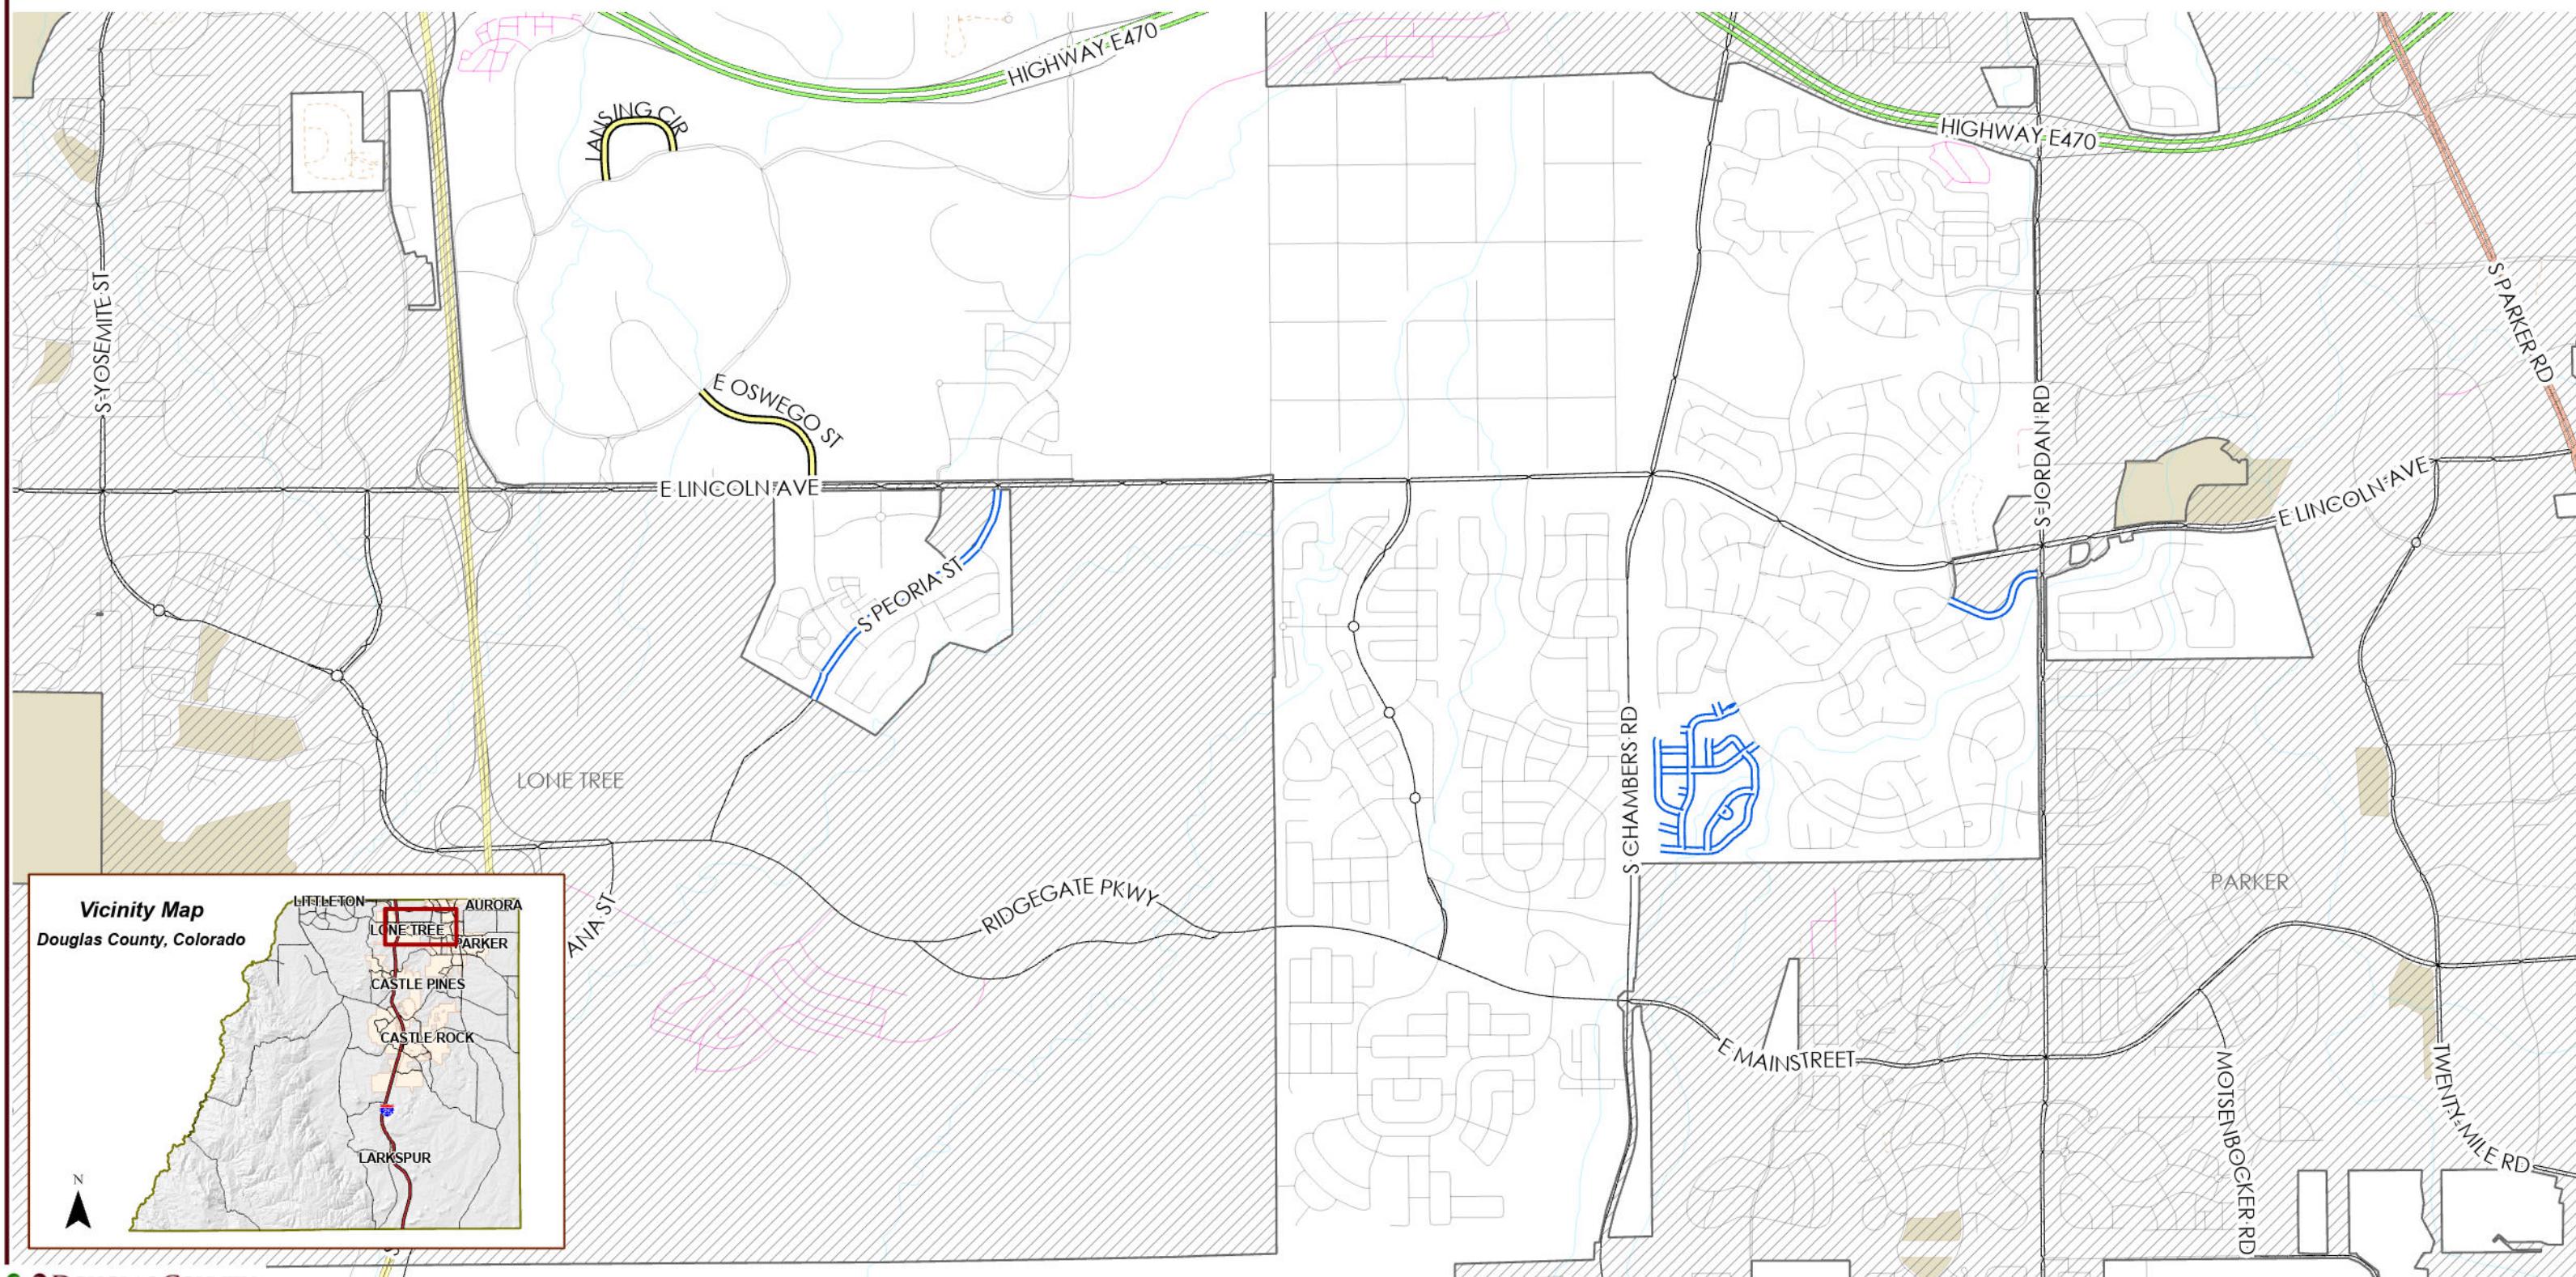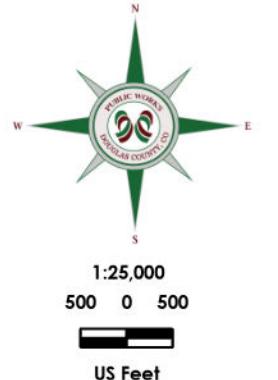



**As Built
2017 Contract Maintenance Projects
Douglas County, Colorado**

- HMA Overlay
- County Boundary
- Municipalities
- Parks
- Lakes
- Streams
- Major Road
- Local Road
- Interstate
- US Highway
- State Highway
- Roads
- Private
- Platted Not Built
- Gated Community
- Access Easement
- Entrance/Exit Ramp

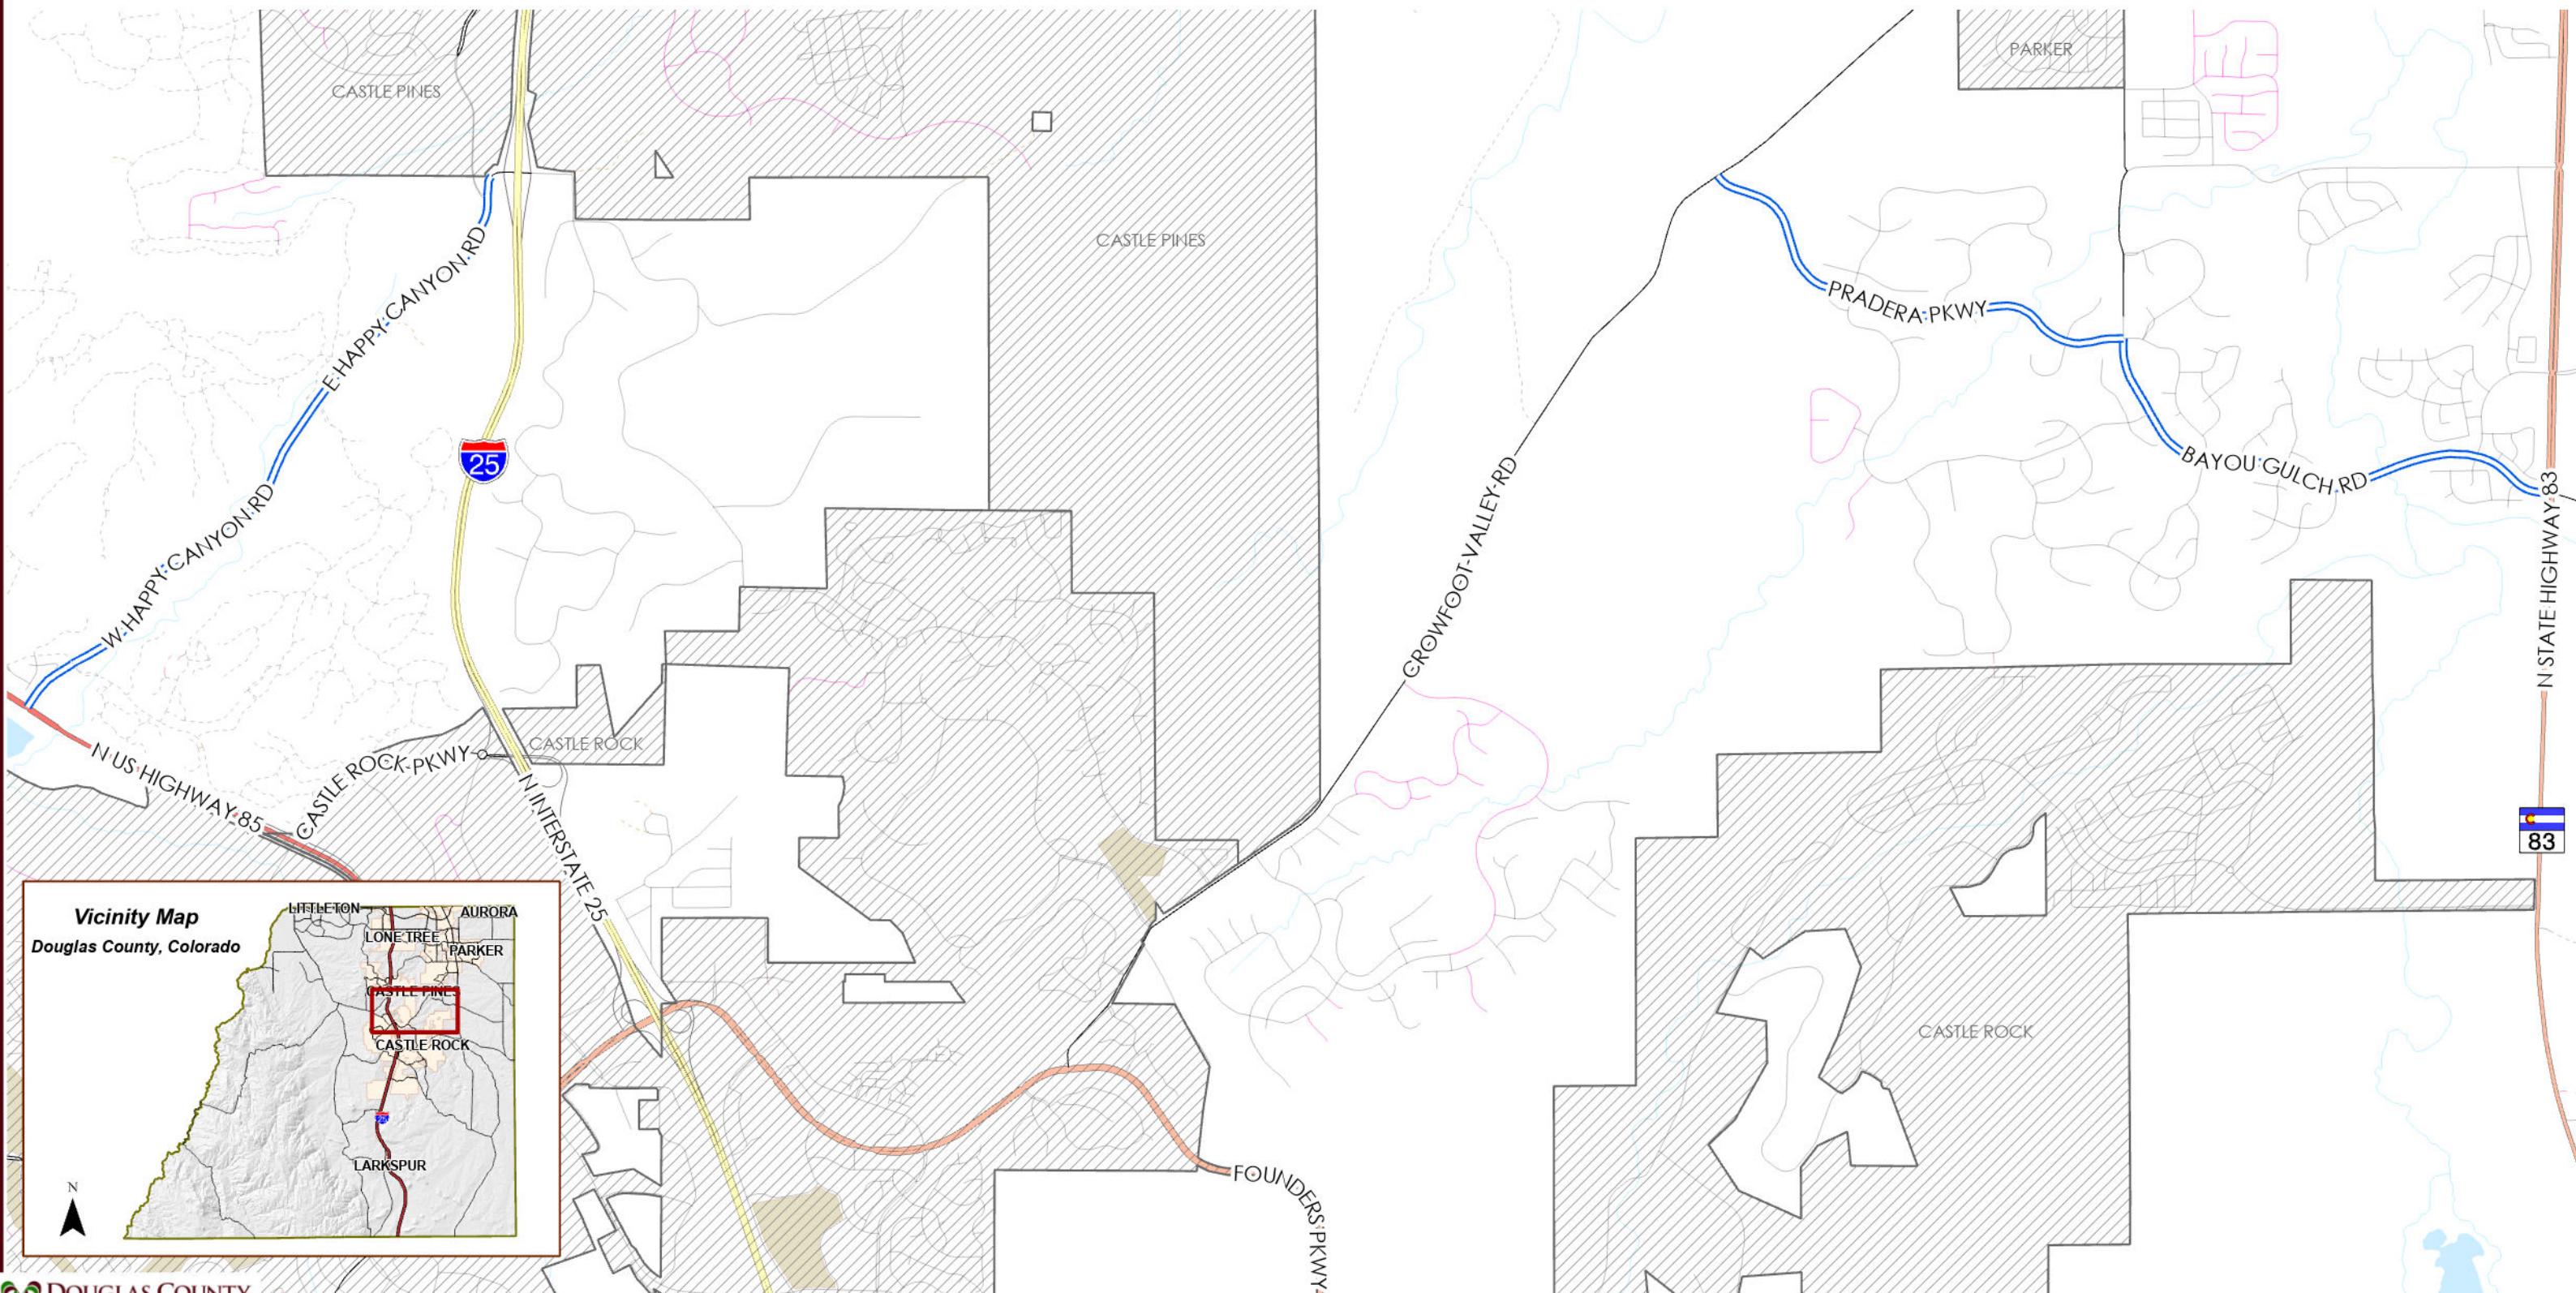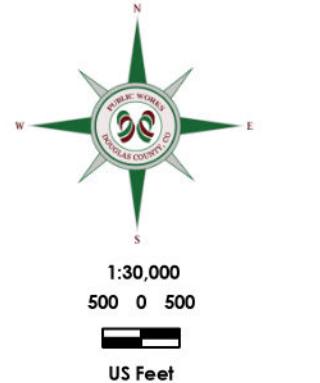

**As Built
2017 Contract Maintenance Projects
Douglas County, Colorado**

- HMA Overlay
- County Boundary
- Municipalities
- Parks
- Lakes
- Roads
- Streams
- Private
- Platted Not Built
- Interstate
- Major Road
- Local Road
- Gated Community
- Access Easement
- Entrance/Exit Ramp

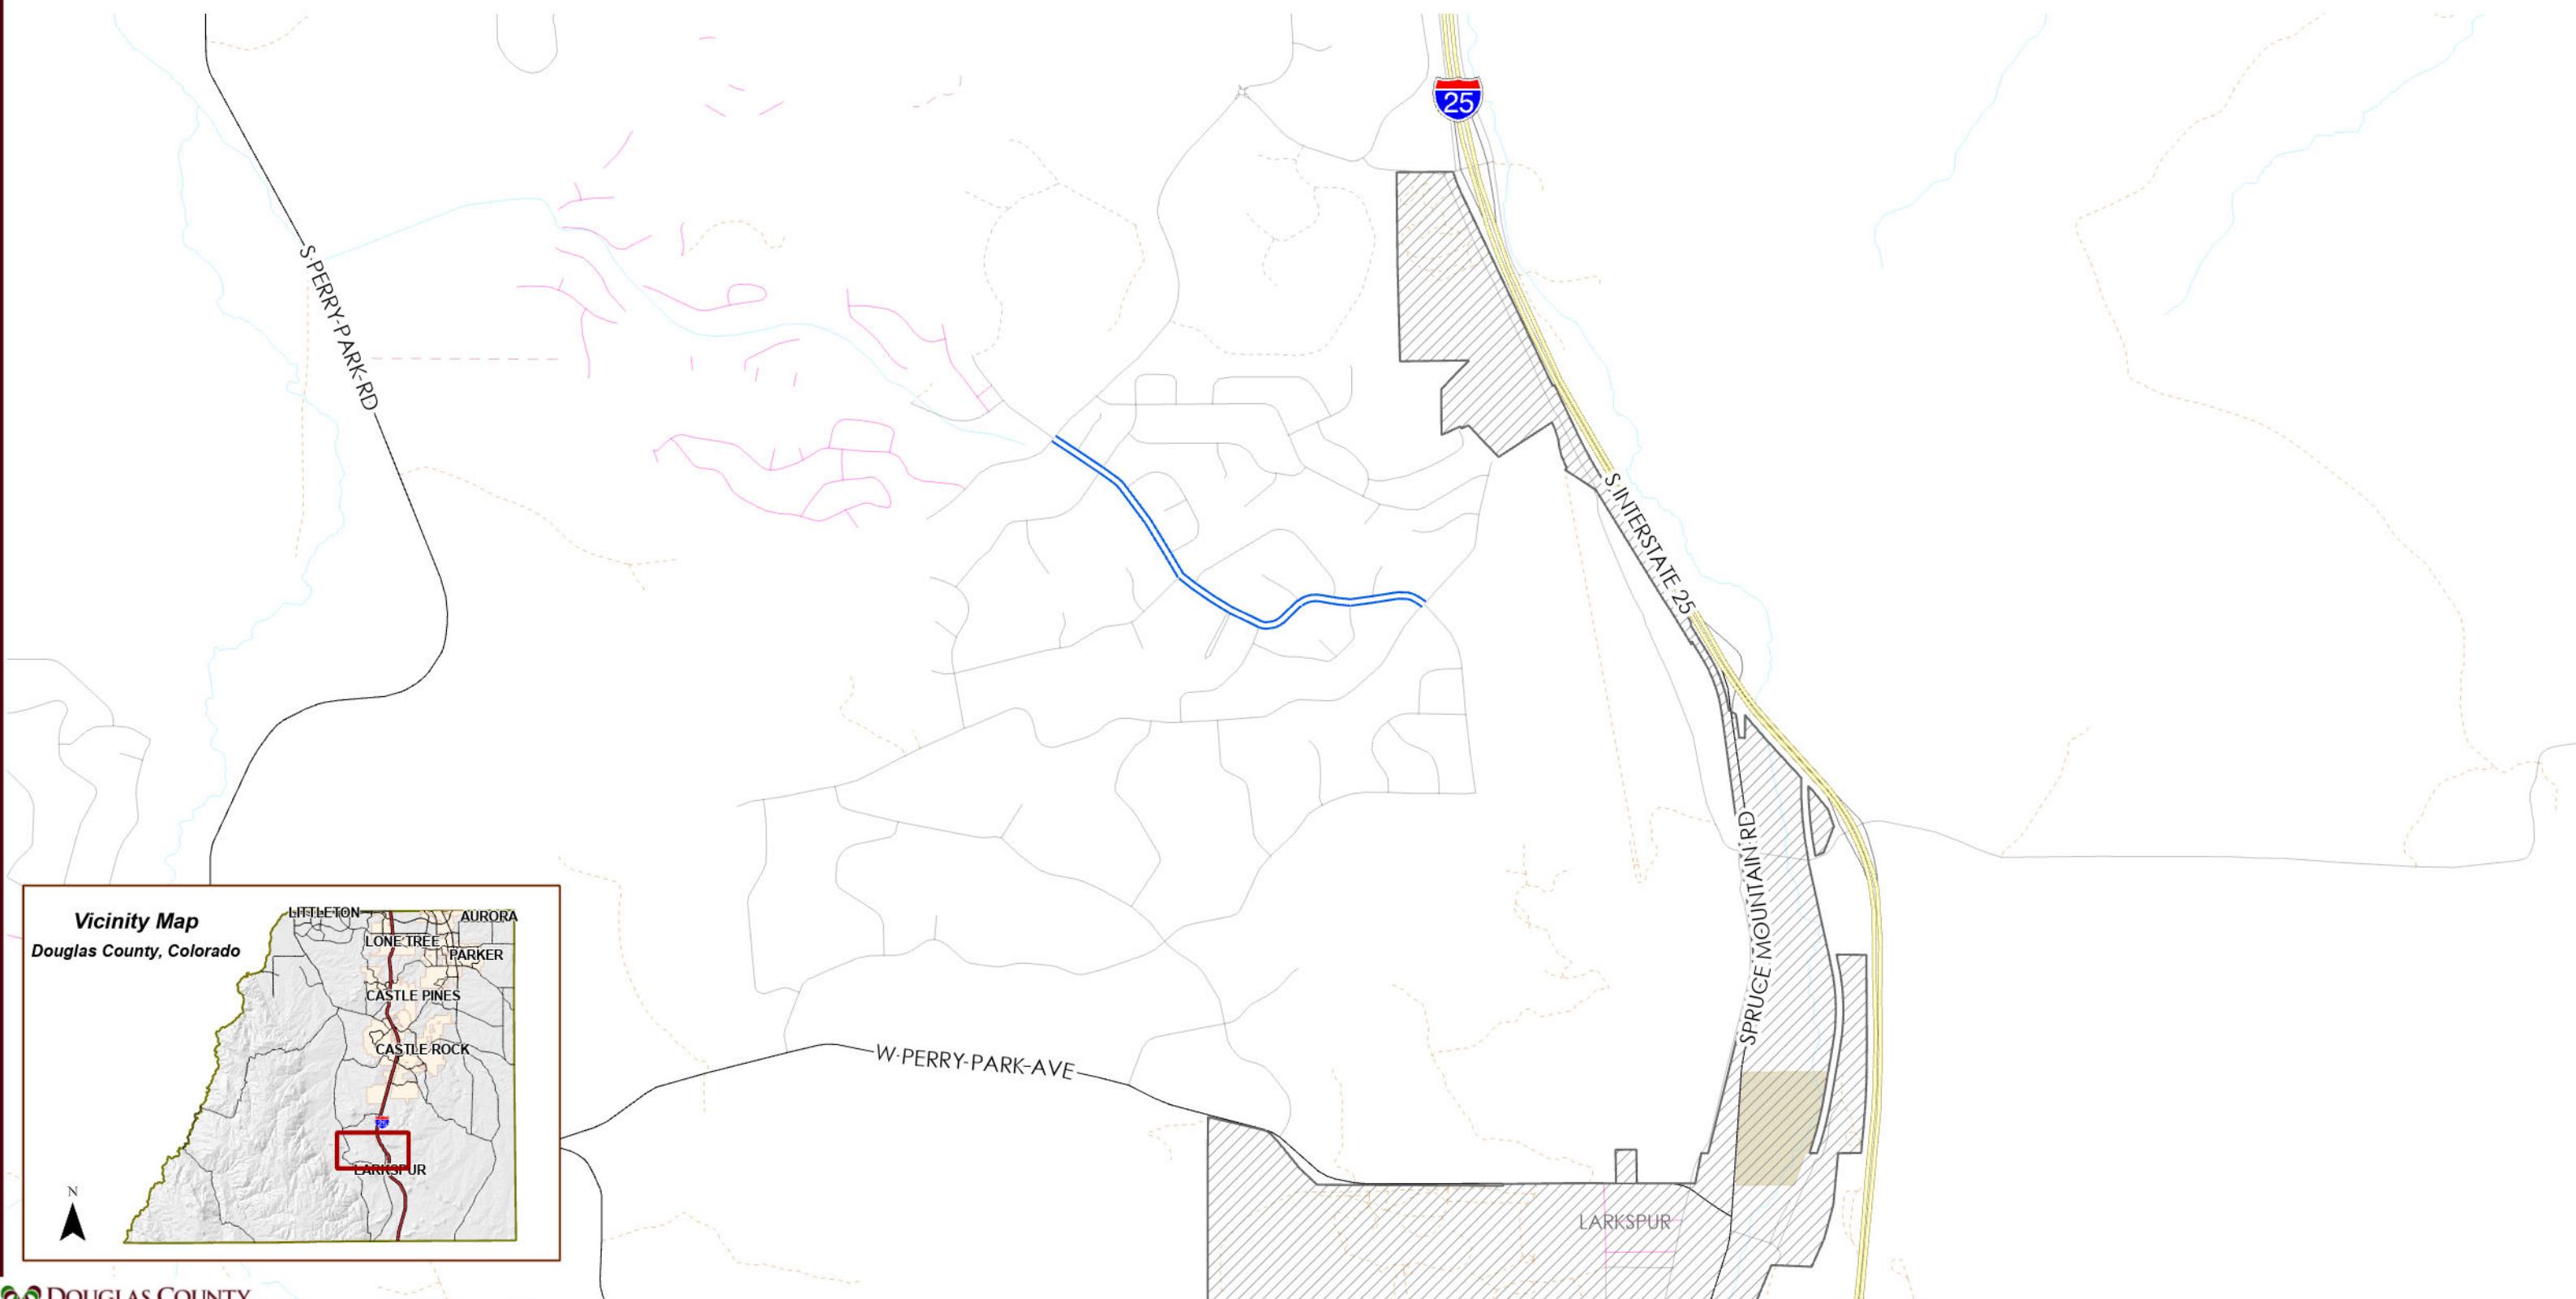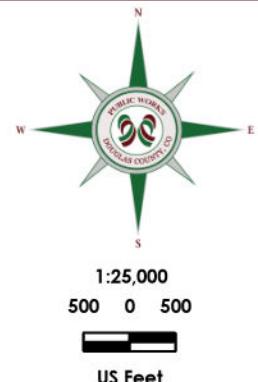

**As Built
2017 Contract Maintenance Projects
Douglas County, Colorado**

- HMA Overlay
- County Boundary
- Parks
- \ Pike National Forest
- Lakes
- Roads
- Streams
- Major Road
- Local Road
- Platted Not Built
- US Highway
- Gated Community
- Access Easement
- Entrance/Exit Ramp

