

# As Built 2018 Contract Maintenance Projects Douglas County, Colorado

Roads	
HMA Overlay	Interstate
Asphalt Full Depth	US Highway
Concrete	State Highway
County Boundary	Toll Highway
Municipalities	Major Road
Parks	Local Road
Pike National Forest	Private
Lakes	Forest Road
Intermittent Lakes	Platted Not Built
Streams	Gated Community
	Access Easement
	Entrance/Exit Ramp



1:190,000


1 0 1

Scale in Miles




Douglas County Public Works Department: GIS Disclaimer

All GIS data and information products provided by the Douglas County Public Works Department are for illustrative purposes only. While products are considered to be accurate when provided, Douglas County does not warrant that they are error free. Douglas County Public Works Department shall not be liable for direct, indirect, incidental, or consequential damages arising from the use of such products. The recipient, and/or user, acknowledges and agrees that the use of such products is at their sole risk. Questions concerning this or any other product provided by Douglas County Public Works Department, including errors, corrections and/or updates should be directed to:




Douglas County Public Works Engineering  
100 Third St. Castle Rock, CO, 80104  
(303) 660-7490  
Engineering@douglas.co.us

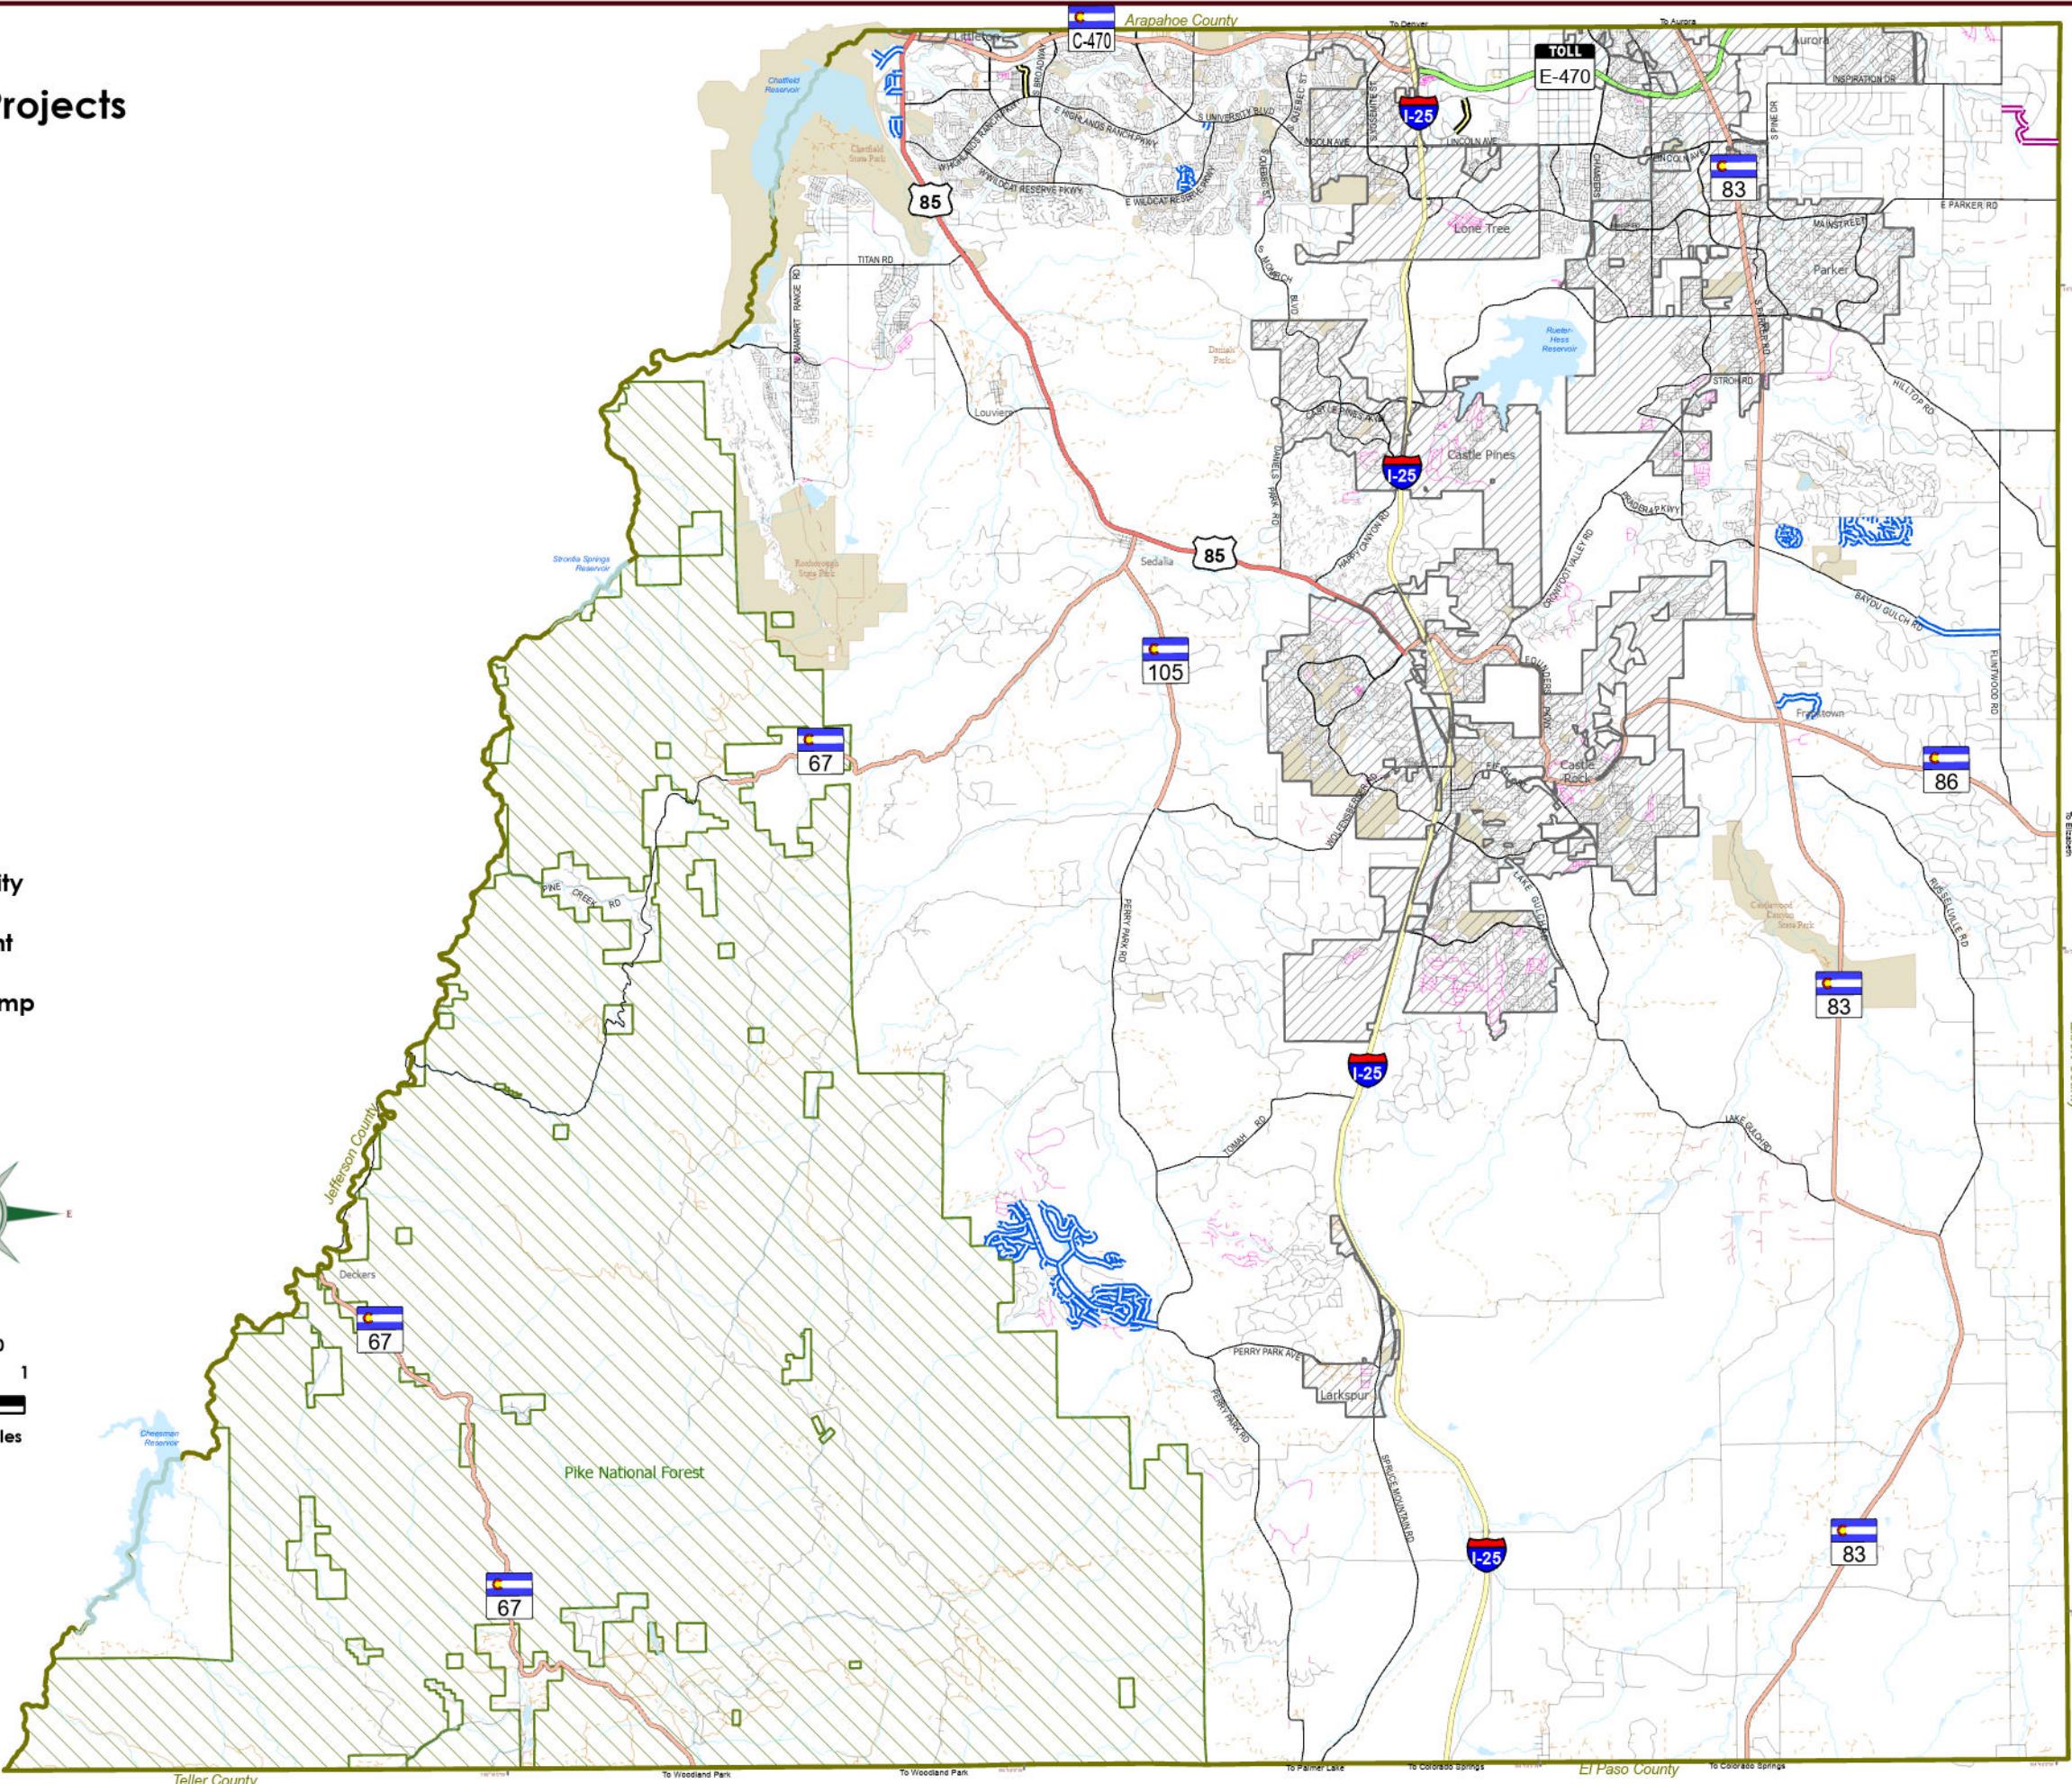

# As Built 2018 Contract Maintenance Projects Douglas County, Colorado

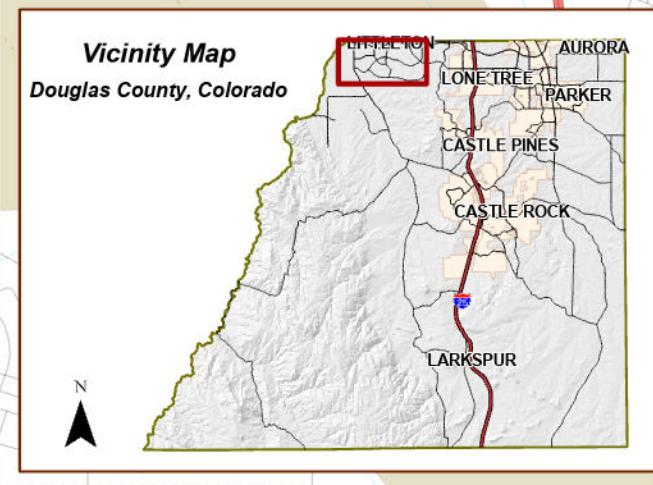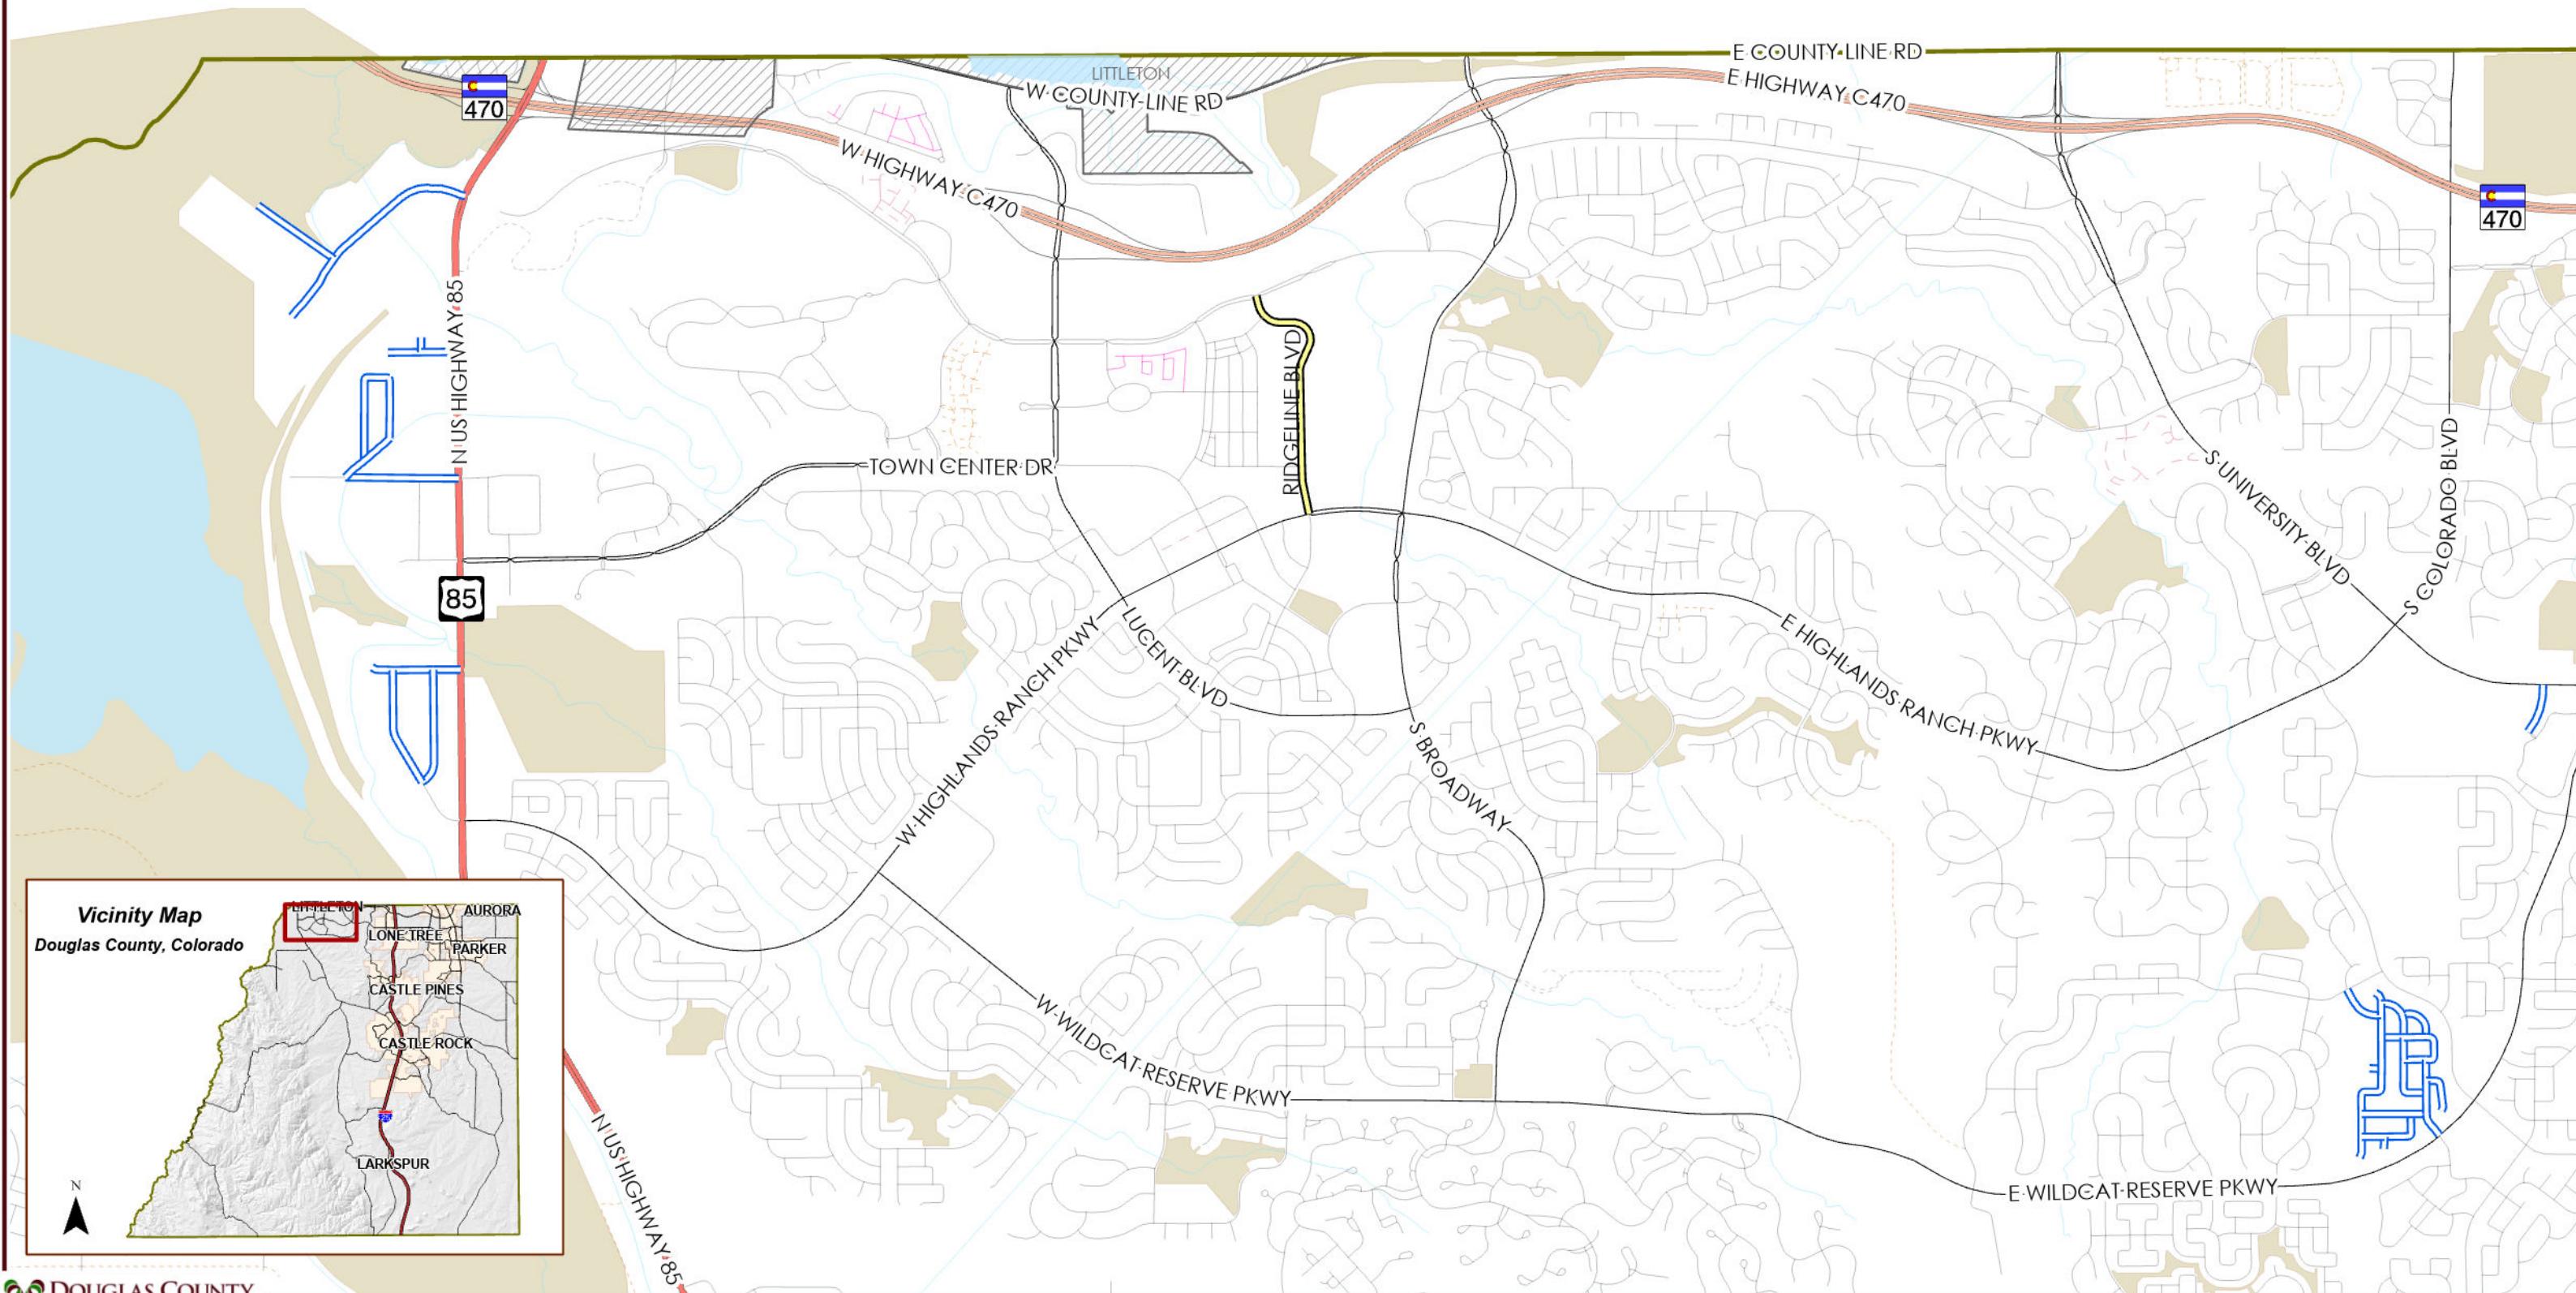
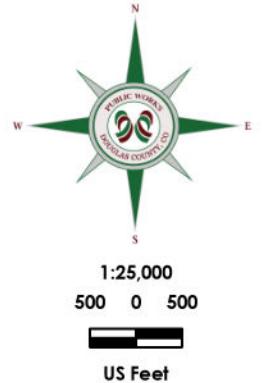


# As Built 2018 Contract Maintenance Projects Douglas County, Colorado

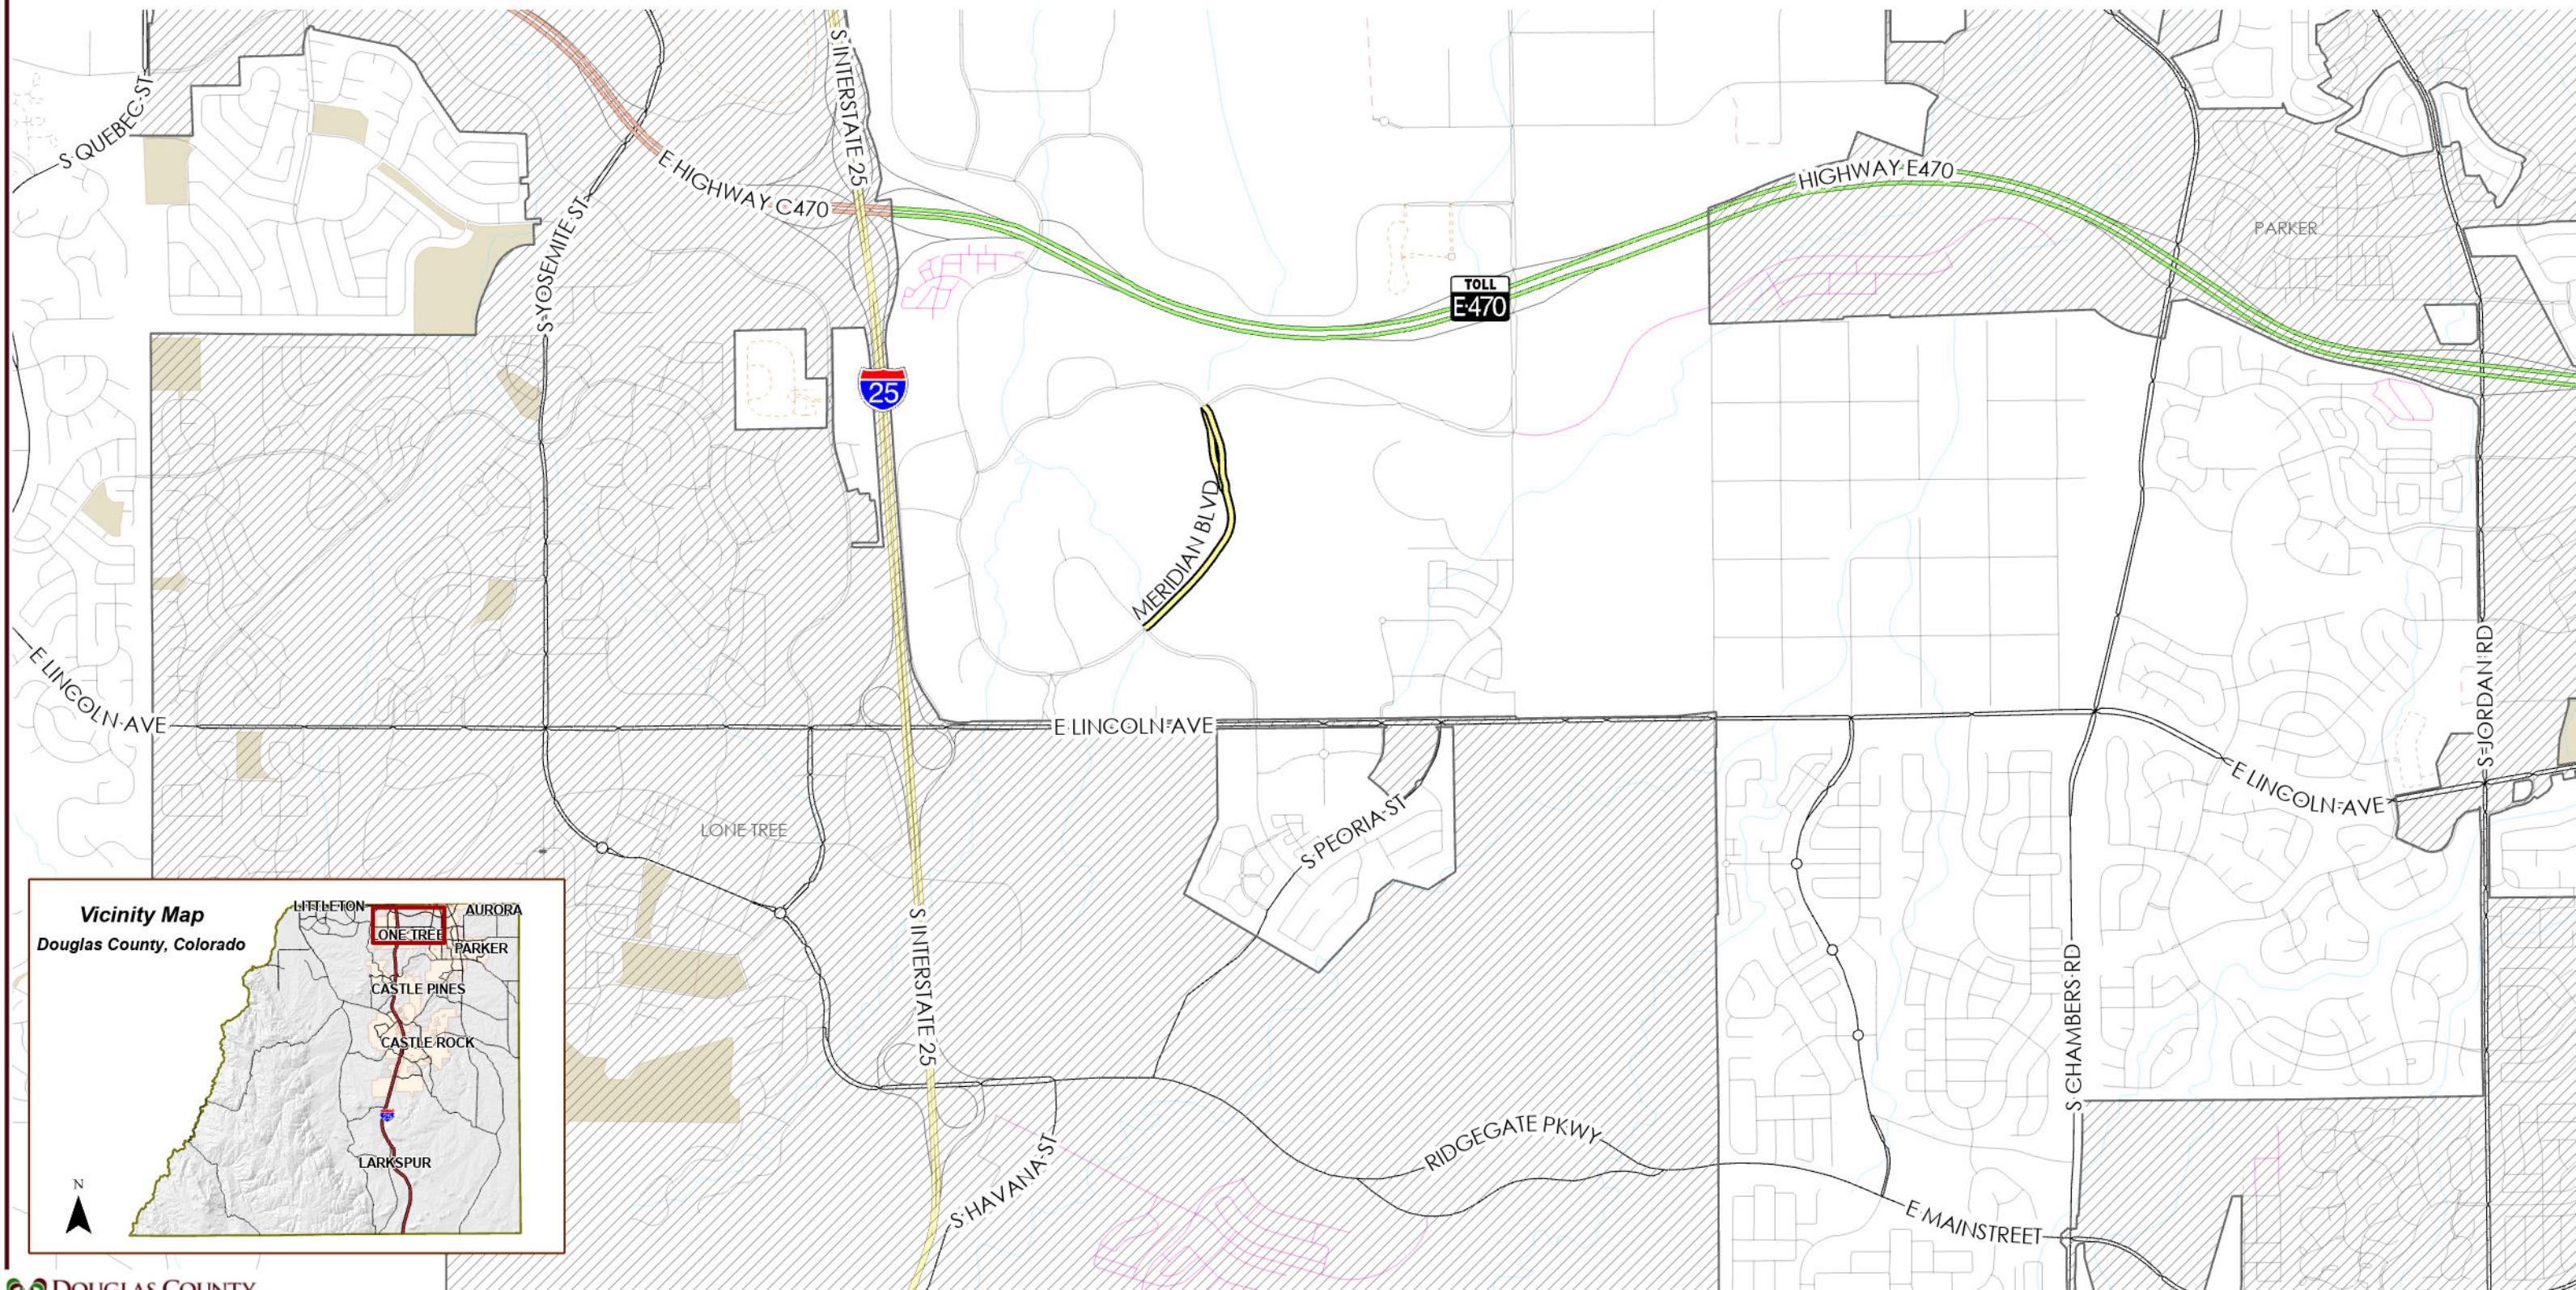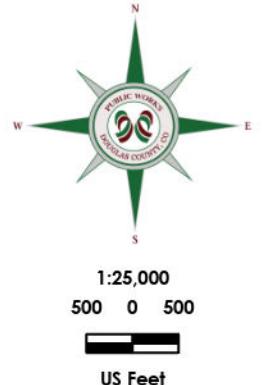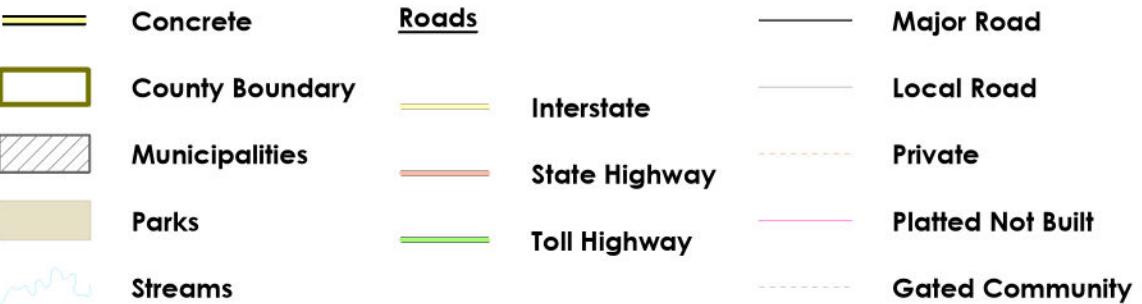



**As Built  
2018 Contract Maintenance Projects  
Douglas County, Colorado**

- Asphalt Full Depth
- County Boundary
- Municipalities
- Parks
- Intermittent Lakes
- Streams
- Roads
- Major Road
- Local Road
- State Highway
- Toll Highway
- Access Easement
- Entrance/Exit Ramp
- Private
- Platted Not Built
- Gated Community

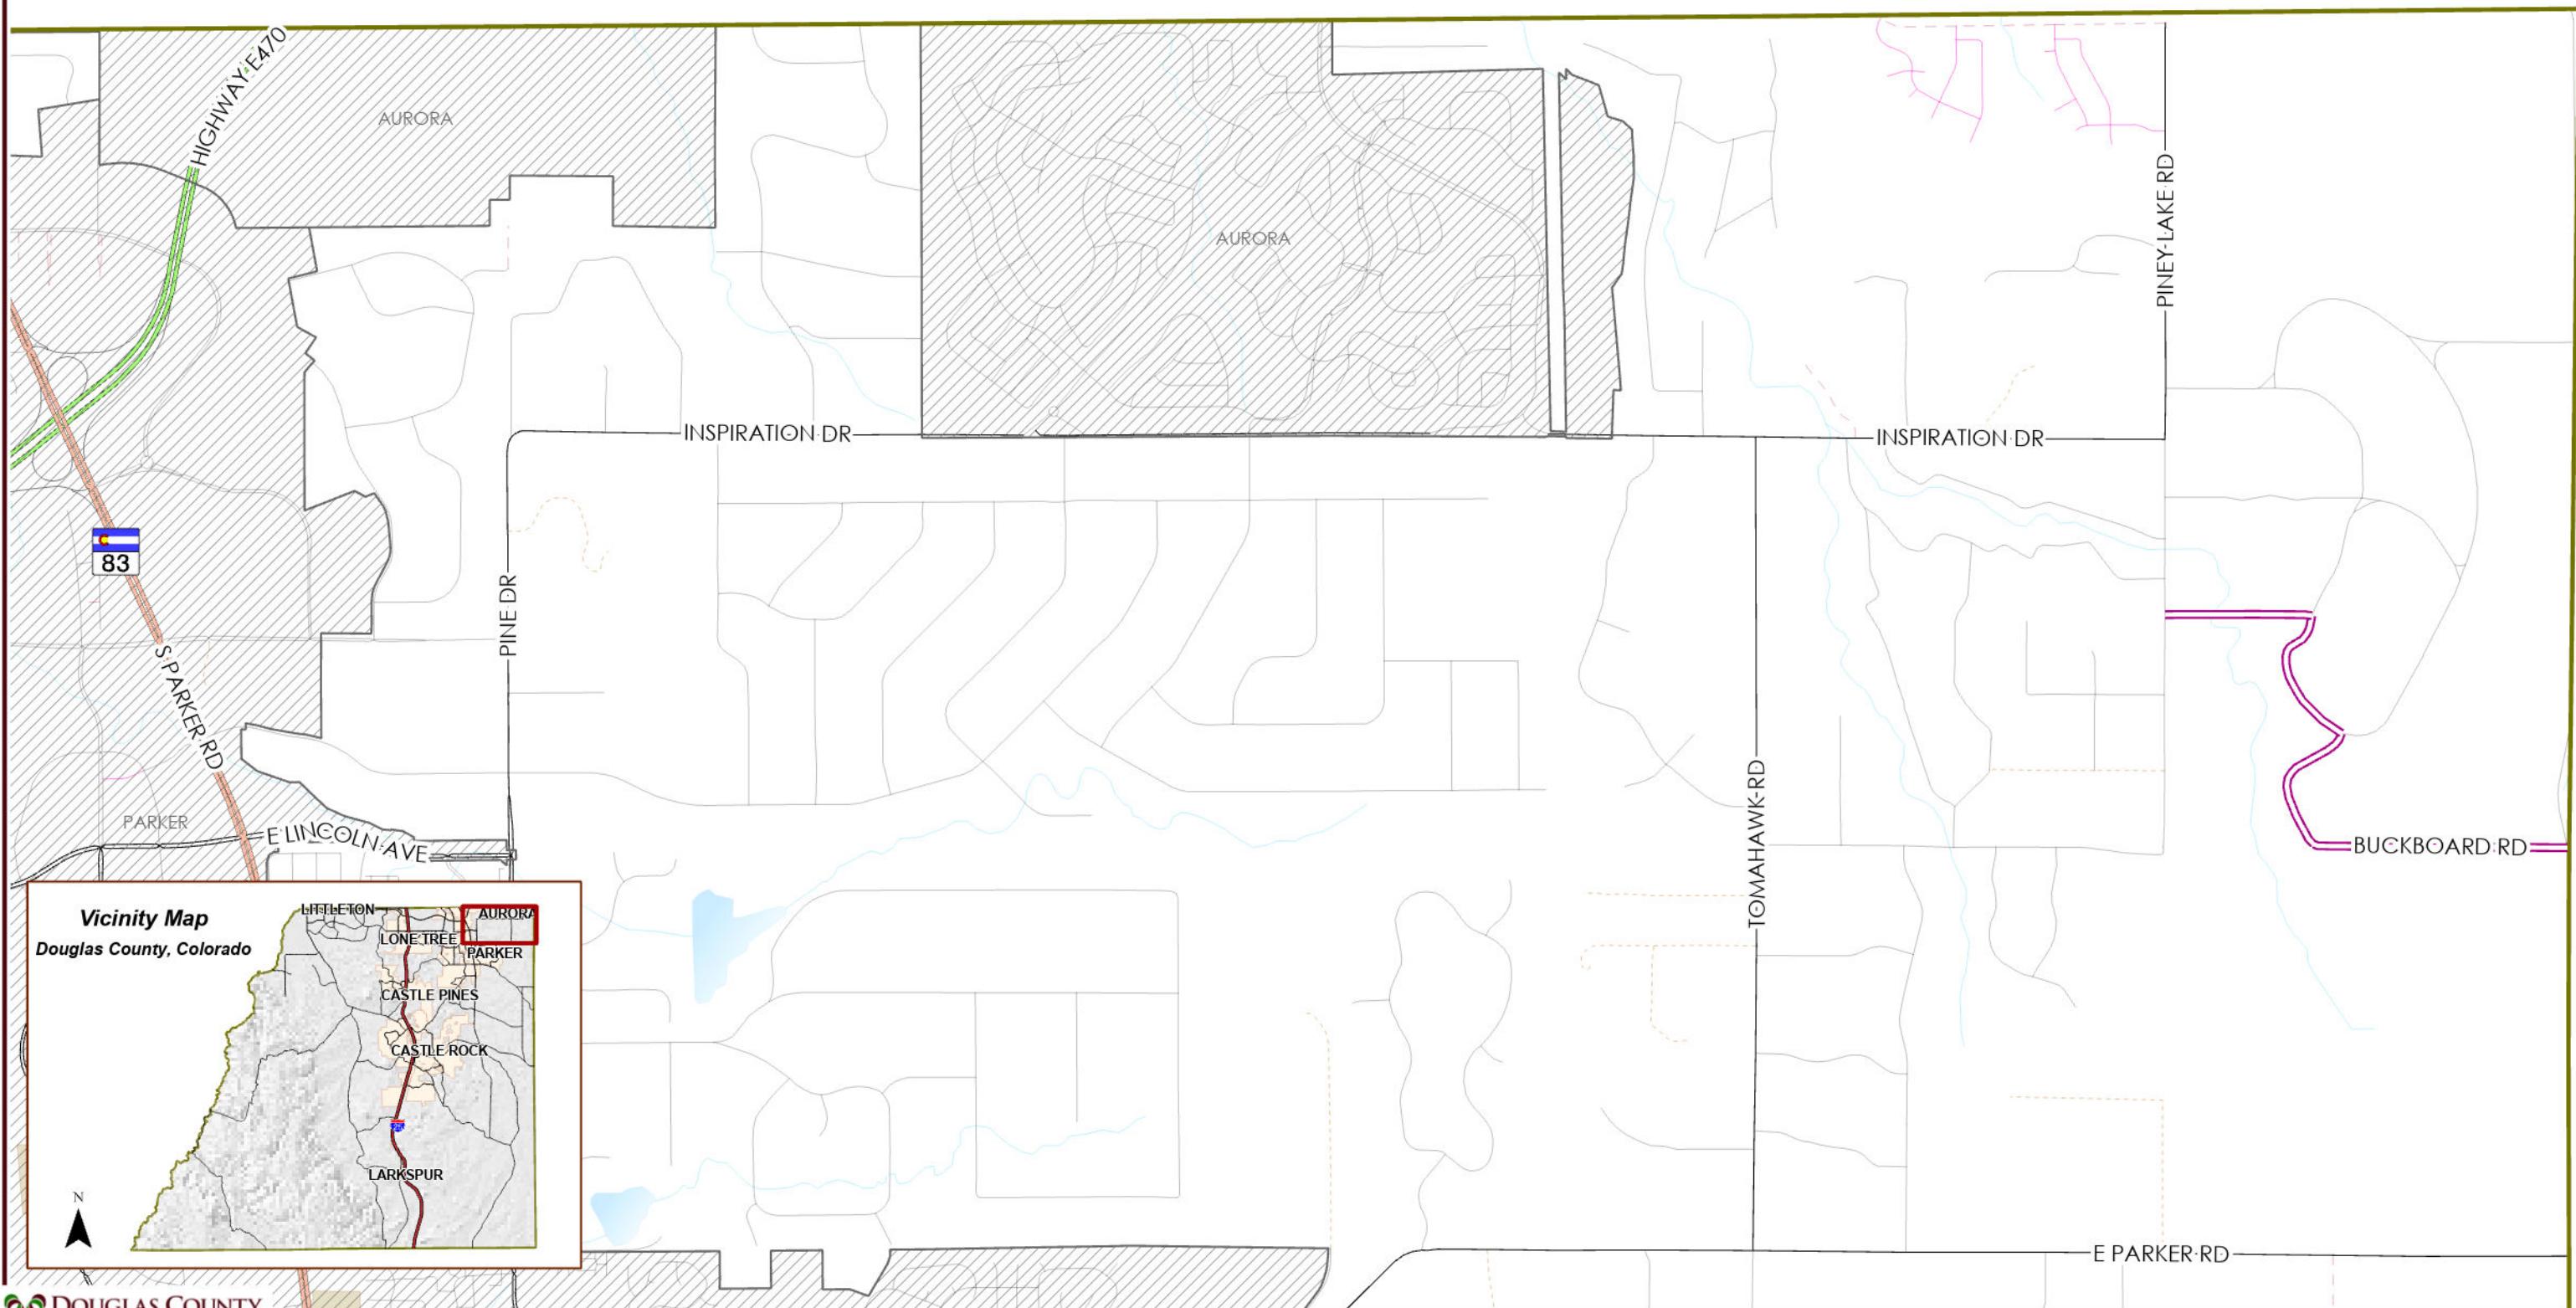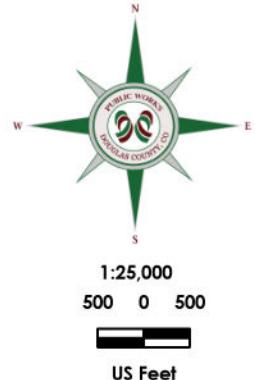

**As Built  
2018 Contract Maintenance Projects  
Douglas County, Colorado**

	HMA Overlay		Intermittent Lakes		Local Road
	County Boundary		Streams		Private
	Municipalities		Roads		Platted Not Built
	Parks		State Highway		Gated Community
	Lakes		Major Road		Access Easement

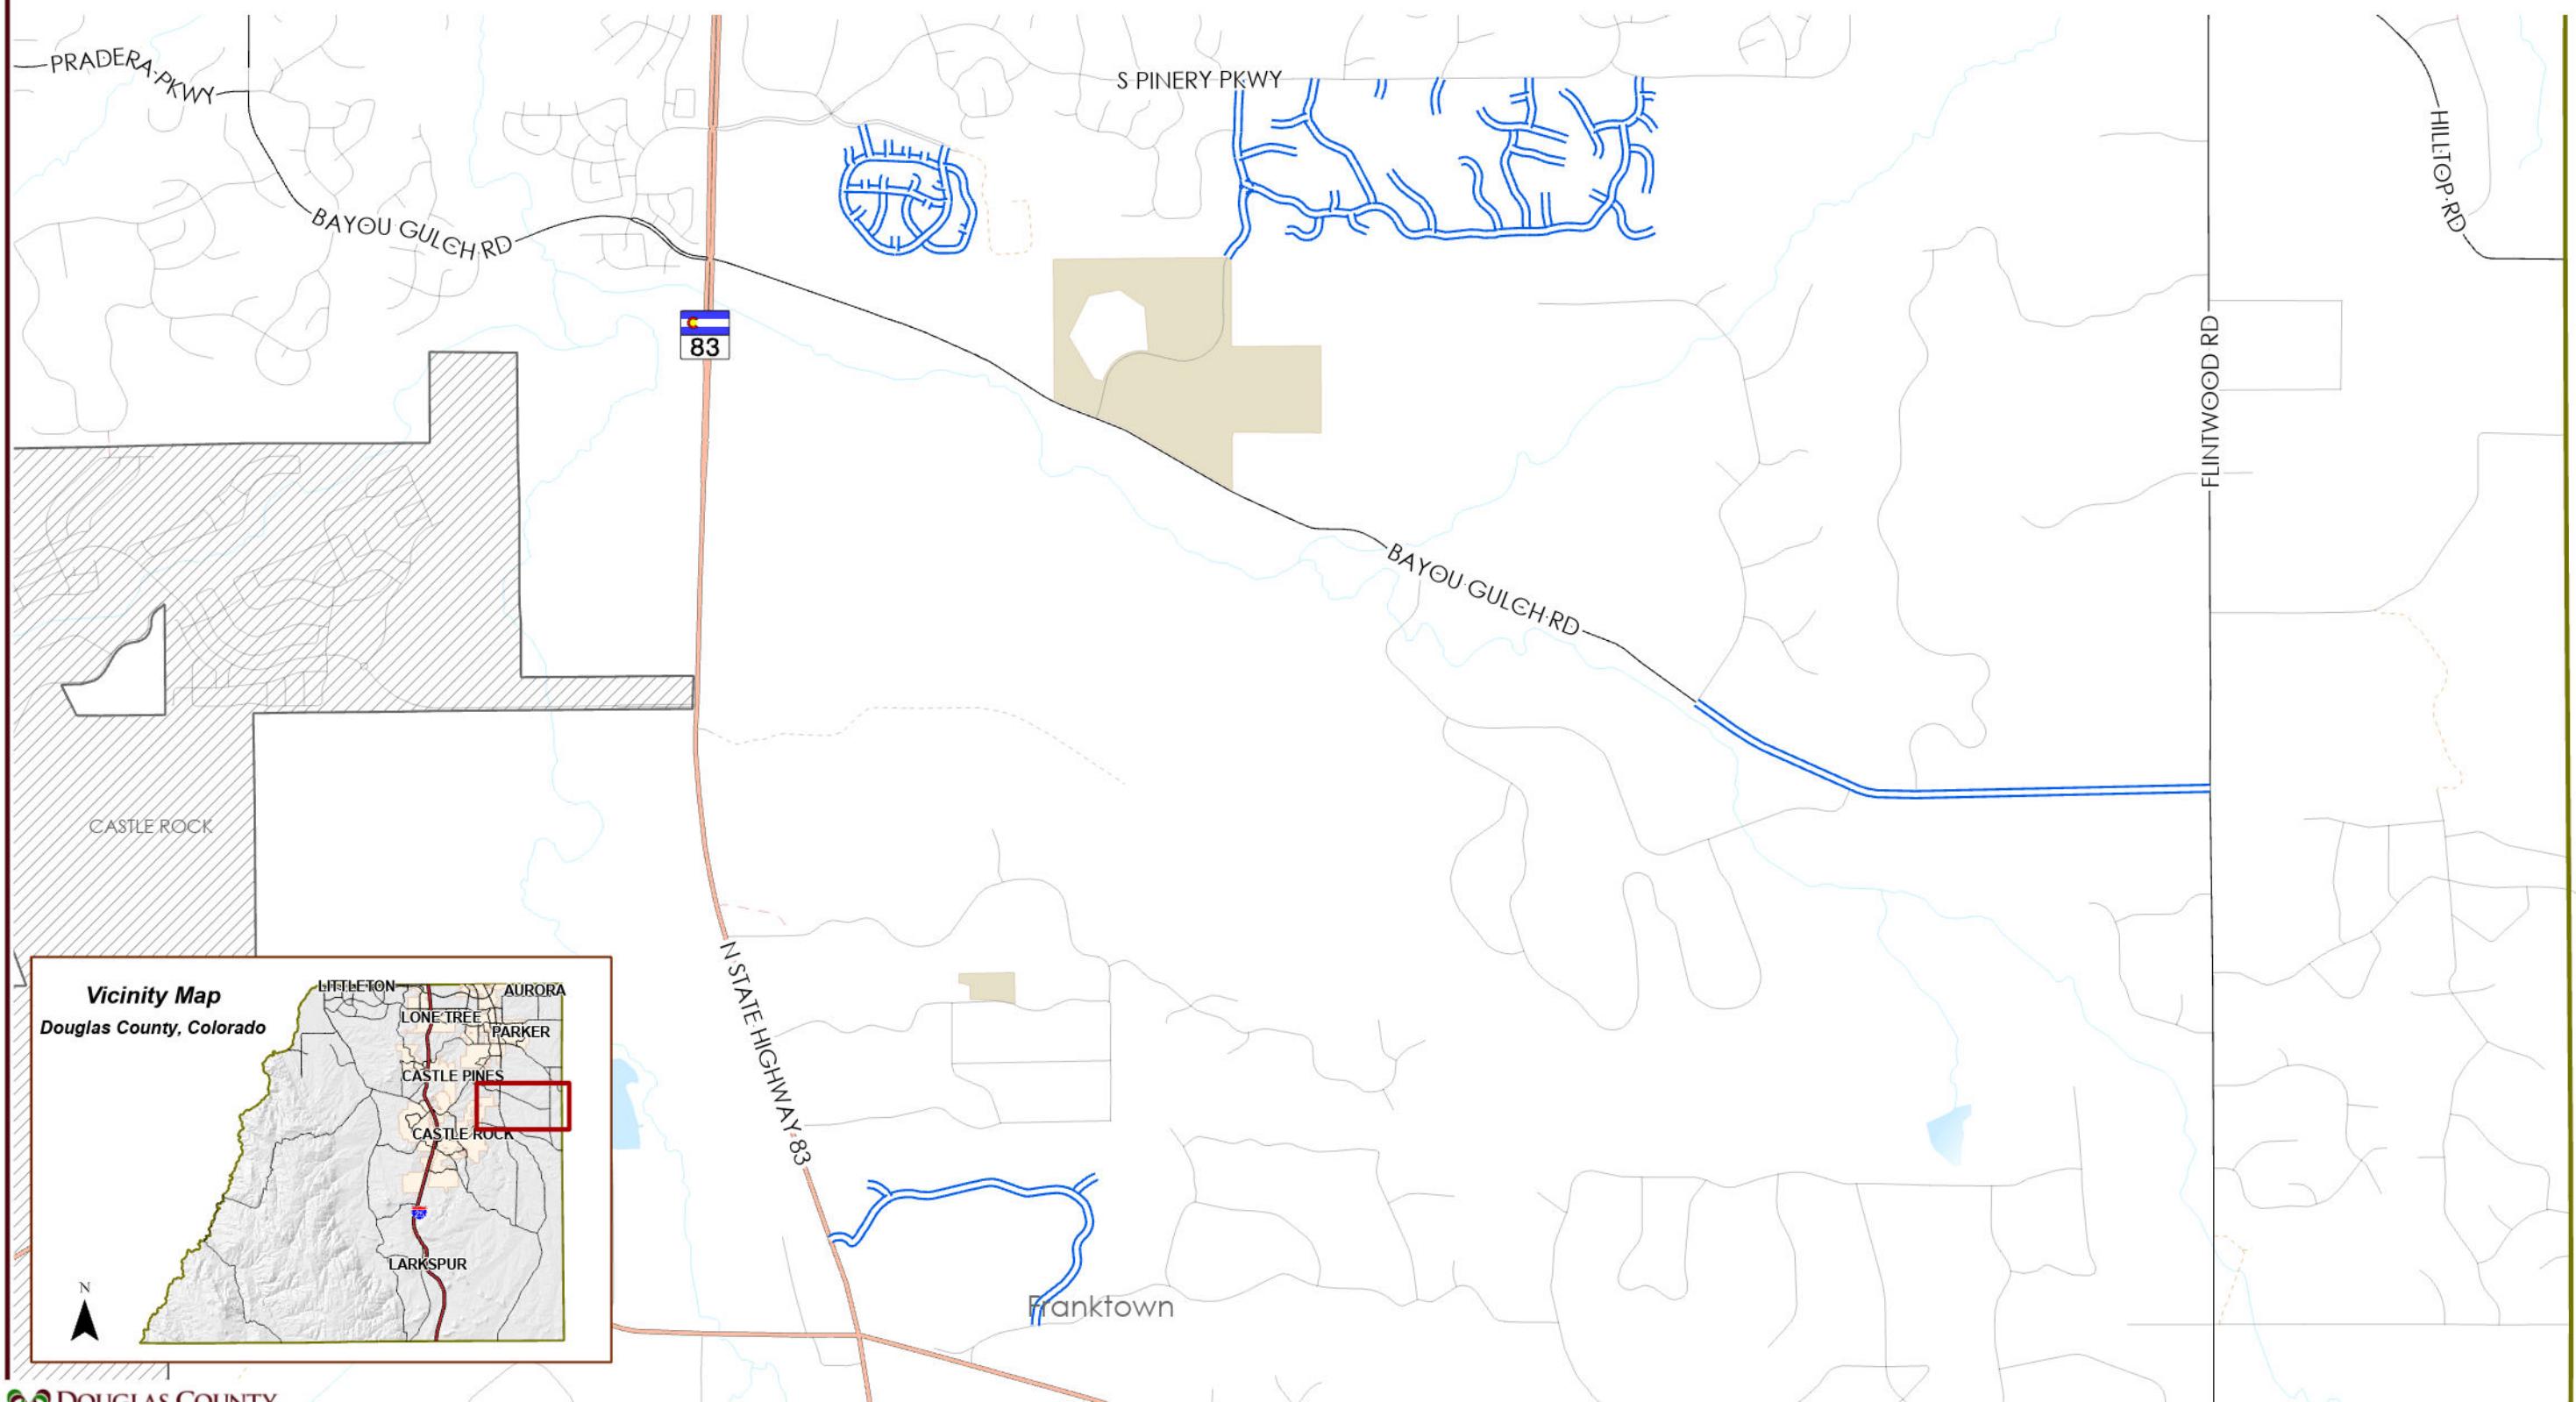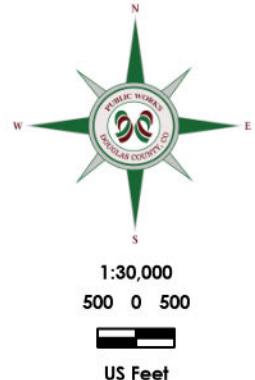

**As Built  
2018 Contract Maintenance Projects  
Douglas County, Colorado**

- HMA Overlay
- County Boundary
- Pike National Forest
- Lakes
- Streams
- Roads
- Major Road
- Local Road
- Platted Not Built
- Gated Community
- Access Easement
- Private

