

As Built 2019 Contract Maintenance Projects Douglas County, Colorado

Roads	
HMA Overlay	Interstate
Asphalt Full Depth	US Highway
Concrete	State Highway
County Boundary	Toll Highway
Municipalities	Major Road
Parks	Local Road
Pike National Forest	Private
Lakes	Forest Road
Intermittent Lakes	Platted Not Built
Streams	Gated Community
	Access Easement
	Entrance/Exit Ramp



1:190,000


1 0 1

Scale in Miles

Douglas County Public Works Department: GIS Disclaimer



All GIS data and information products provided by the Douglas County Public Works Department are for illustrative purposes only. While products are considered to be accurate when provided, Douglas County does not warrant that they are error free. Douglas County Public Works Department shall not be liable for direct, indirect, incidental, or consequential damages arising from the use of such products. The recipient, and/or user, acknowledges and agrees that the use of such products is at their sole risk. Questions concerning this or any other product provided by Douglas County Public Works Department, including errors, corrections and/or updates should be directed to:

Douglas County Public Works Engineering
100 Third St. Castle Rock, CO, 80104
(303) 660-7490
Engineering@douglas.co.us


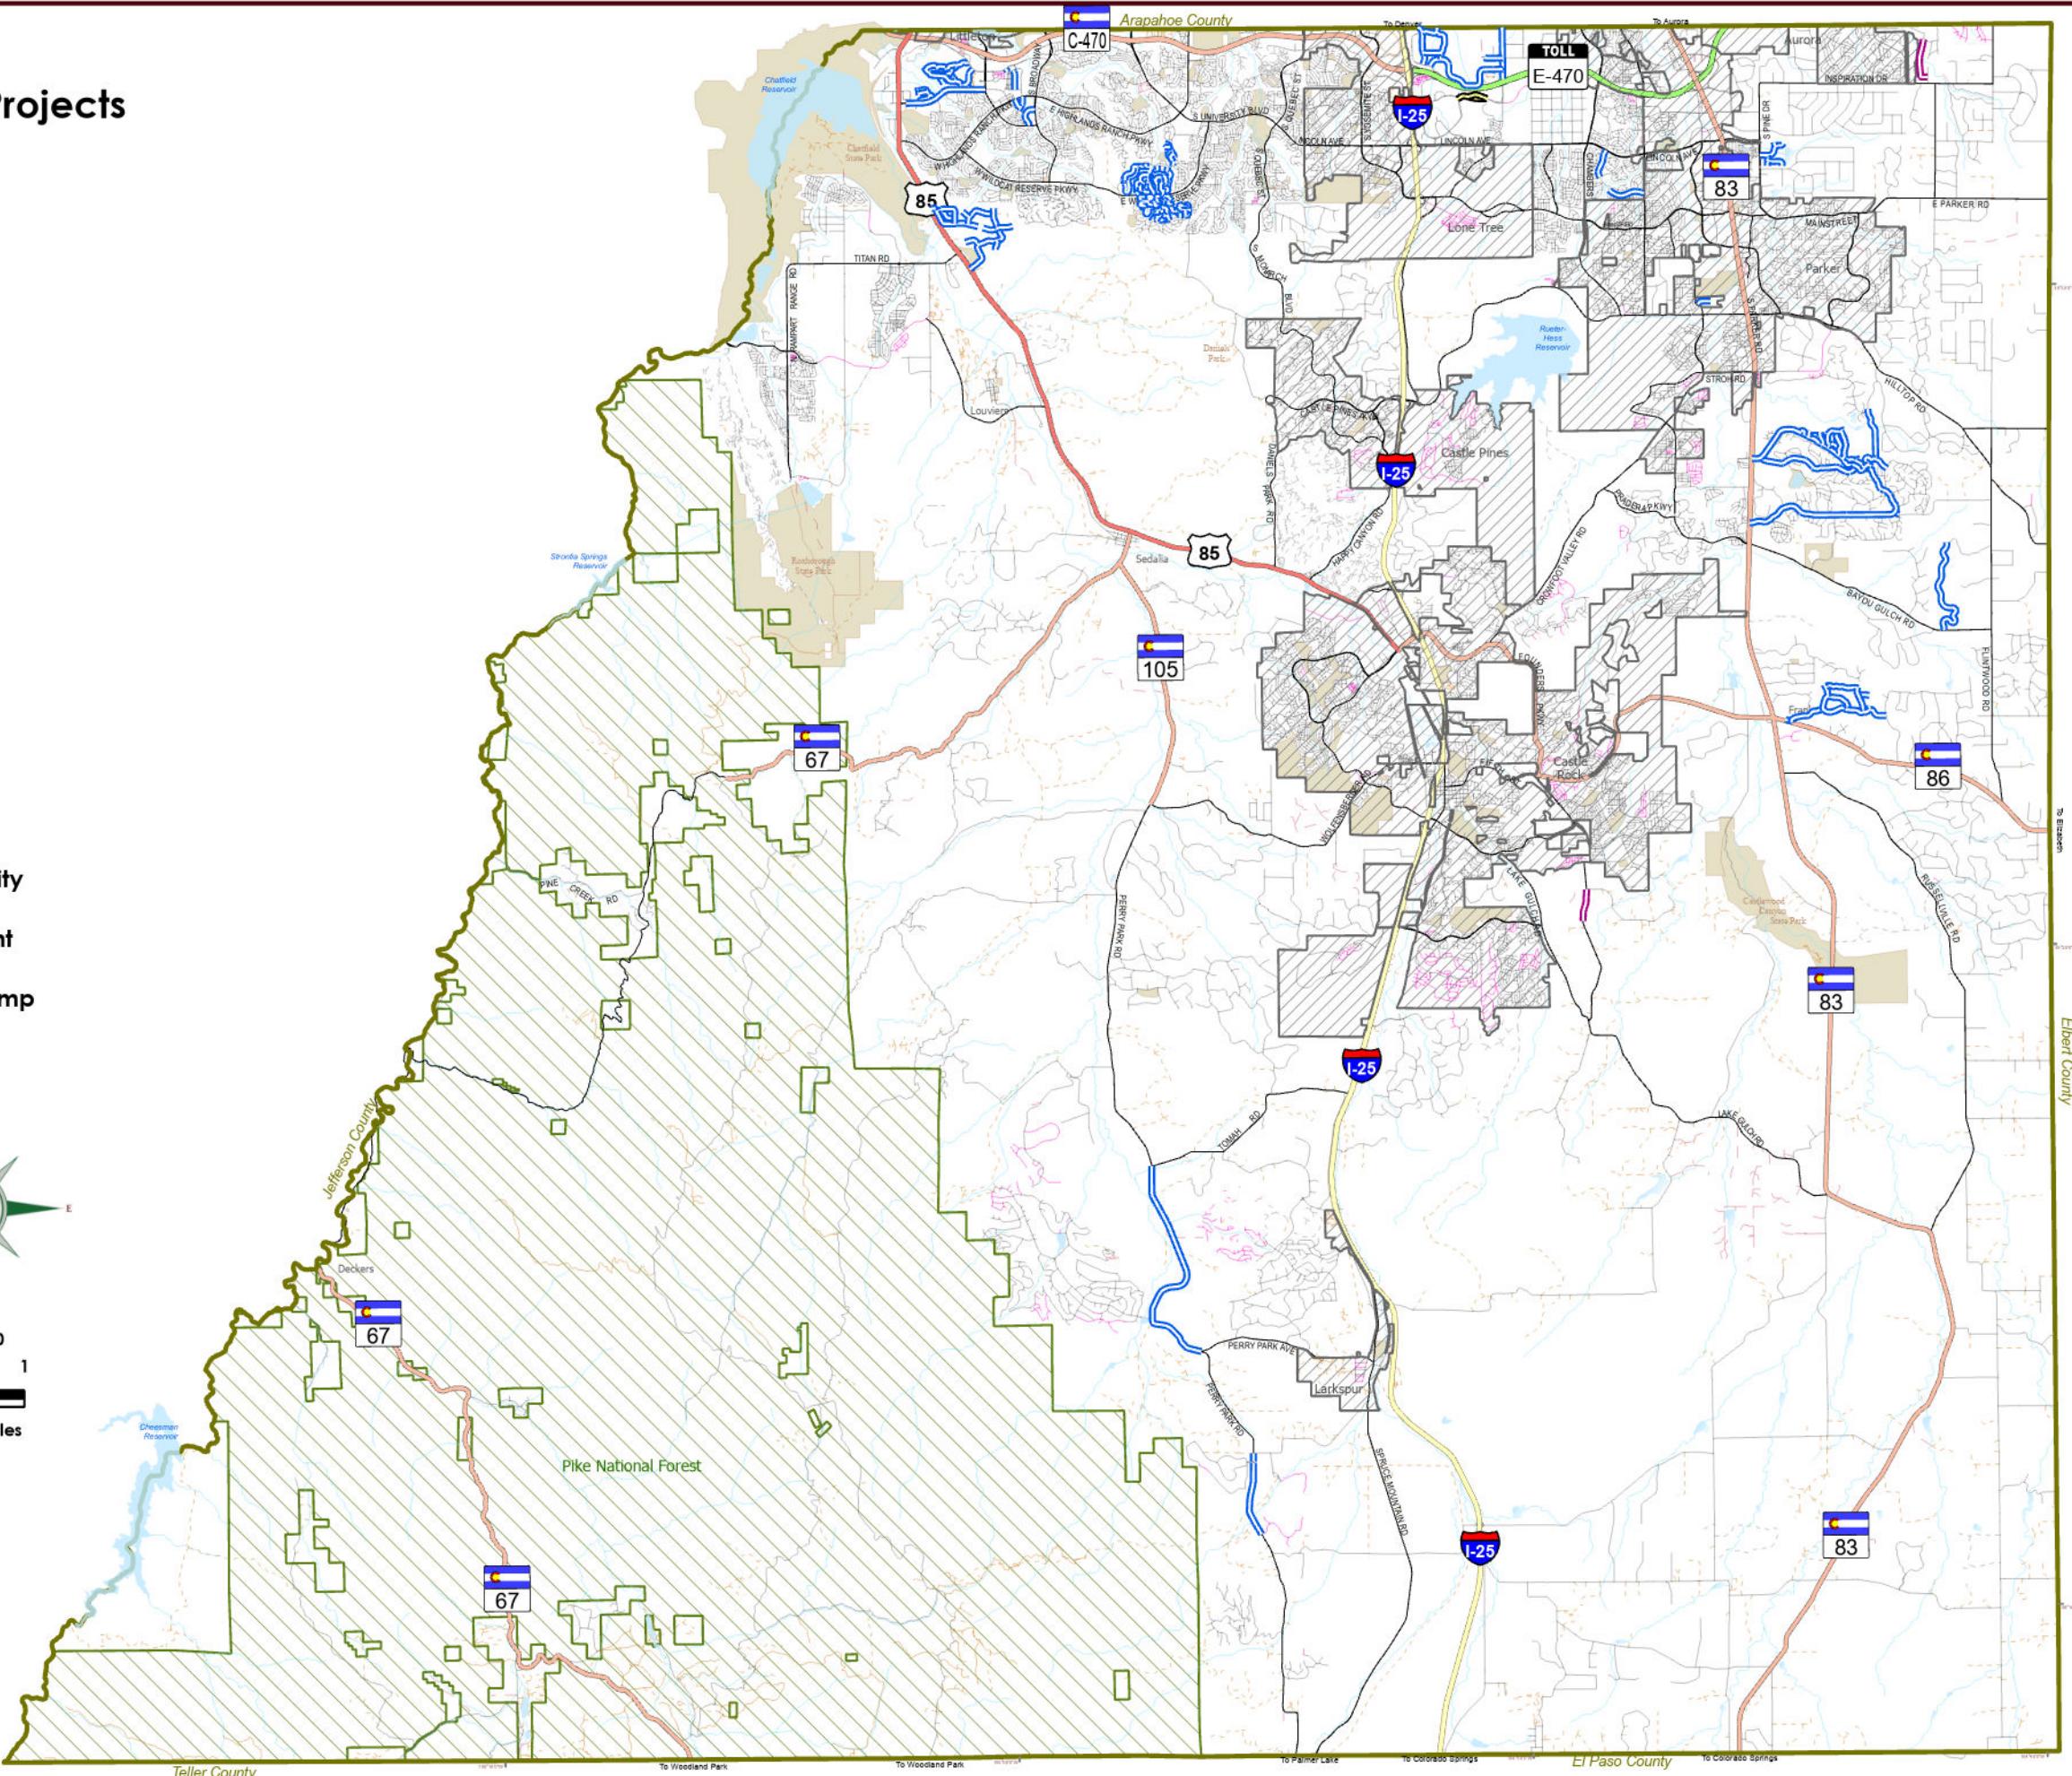


**As Built
2019 Contract Maintenance Projects
Douglas County, Colorado**

	HMA Overlay		Roads		Private
	County Boundary		US Highway		Platted Not Built
	Parks		State Highway		Gated Community
	Lakes		Major Road		Access Easement
	Streams		Local Road		Entrance/Exit Ramp

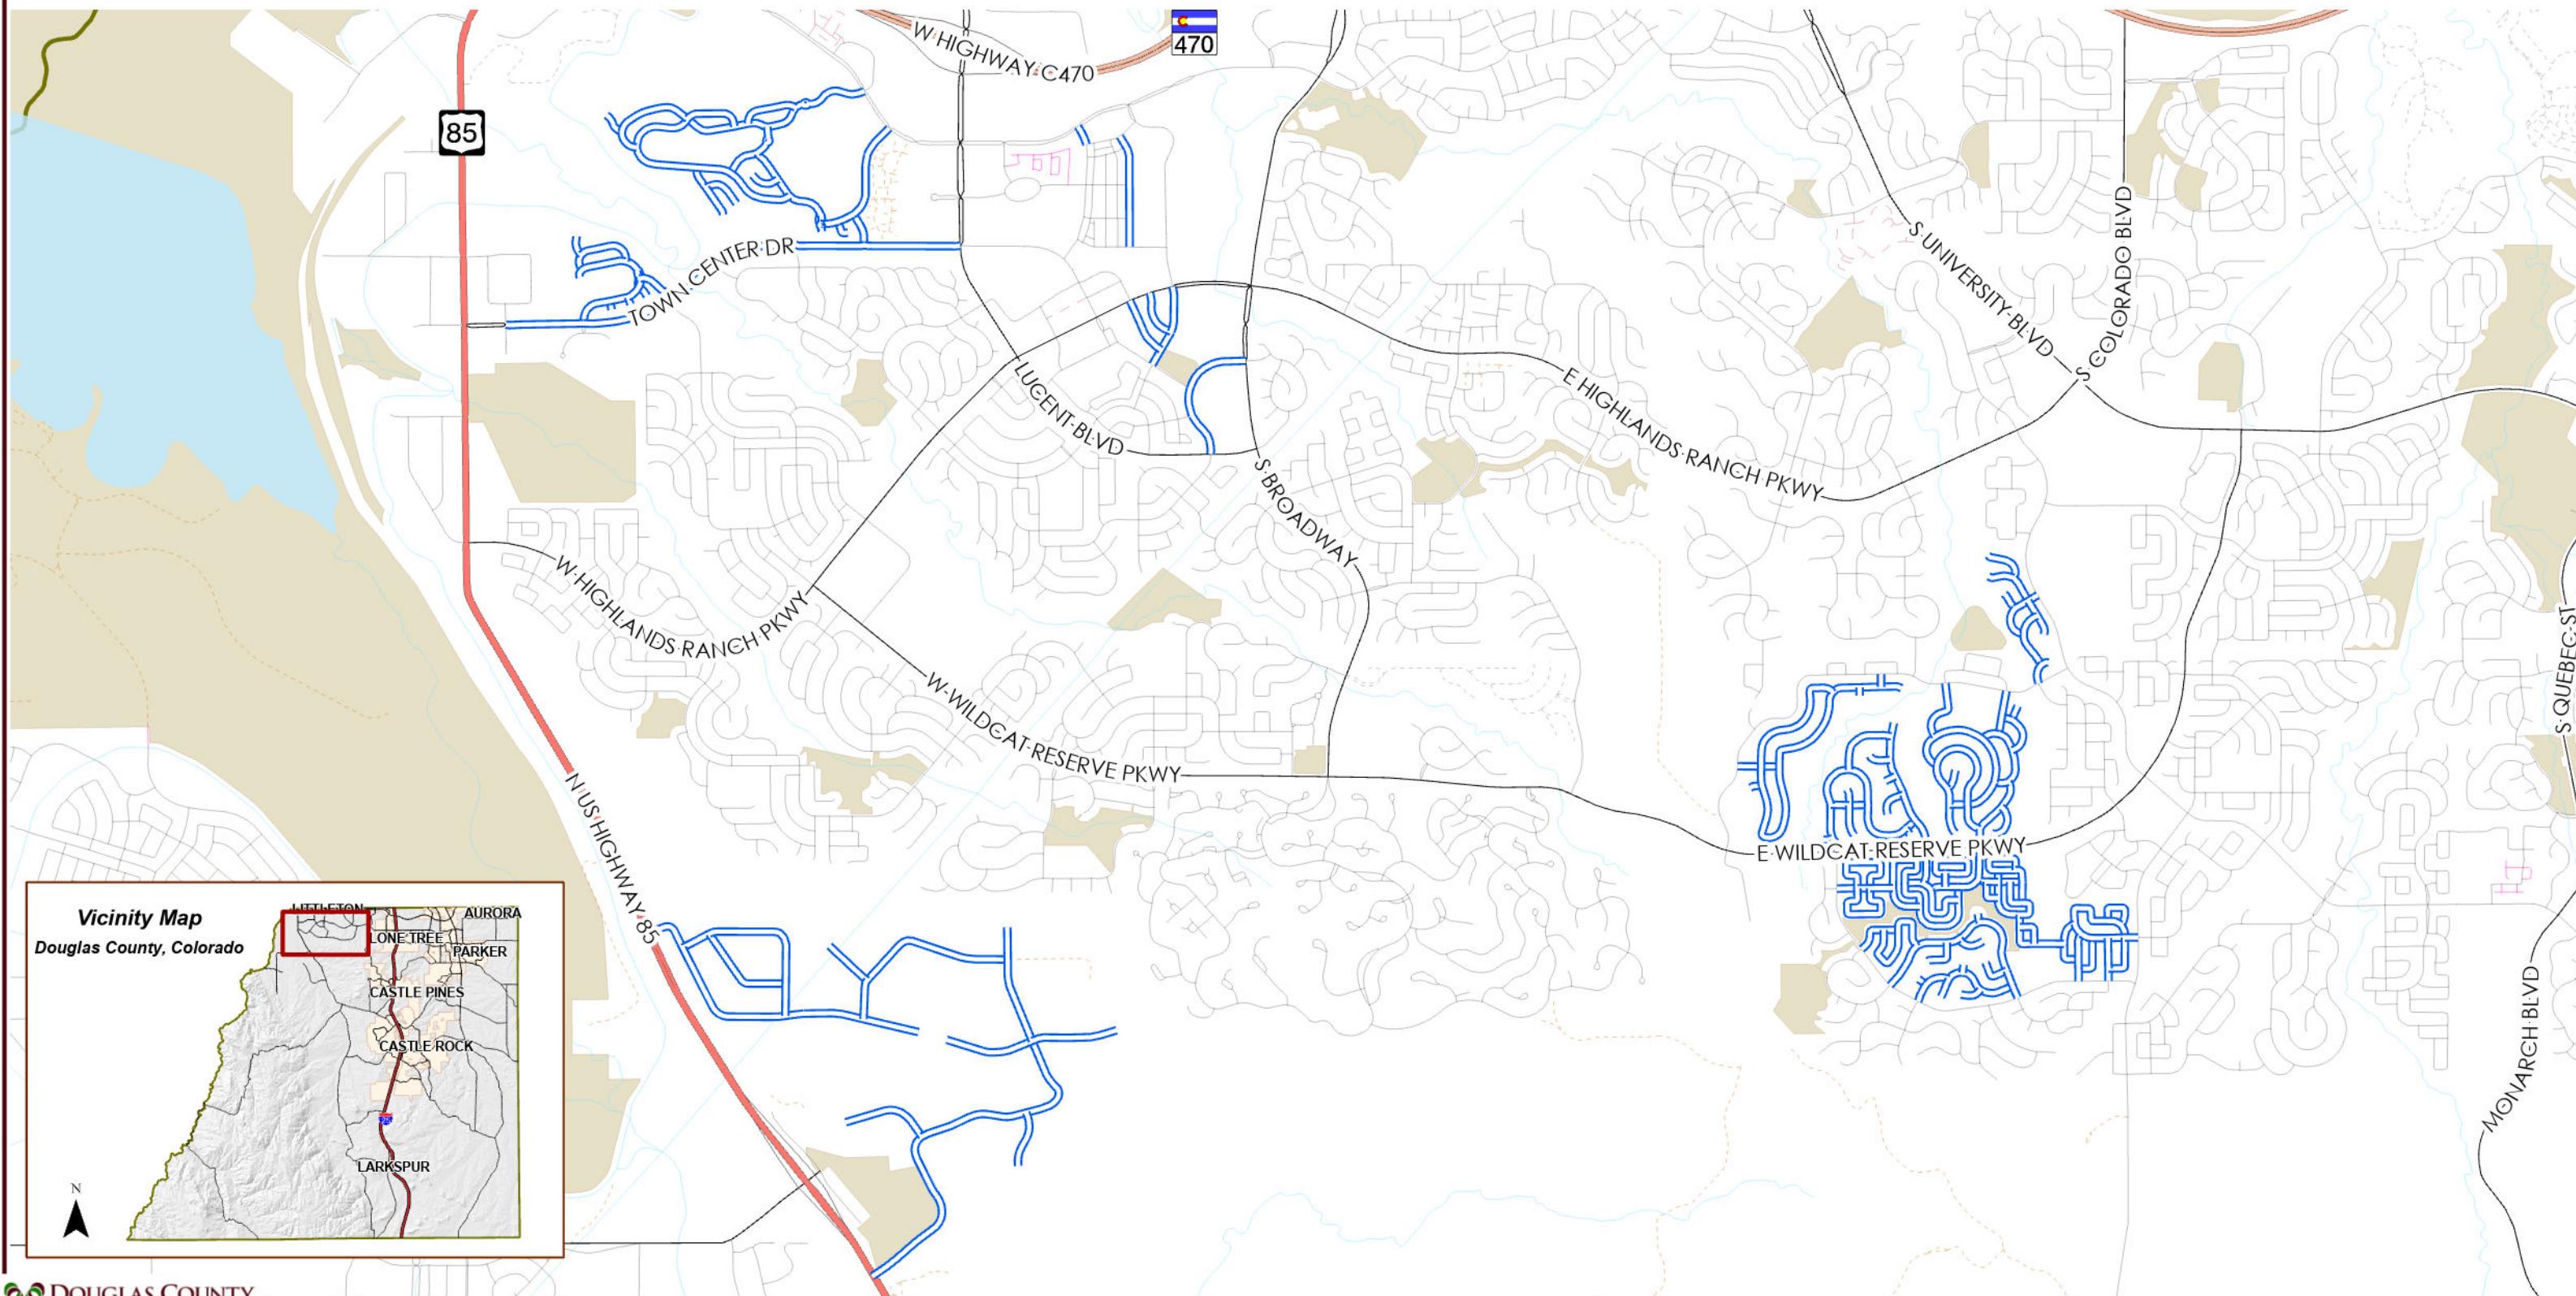
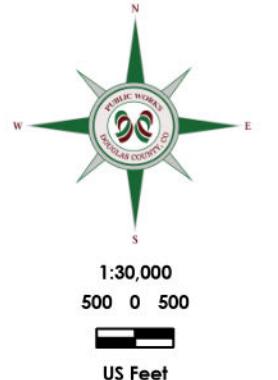


As Built 2019 Contract Maintenance Projects Douglas County, Colorado

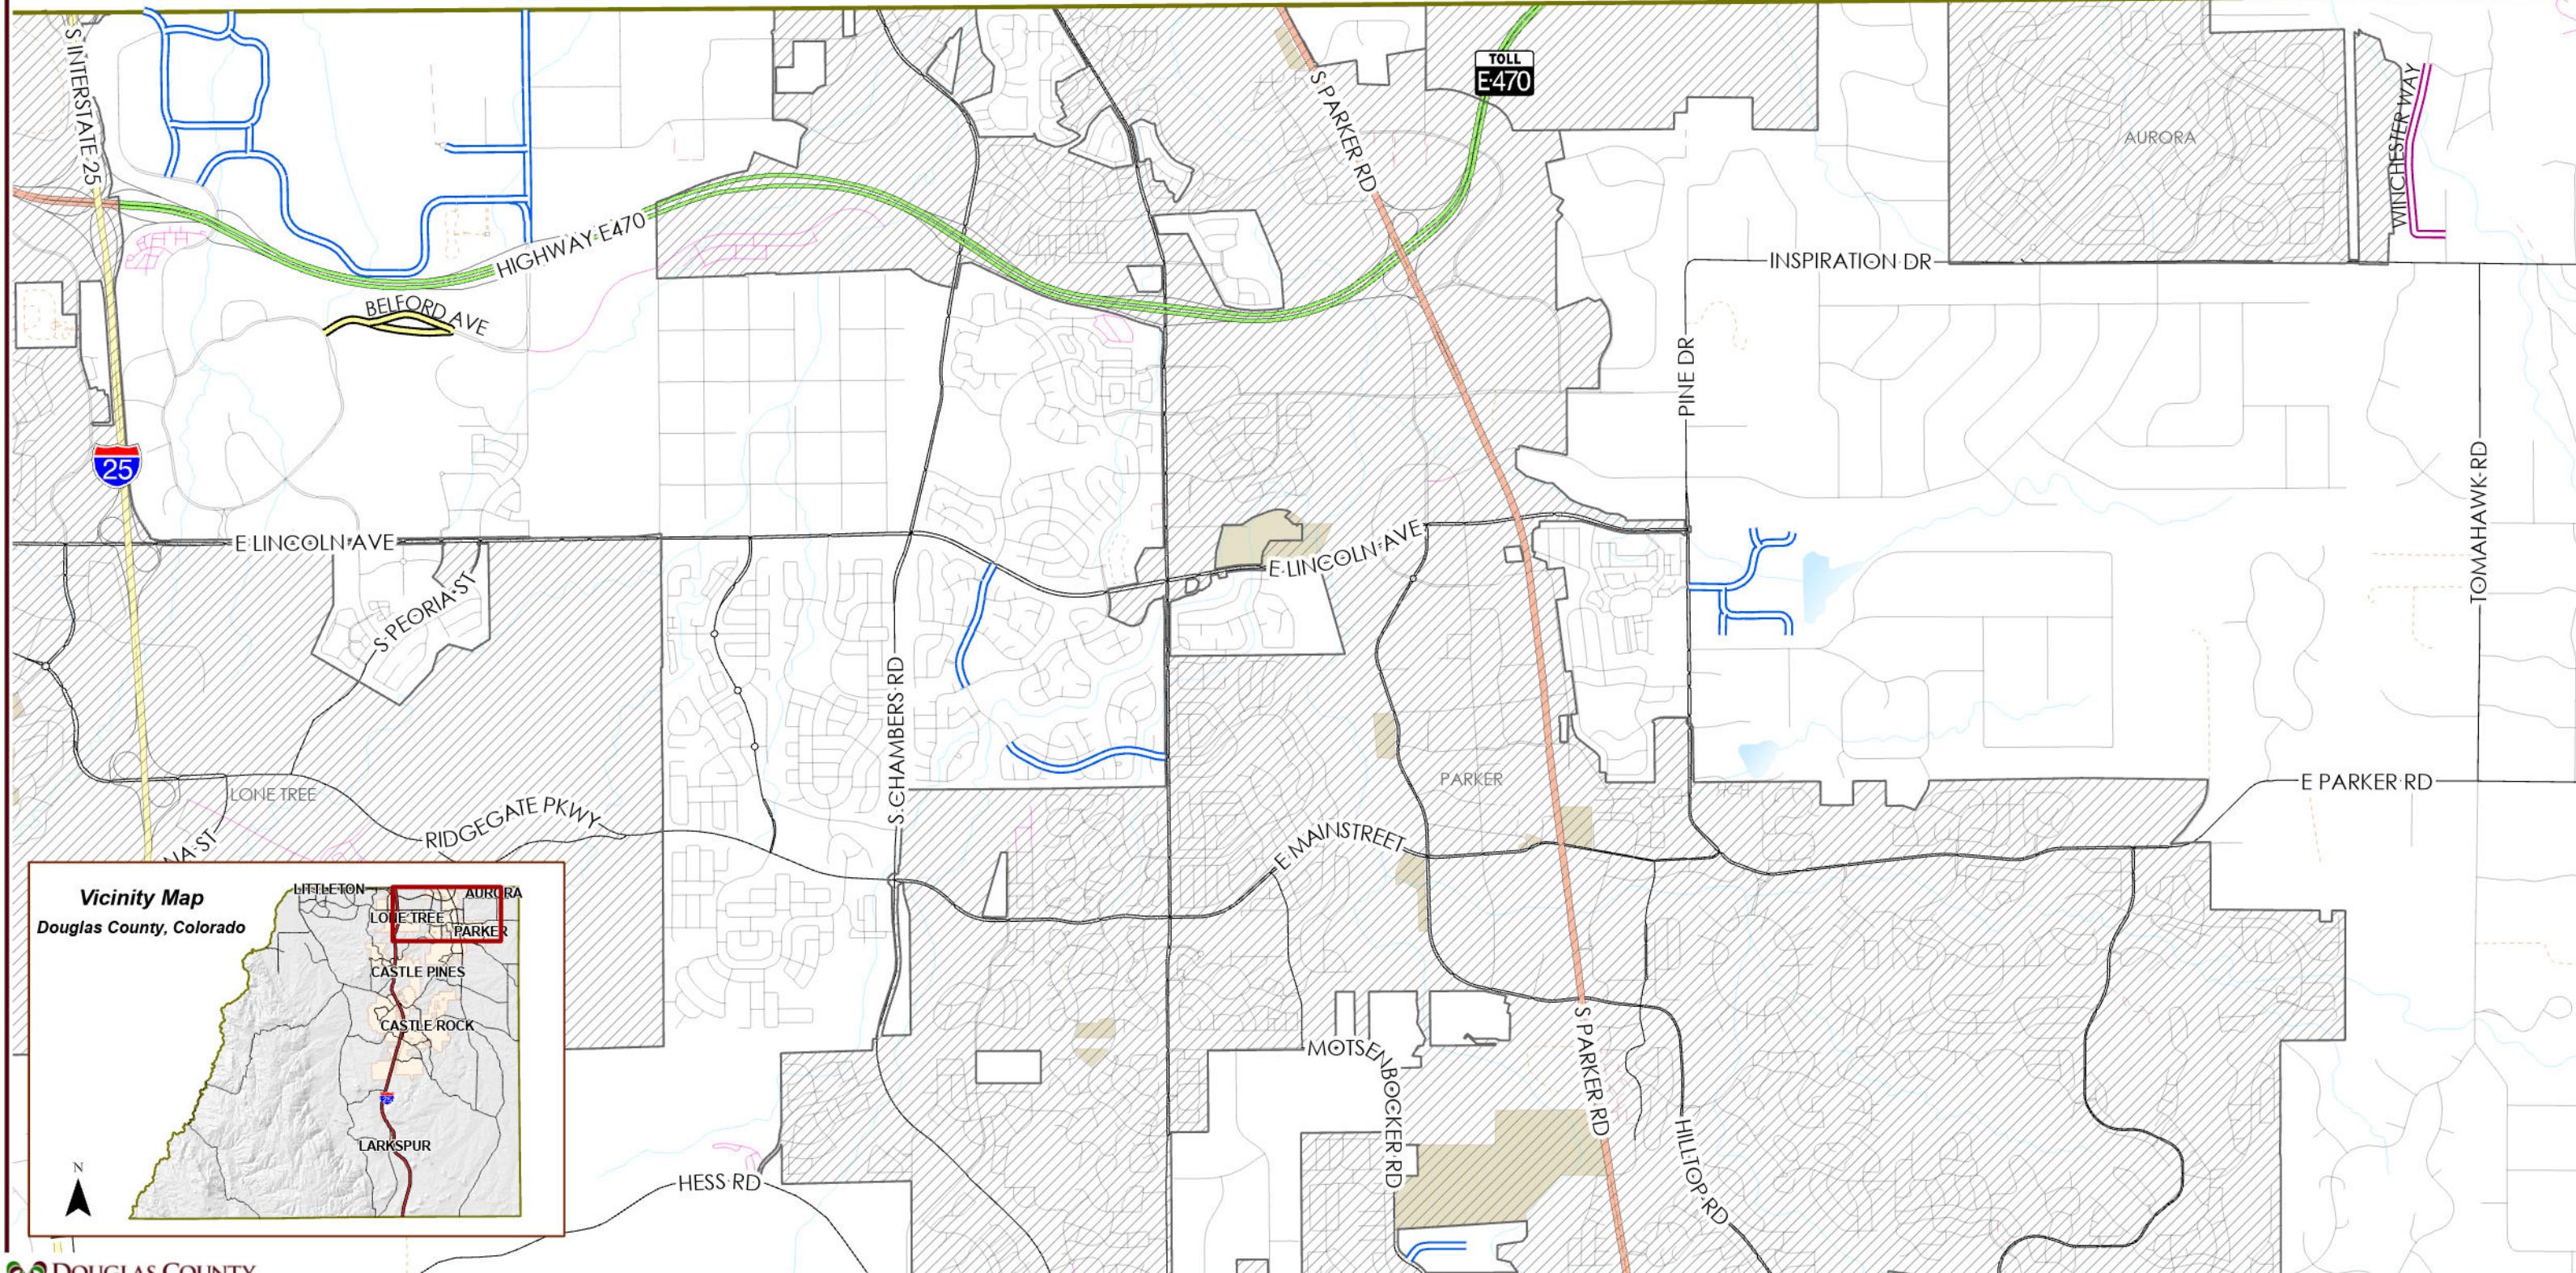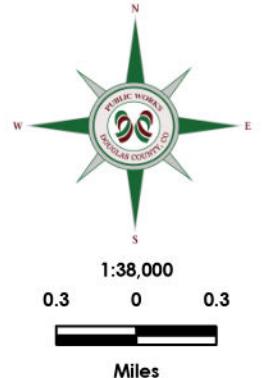



**As Built
2019 Contract Maintenance Projects
Douglas County, Colorado**

- HMA Overlay
- County Boundary
- Municipalities
- Parks
- Lakes
- Intermittent Lakes
- Streams
- Roads
- Local Road
- Private
- Gated Community
- State Highway
- Major Road

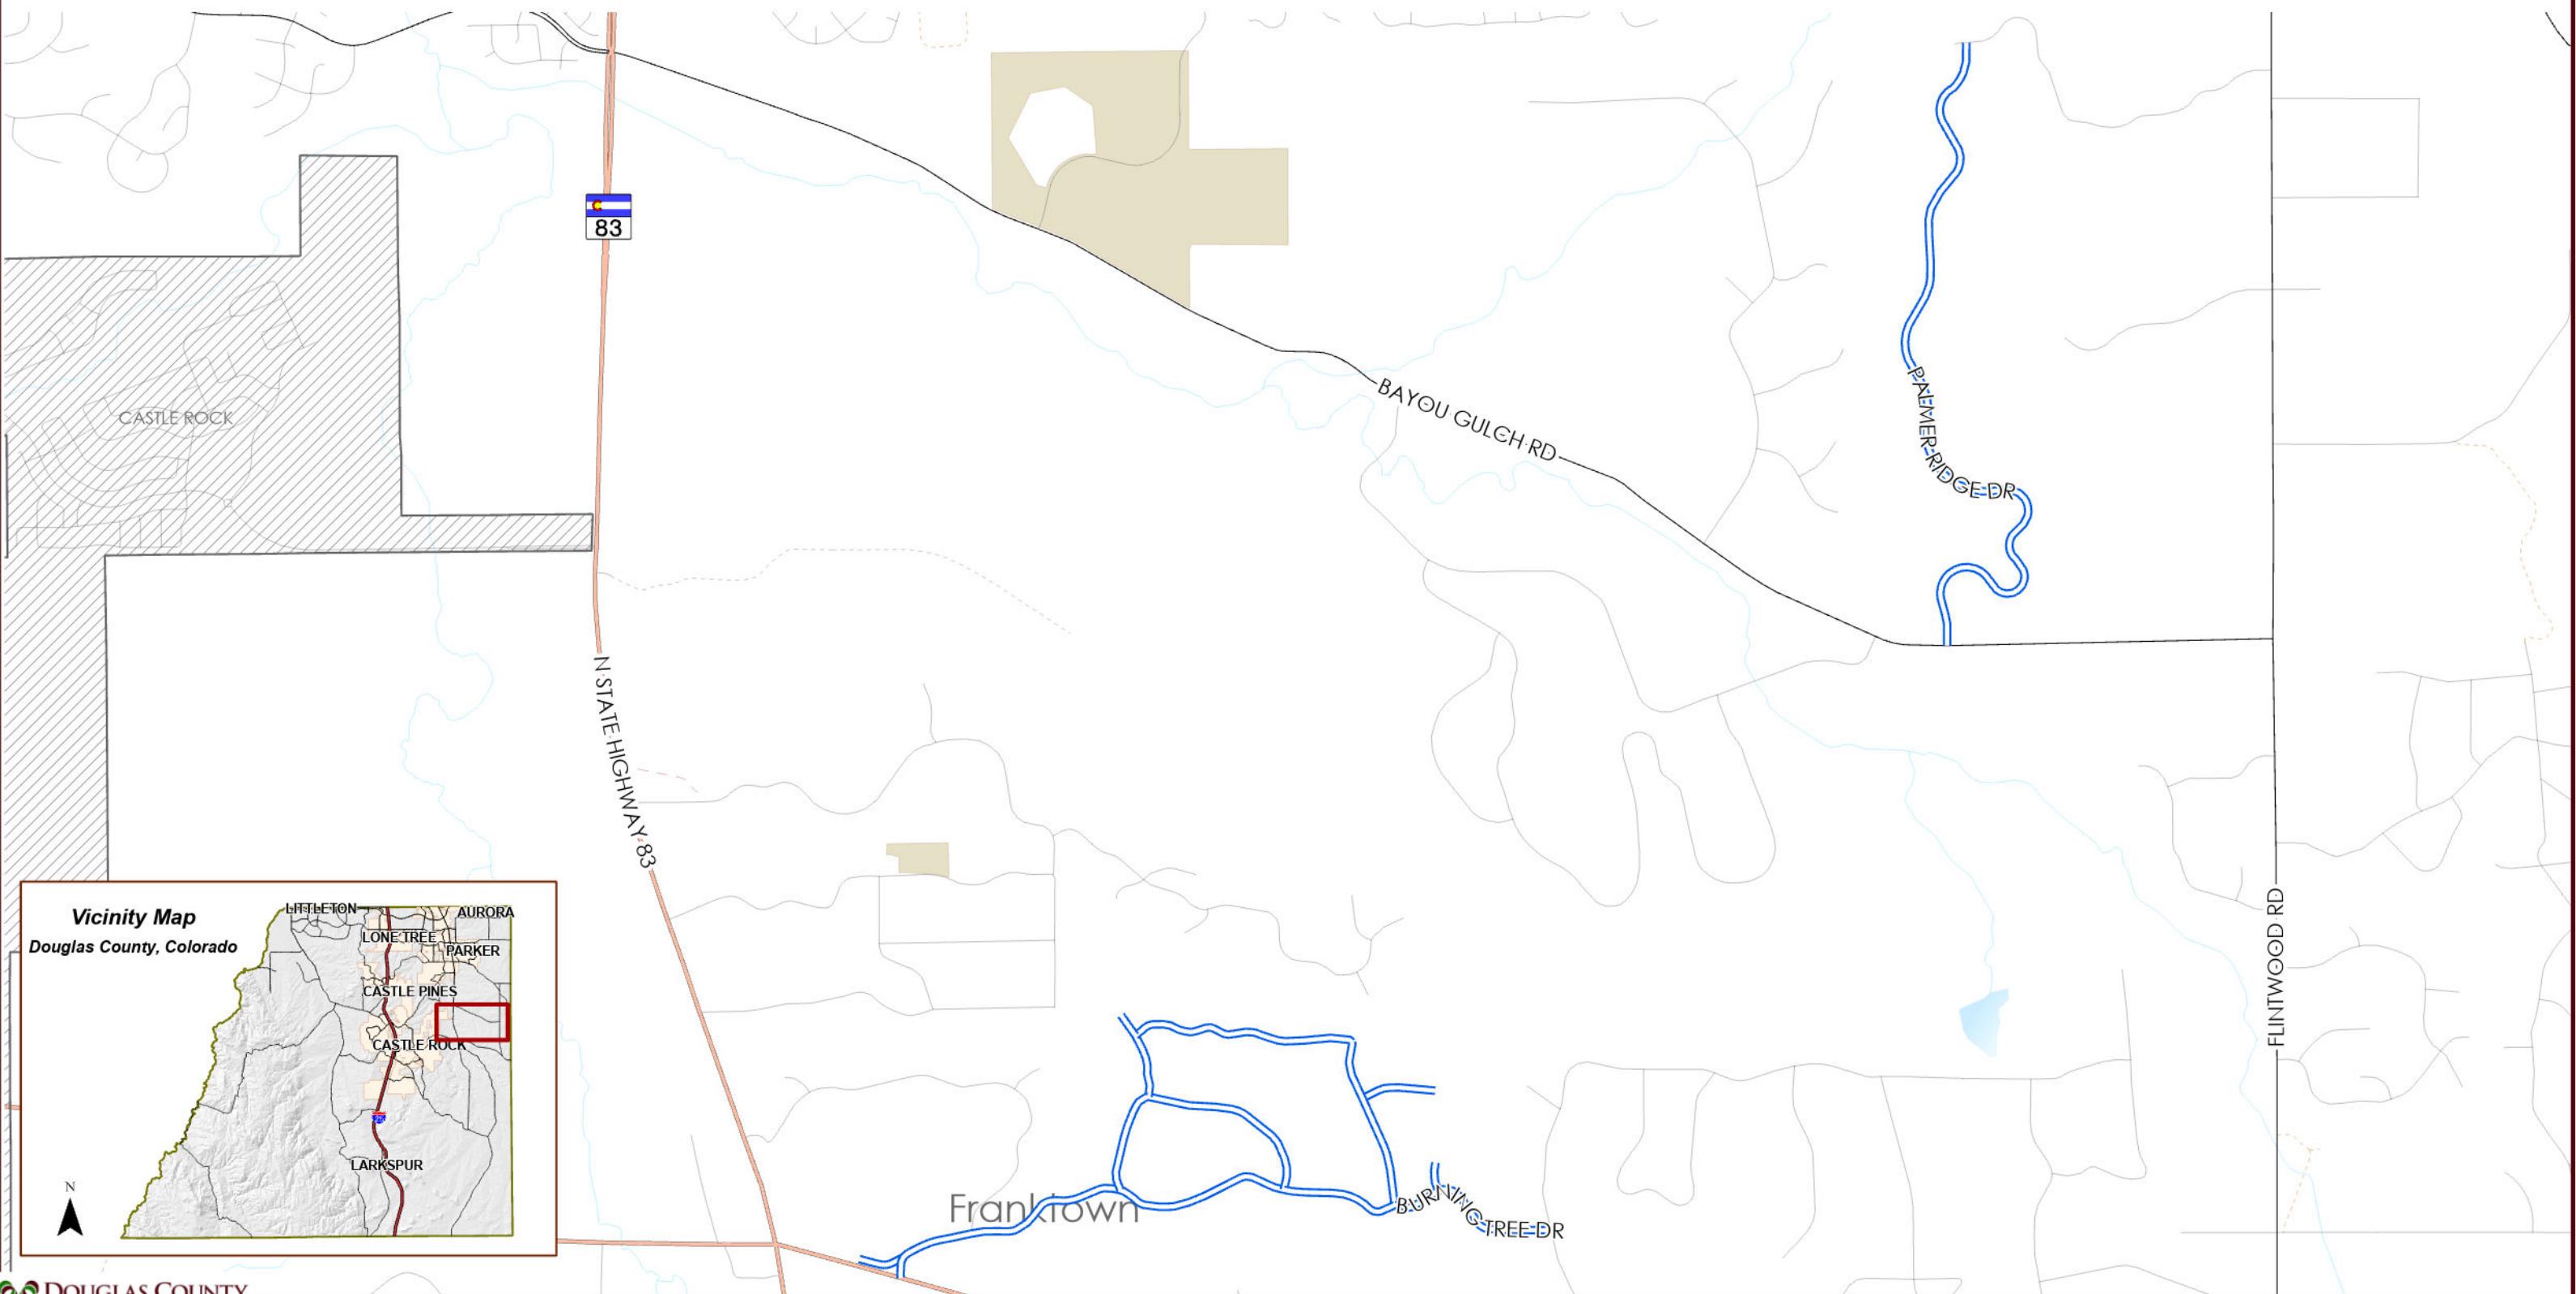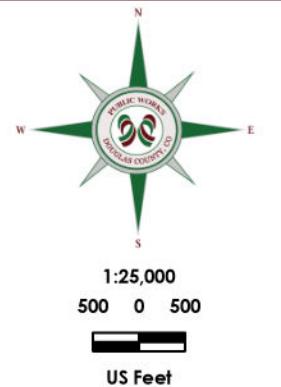



**As Built
2019 Contract Maintenance Projects
Douglas County, Colorado**

- HMA Overlay
- County Boundary
- Municipalities
- Parks
- Lakes
- Intermittent Lakes
- Streams
- Roads
- State Highway
- Major Road
- Local Road
- Private
- Platted Not Built

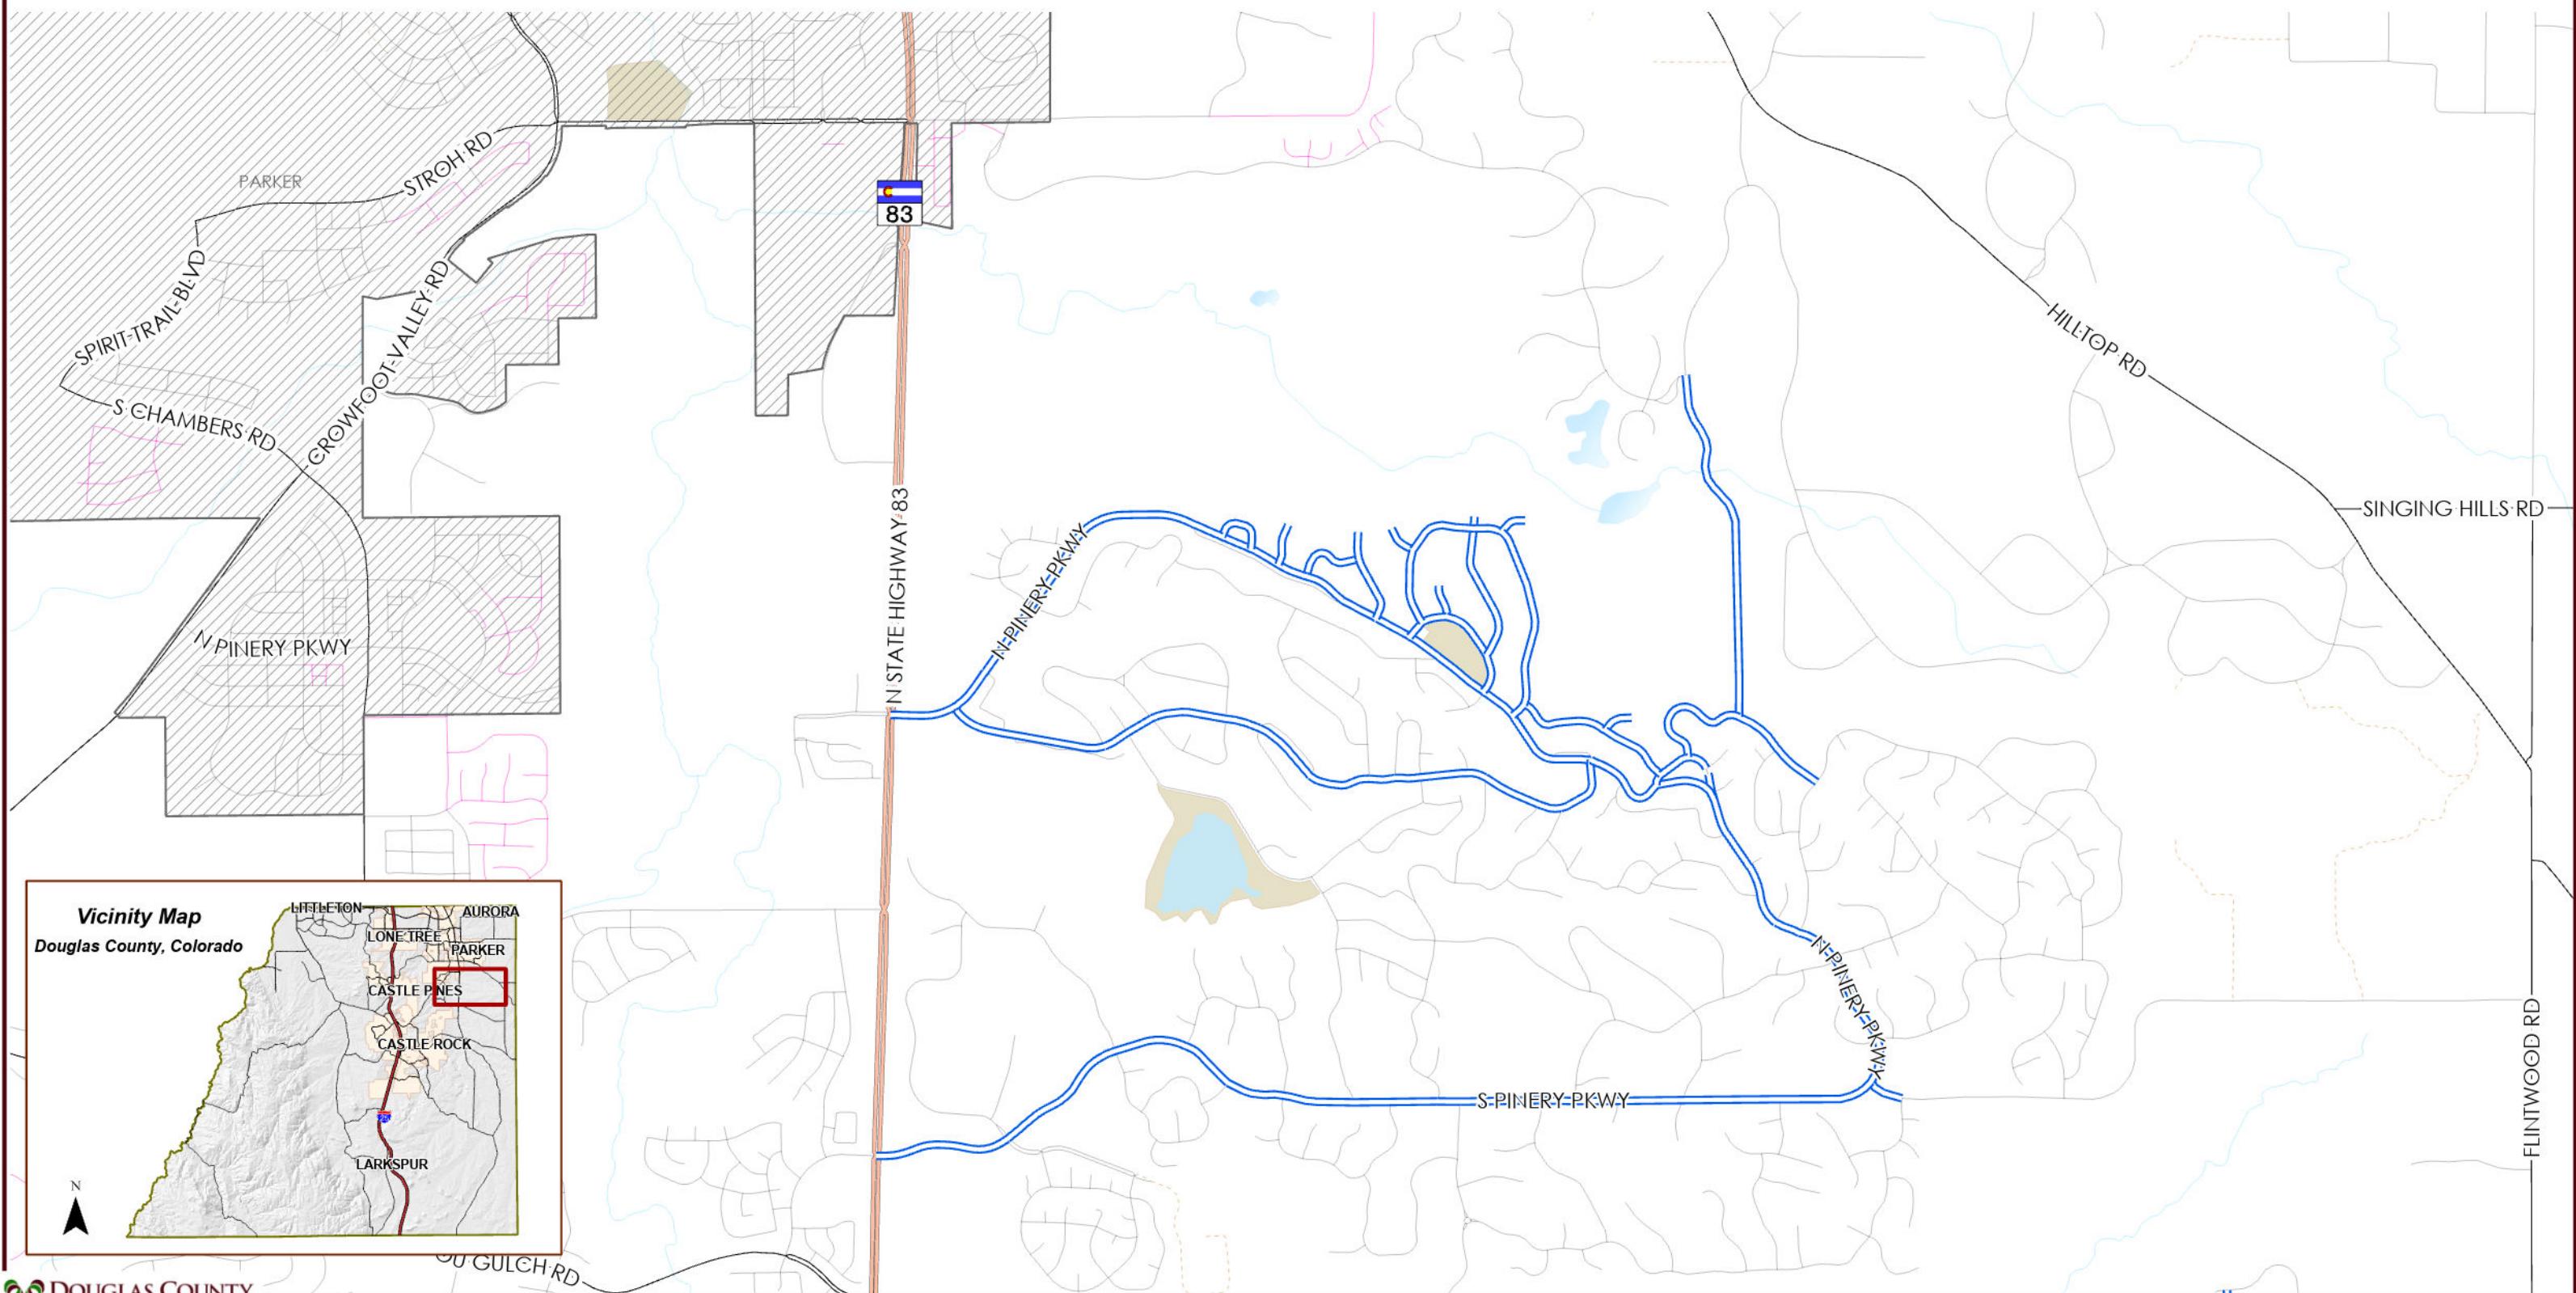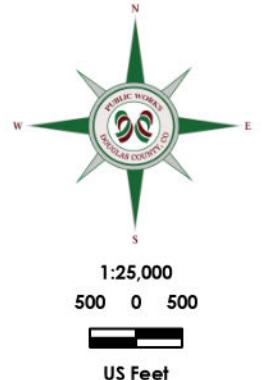

**As Built
2019 Contract Maintenance Projects
Douglas County, Colorado**

	Asphalt Full Depth		Streams		Private
	County Boundary		Roads		Platted Not Built
	Municipalities		Interstate		Access Easement
	Parks		Major Road		Entrance/Exit Ramp
	Intermittent Lakes		Local Road		

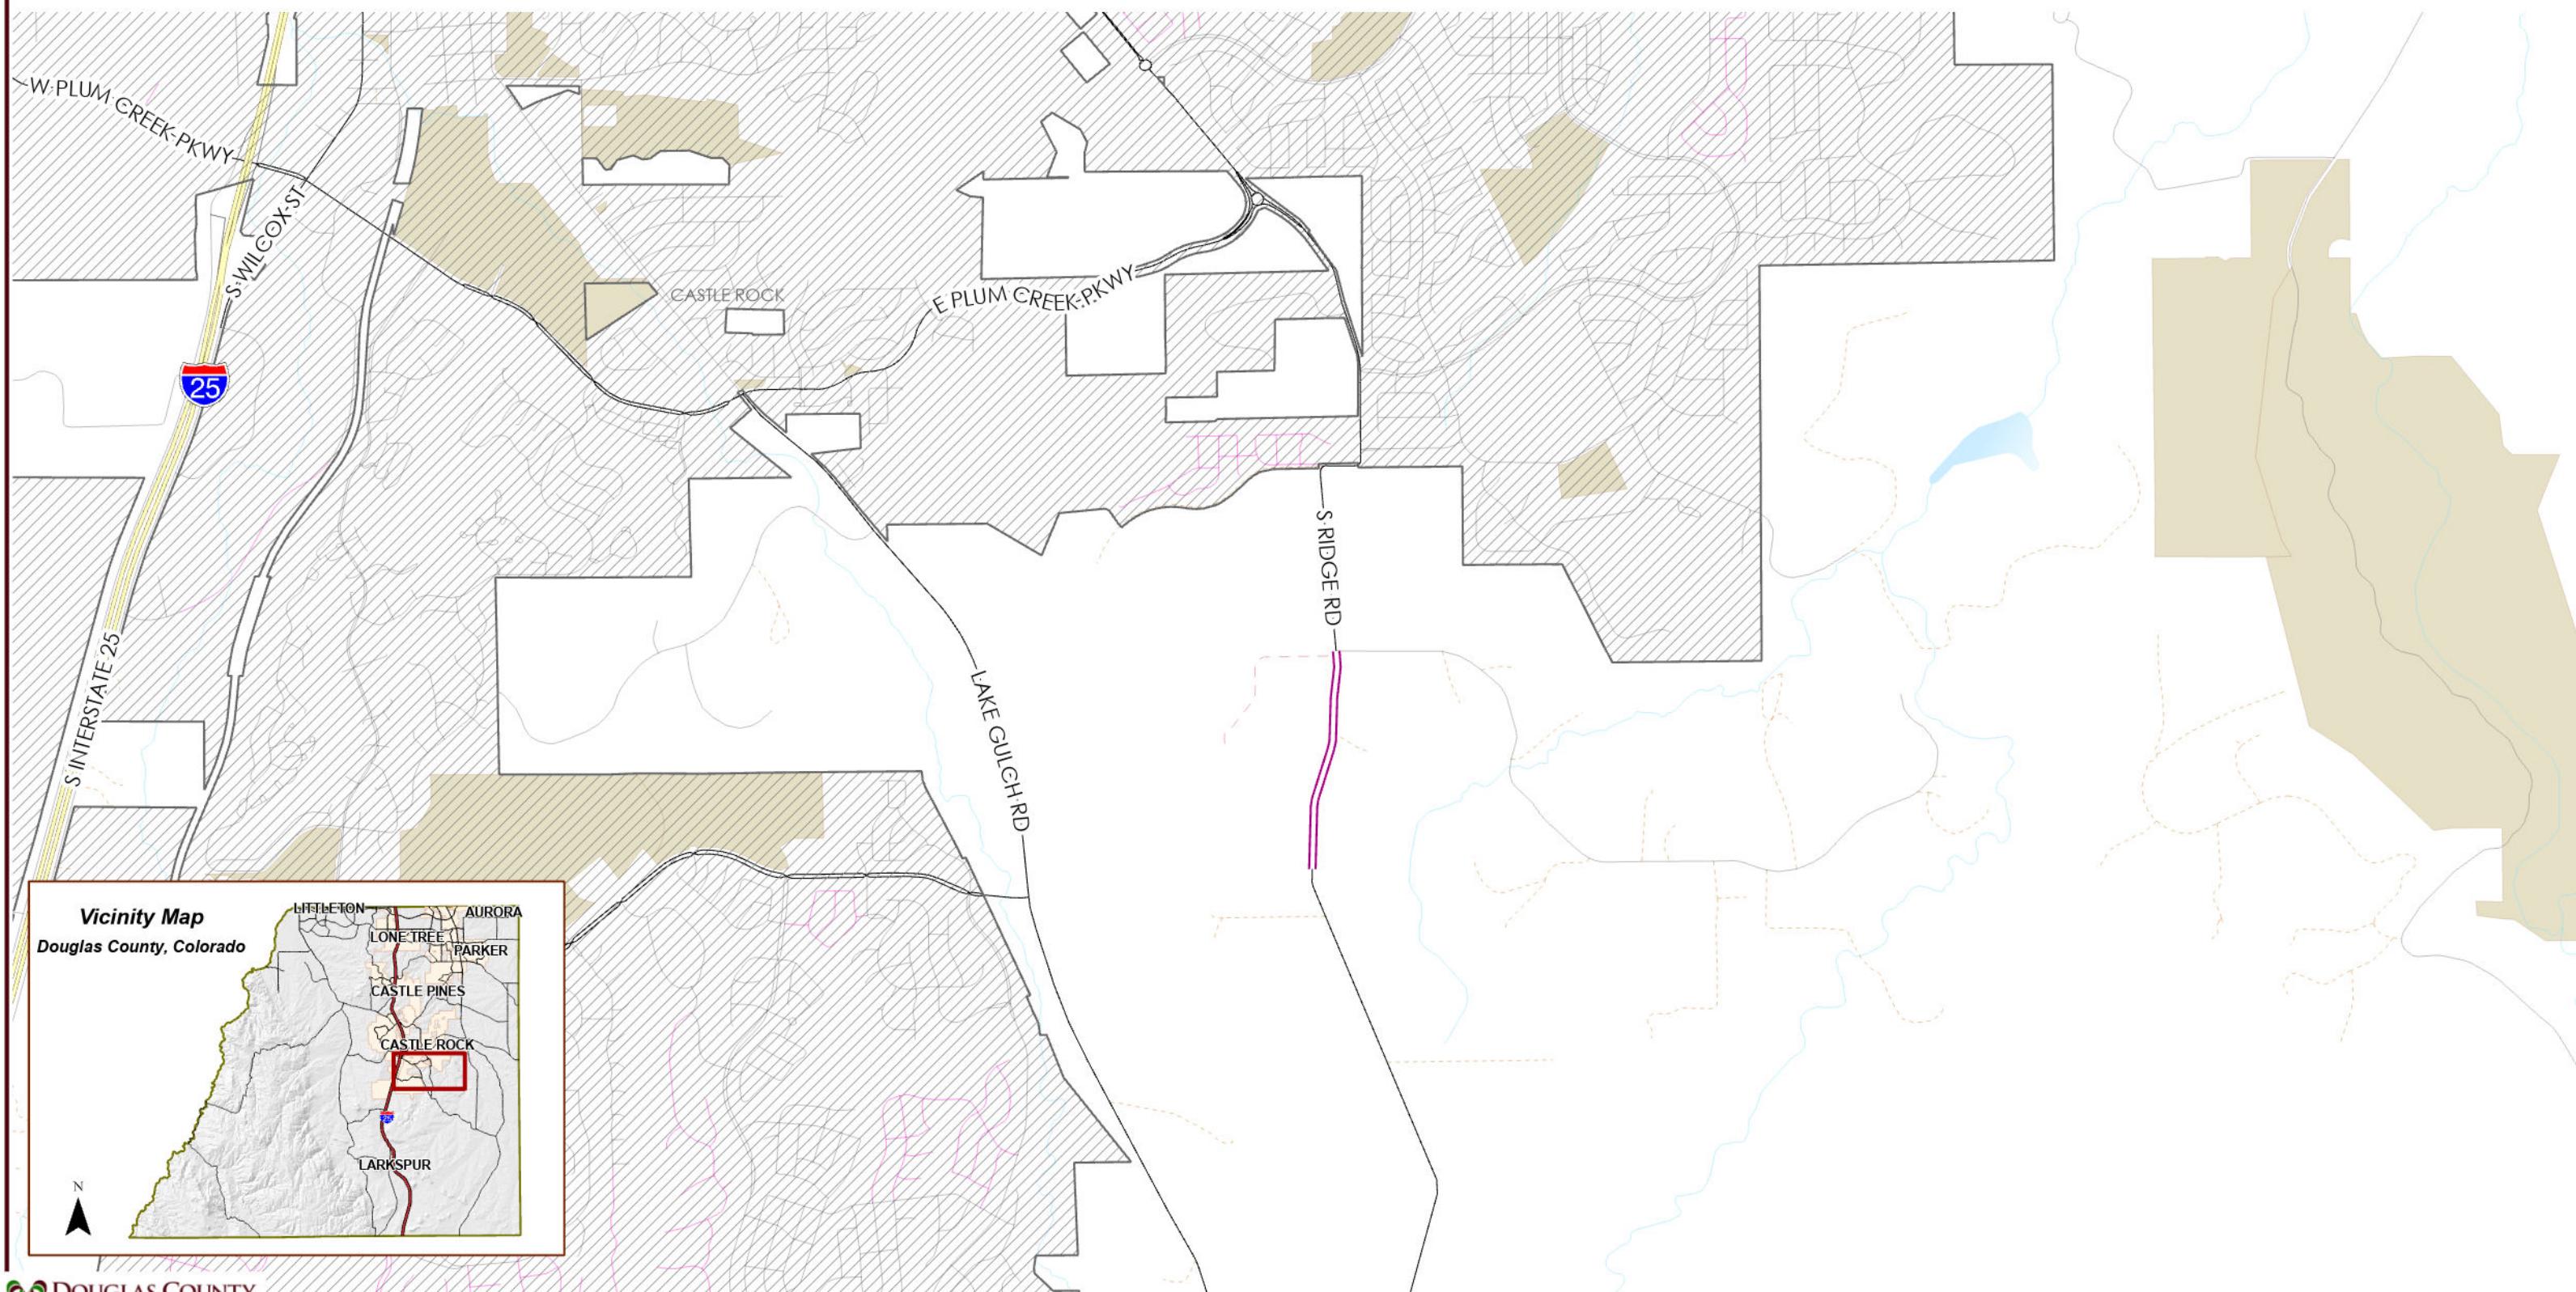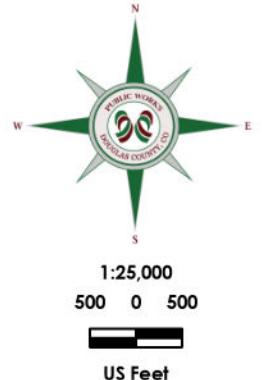

**As Built
2019 Contract Maintenance Projects
Douglas County, Colorado**

- HMA Overlay
- County Boundary
- Municipalities
- Parks
- Pike National Forest
- Lakes
- Intermittent Lakes
- Streams
- Roads
- Major Road
- Local Road
- Private
- Forest Road
- Interstate
- Gated Community
- Access Easement
- Entrance/Exit Ramp
- Platted Not Built

