

As Built 2020 Contract Maintenance Projects Douglas County, Colorado

	HMA Overlay
	Asphalt Full Depth
	Concrete
	County Boundary
	Municipalities
	Parks
	Pike National Forest
	Lakes
	Intermittent Lakes
	Streams
Roads	
	Interstate
	US Highway
	State Highway
	Toll Highway
	Major Road
	Local Road
	Private
	Forest Road
	Platted Not Built
	Gated Community
	Access Easement
	Entrance/Exit Ramp



1:190,000


1 0 1

Scale in Miles

Douglas County Public Works Department: GIS Disclaimer


All GIS data and information products provided by the Douglas County Public Works Department are for illustrative purposes only. While products are considered to be accurate when provided, Douglas County does not warrant that they are error free. Douglas County Public Works Department shall not be liable for direct, indirect, incidental, or consequential damages arising from the use of such products. The recipient, and/or user, acknowledges and agrees that the use of such products is at their sole risk. Questions concerning this or any other product provided by Douglas County Public Works Department, including errors, corrections and/or updates should be directed to:

Douglas County Public Works Engineering
100 Third St. Castle Rock, CO, 80104
(303) 660-7490
Engineering@douglas.co.us


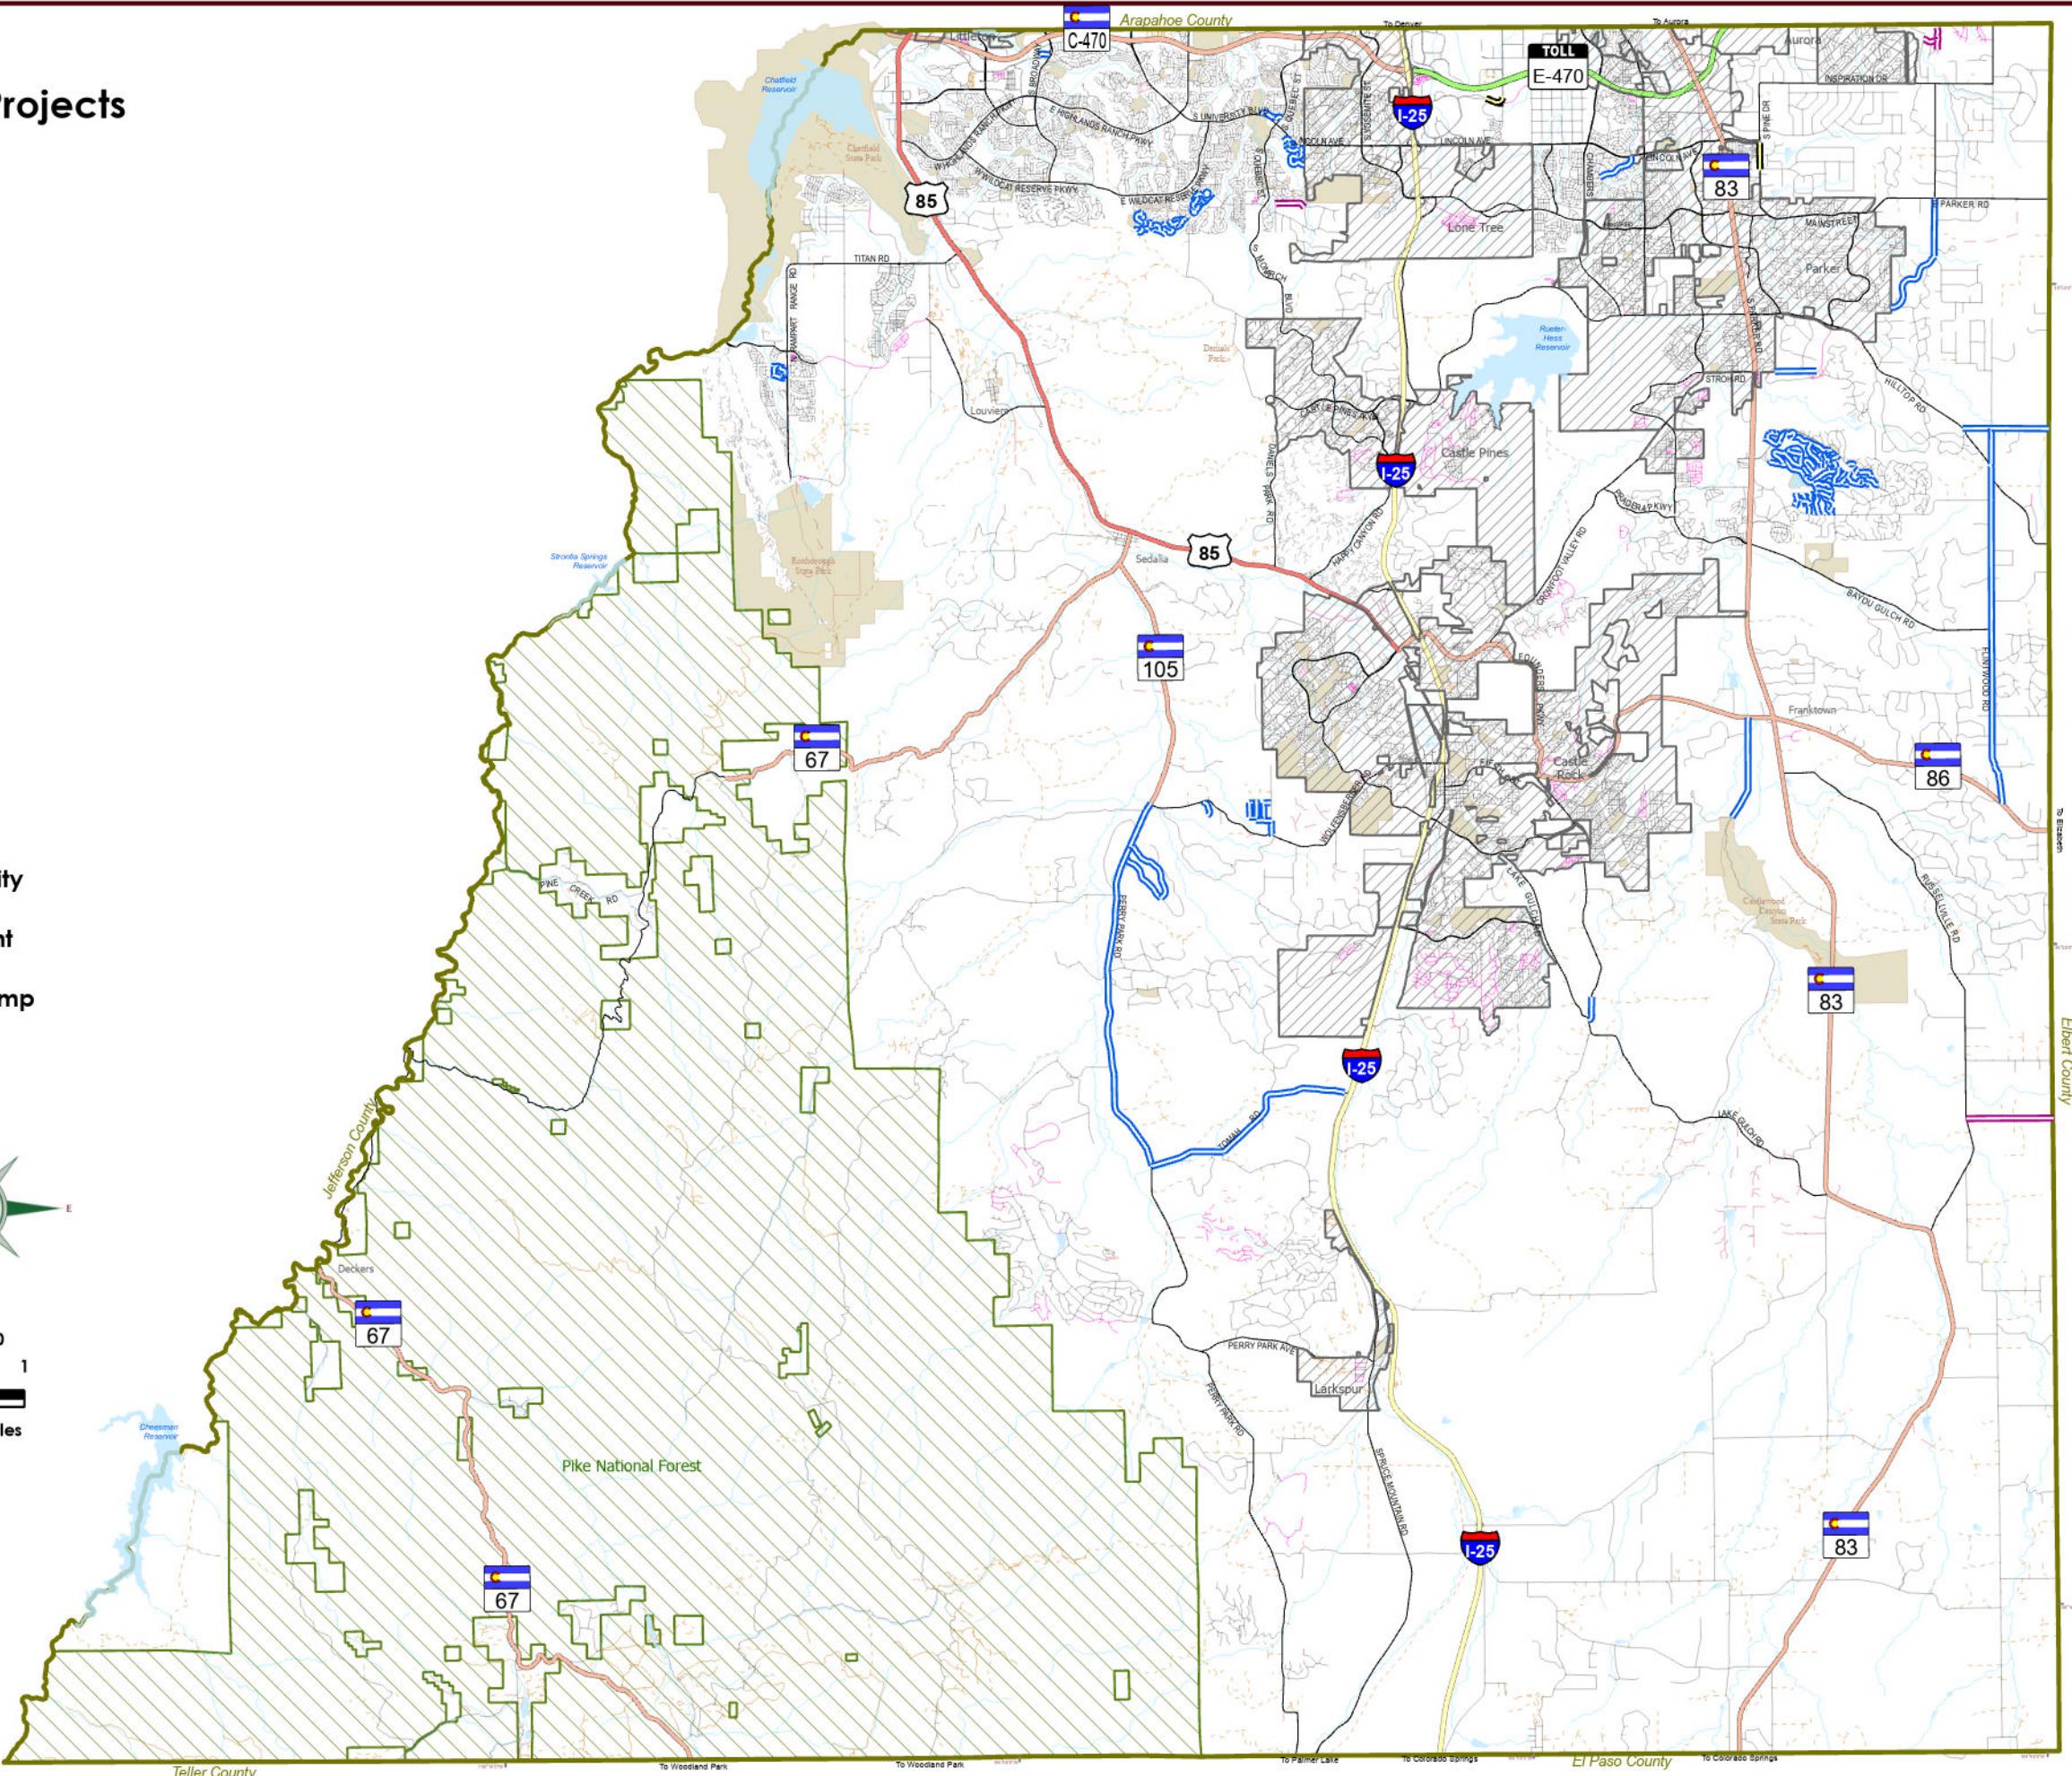


**As Built
2020 Contract Maintenance Projects
Douglas County, Colorado**

- HMA Overlay
- Asphalt Full Depth
- County Boundary
- Municipalities
- Parks
- Streams
- Roads
- State Highway
- Major Road
- Local Road
- Private
- Platted Not Built
- Gated Community
- Access Easement
- Entrance/Exit Ramp

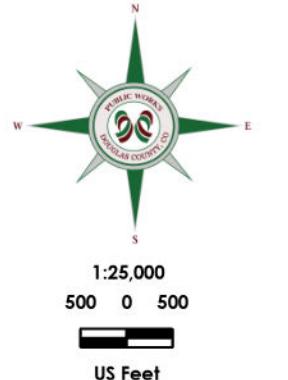


As Built 2020 Contract Maintenance Projects Douglas County, Colorado

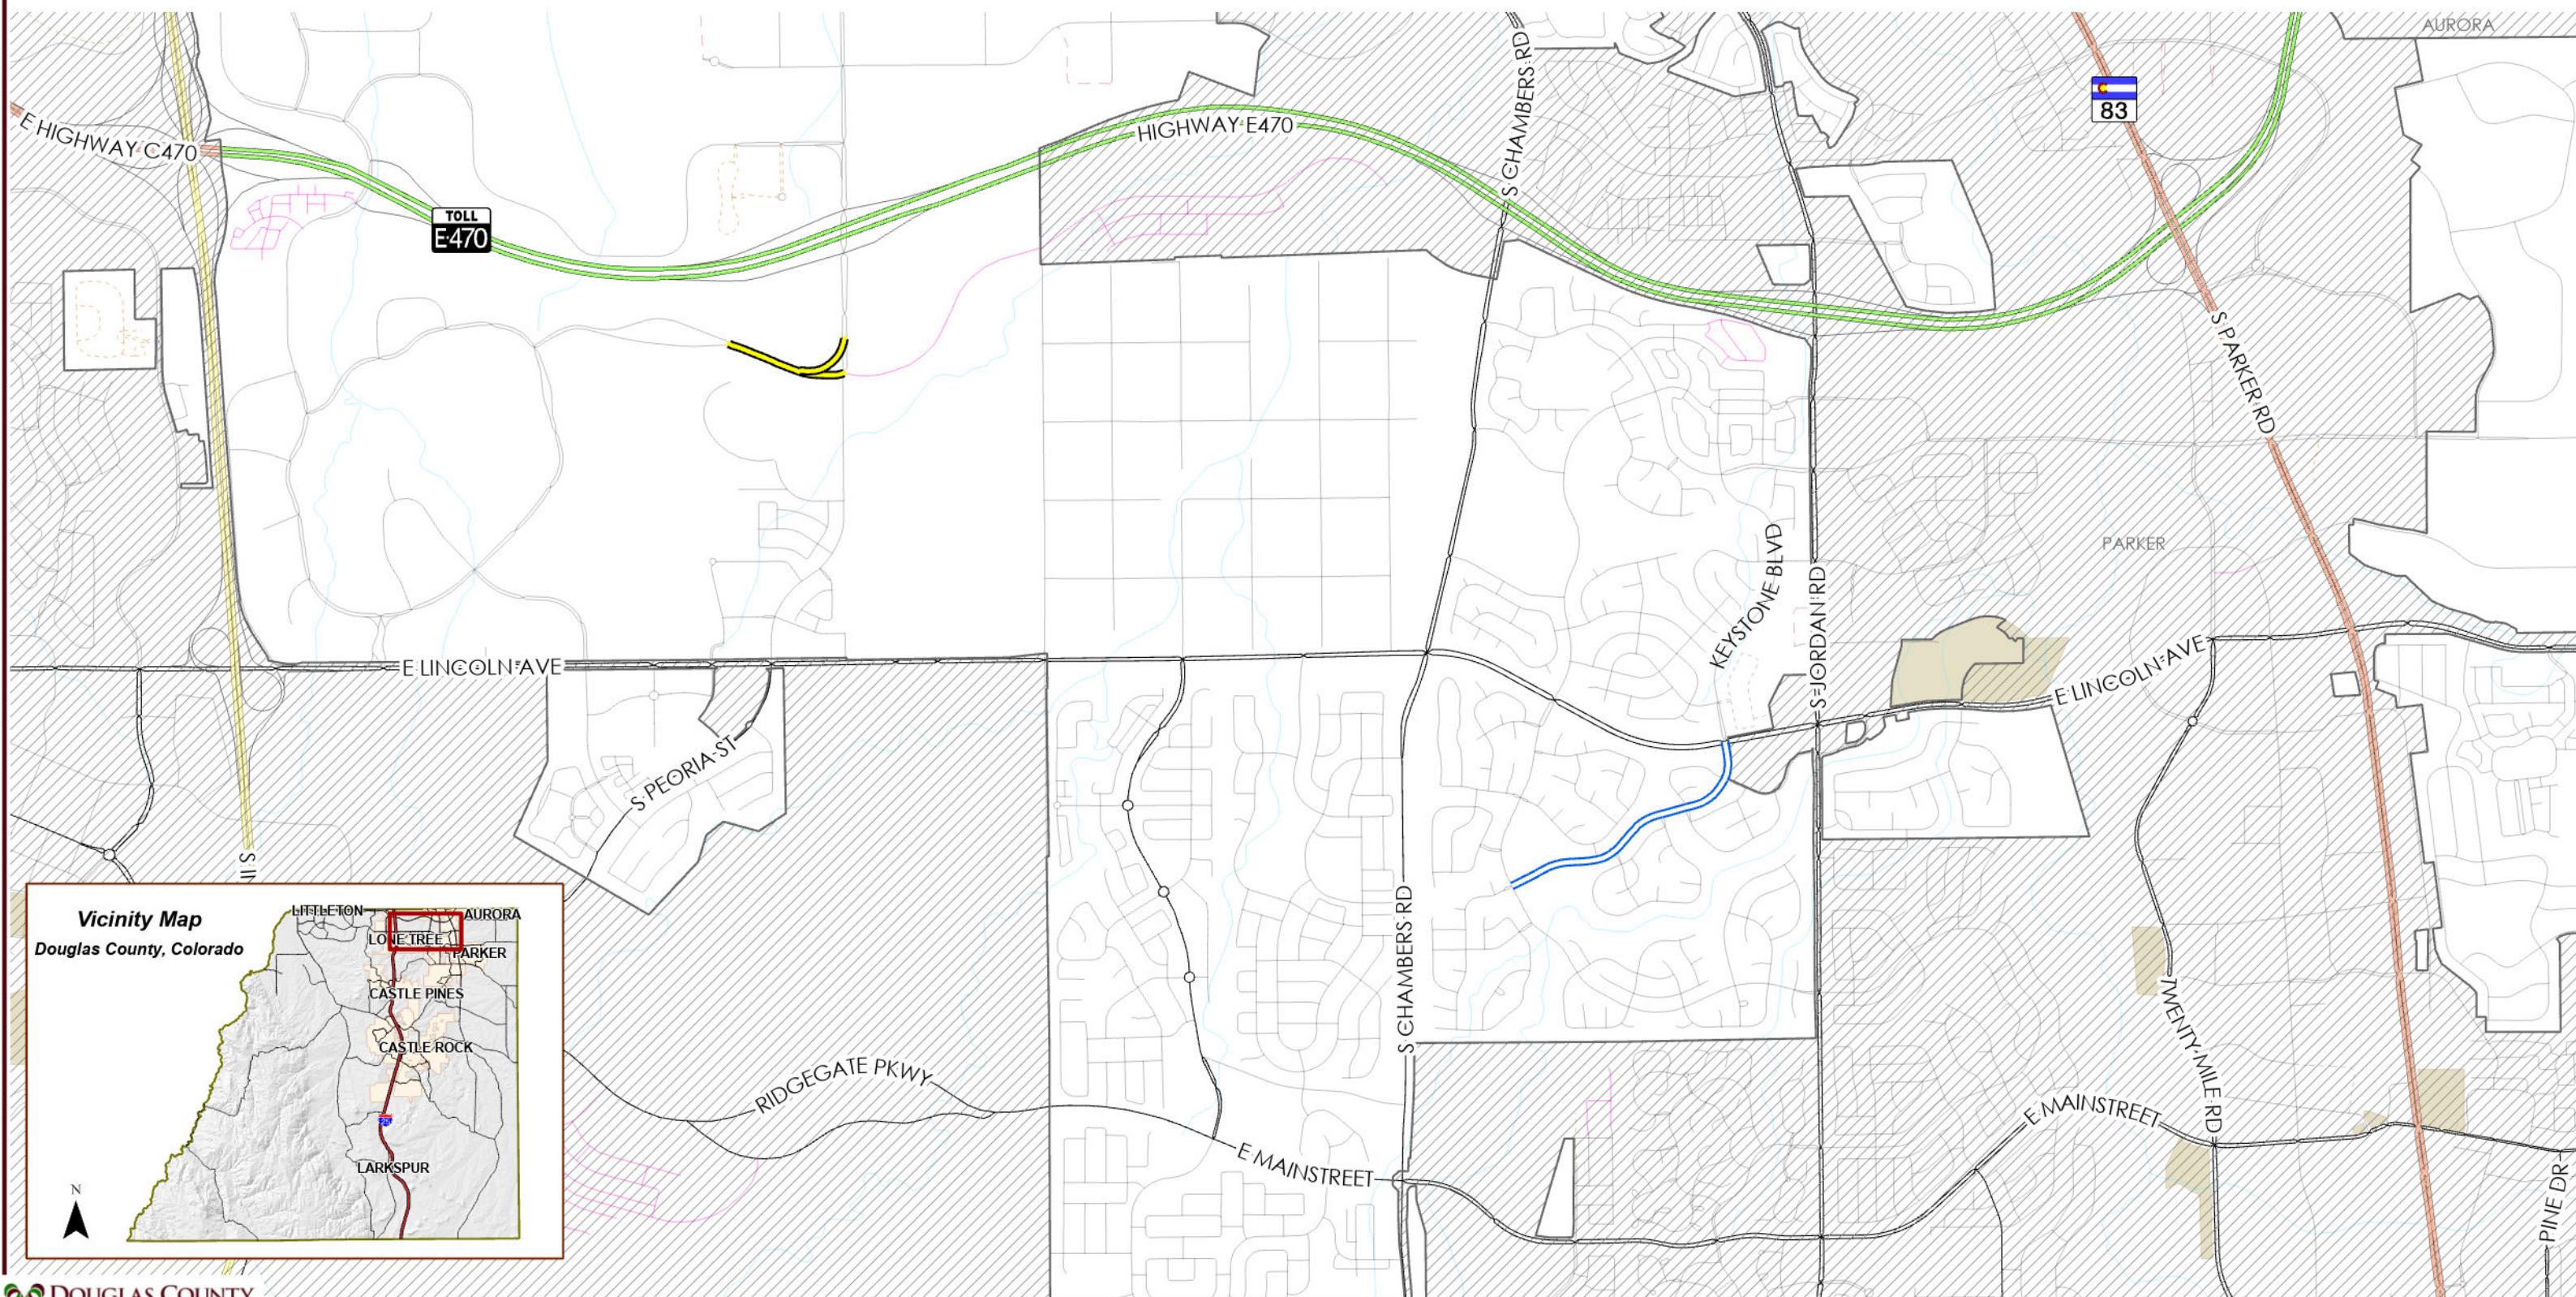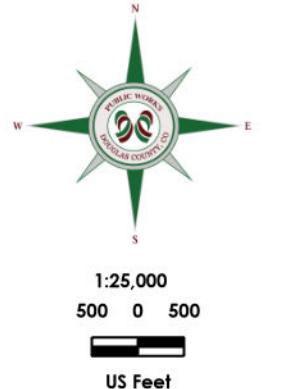



**As Built
2020 Contract Maintenance Projects
Douglas County, Colorado**

- HMA Overlay
- Asphalt Full Depth
- Concrete
- County Boundary
- Municipalities
- Parks
- Intermittent Lakes
- Toll Highway
- Major Road
- Local Road
- Streams
- Roads
- Private
- Gated Community
- Access Easement
- Entrance/Exit Ramp
- State Highway
- Platted Not Built

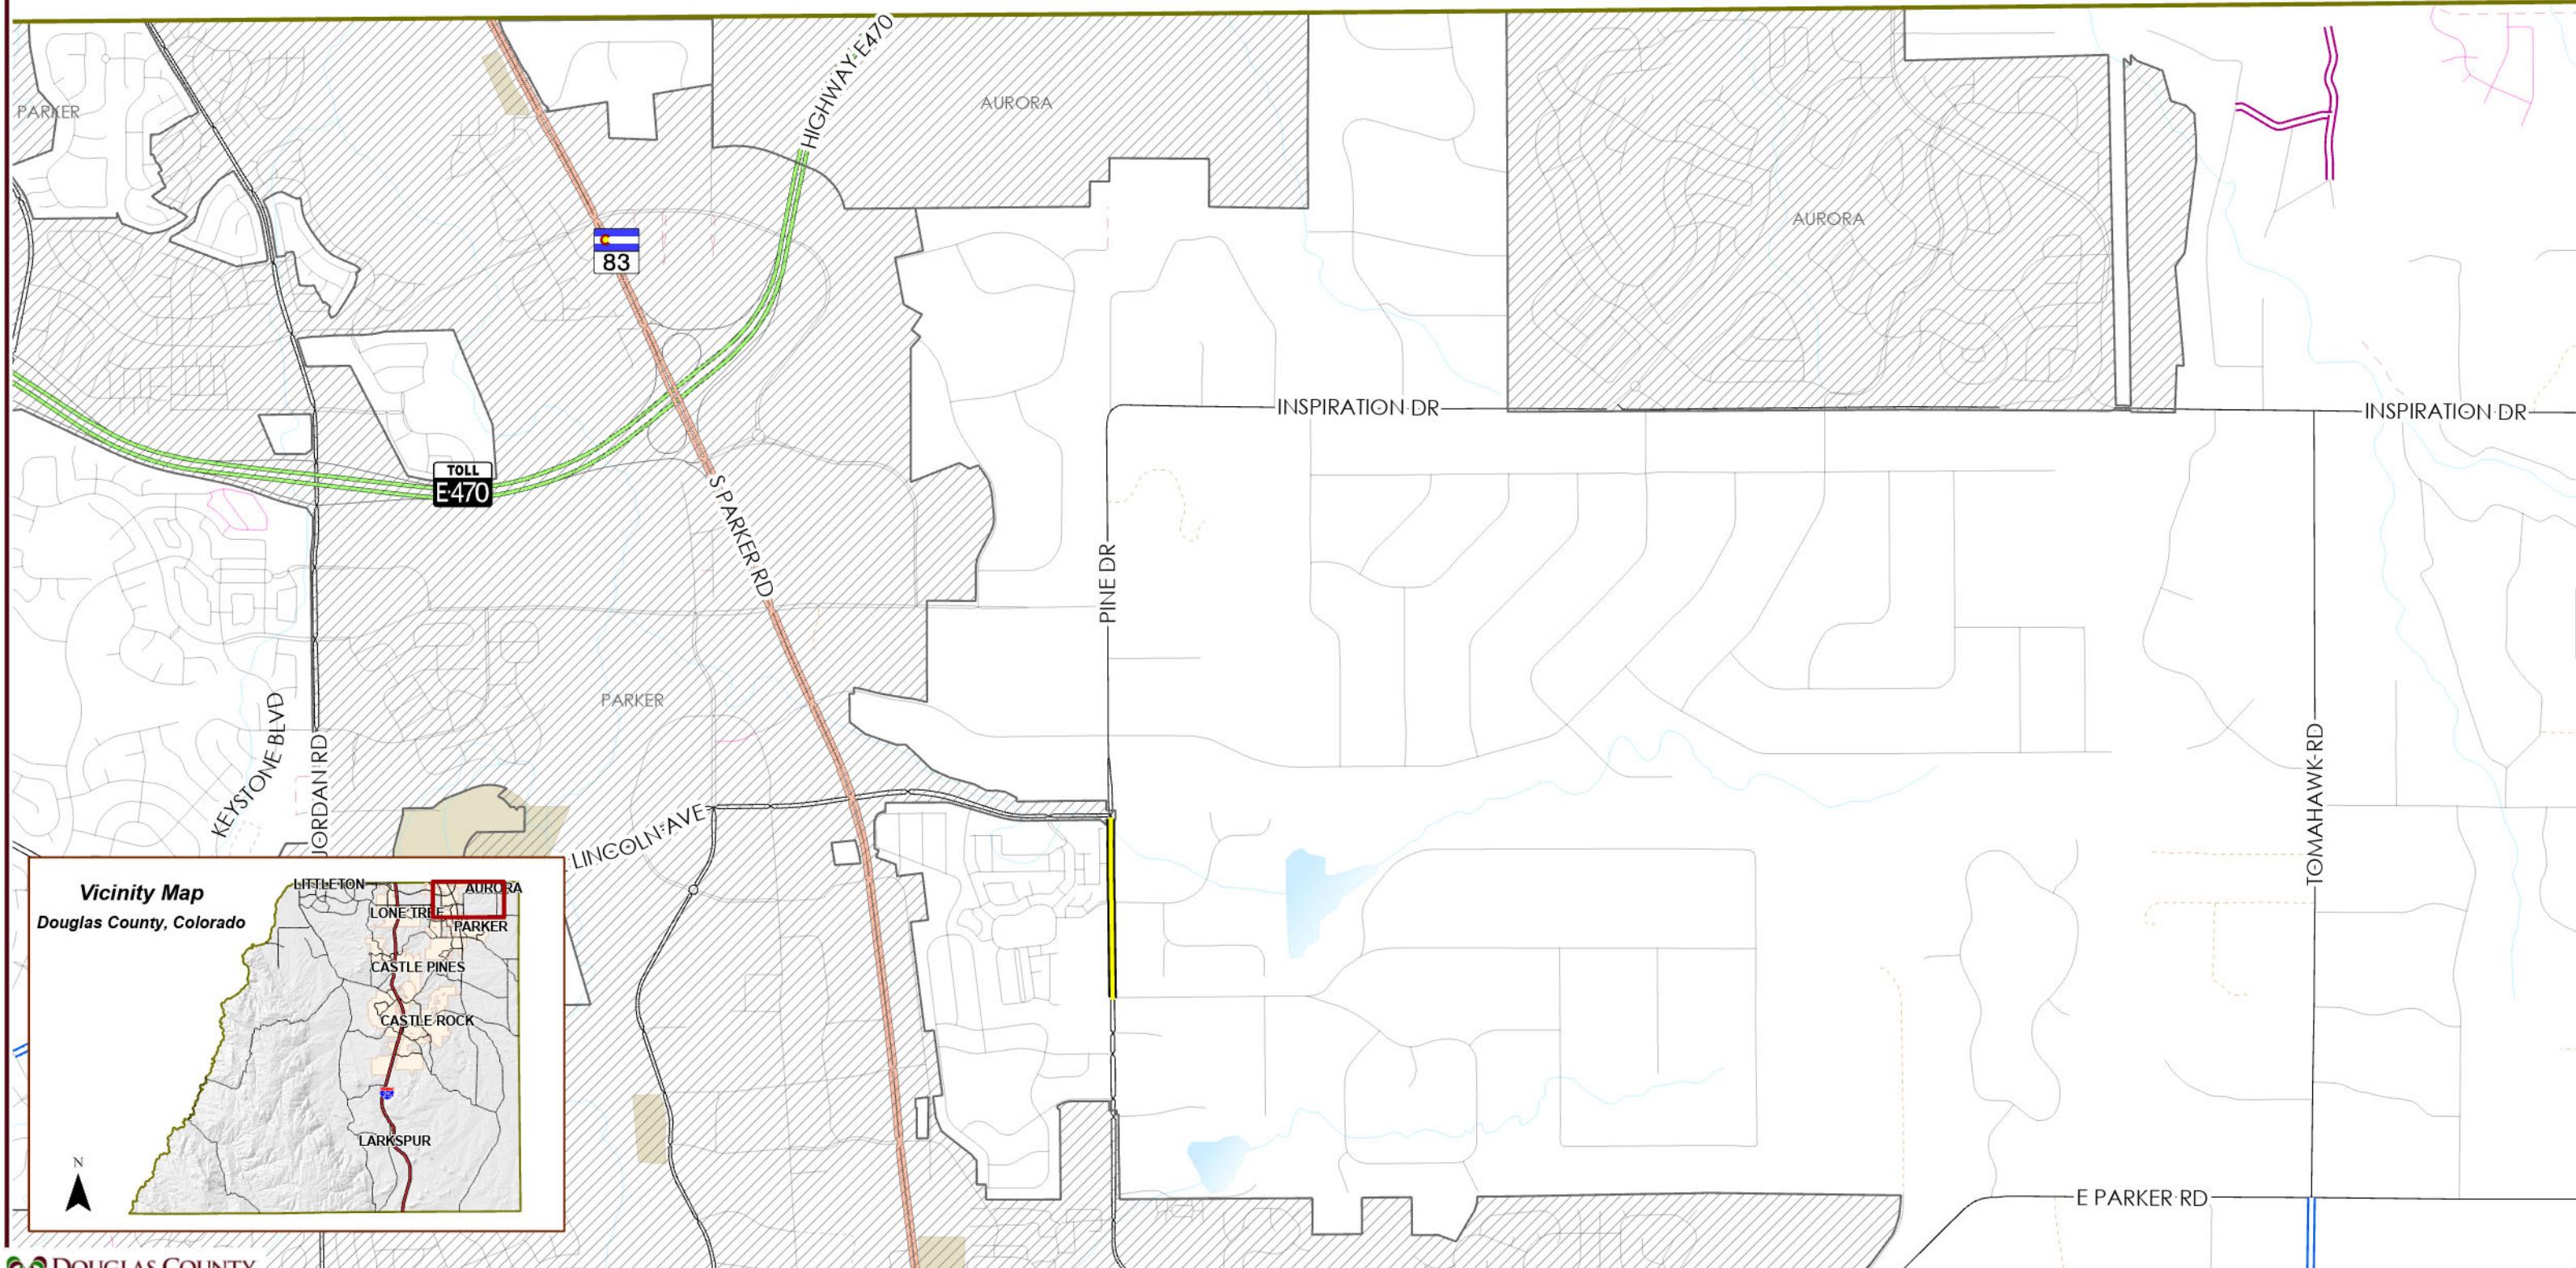



**As Built
2020 Contract Maintenance Projects
Douglas County, Colorado**

- HMA Overlay
- County Boundary
- Municipalities
- Parks
- Intermittent Lakes
- Streams
- Roads
- State Highway
- Major Road
- Local Road
- Private
- Platted Not Built
- Gated Community
- Access Easement

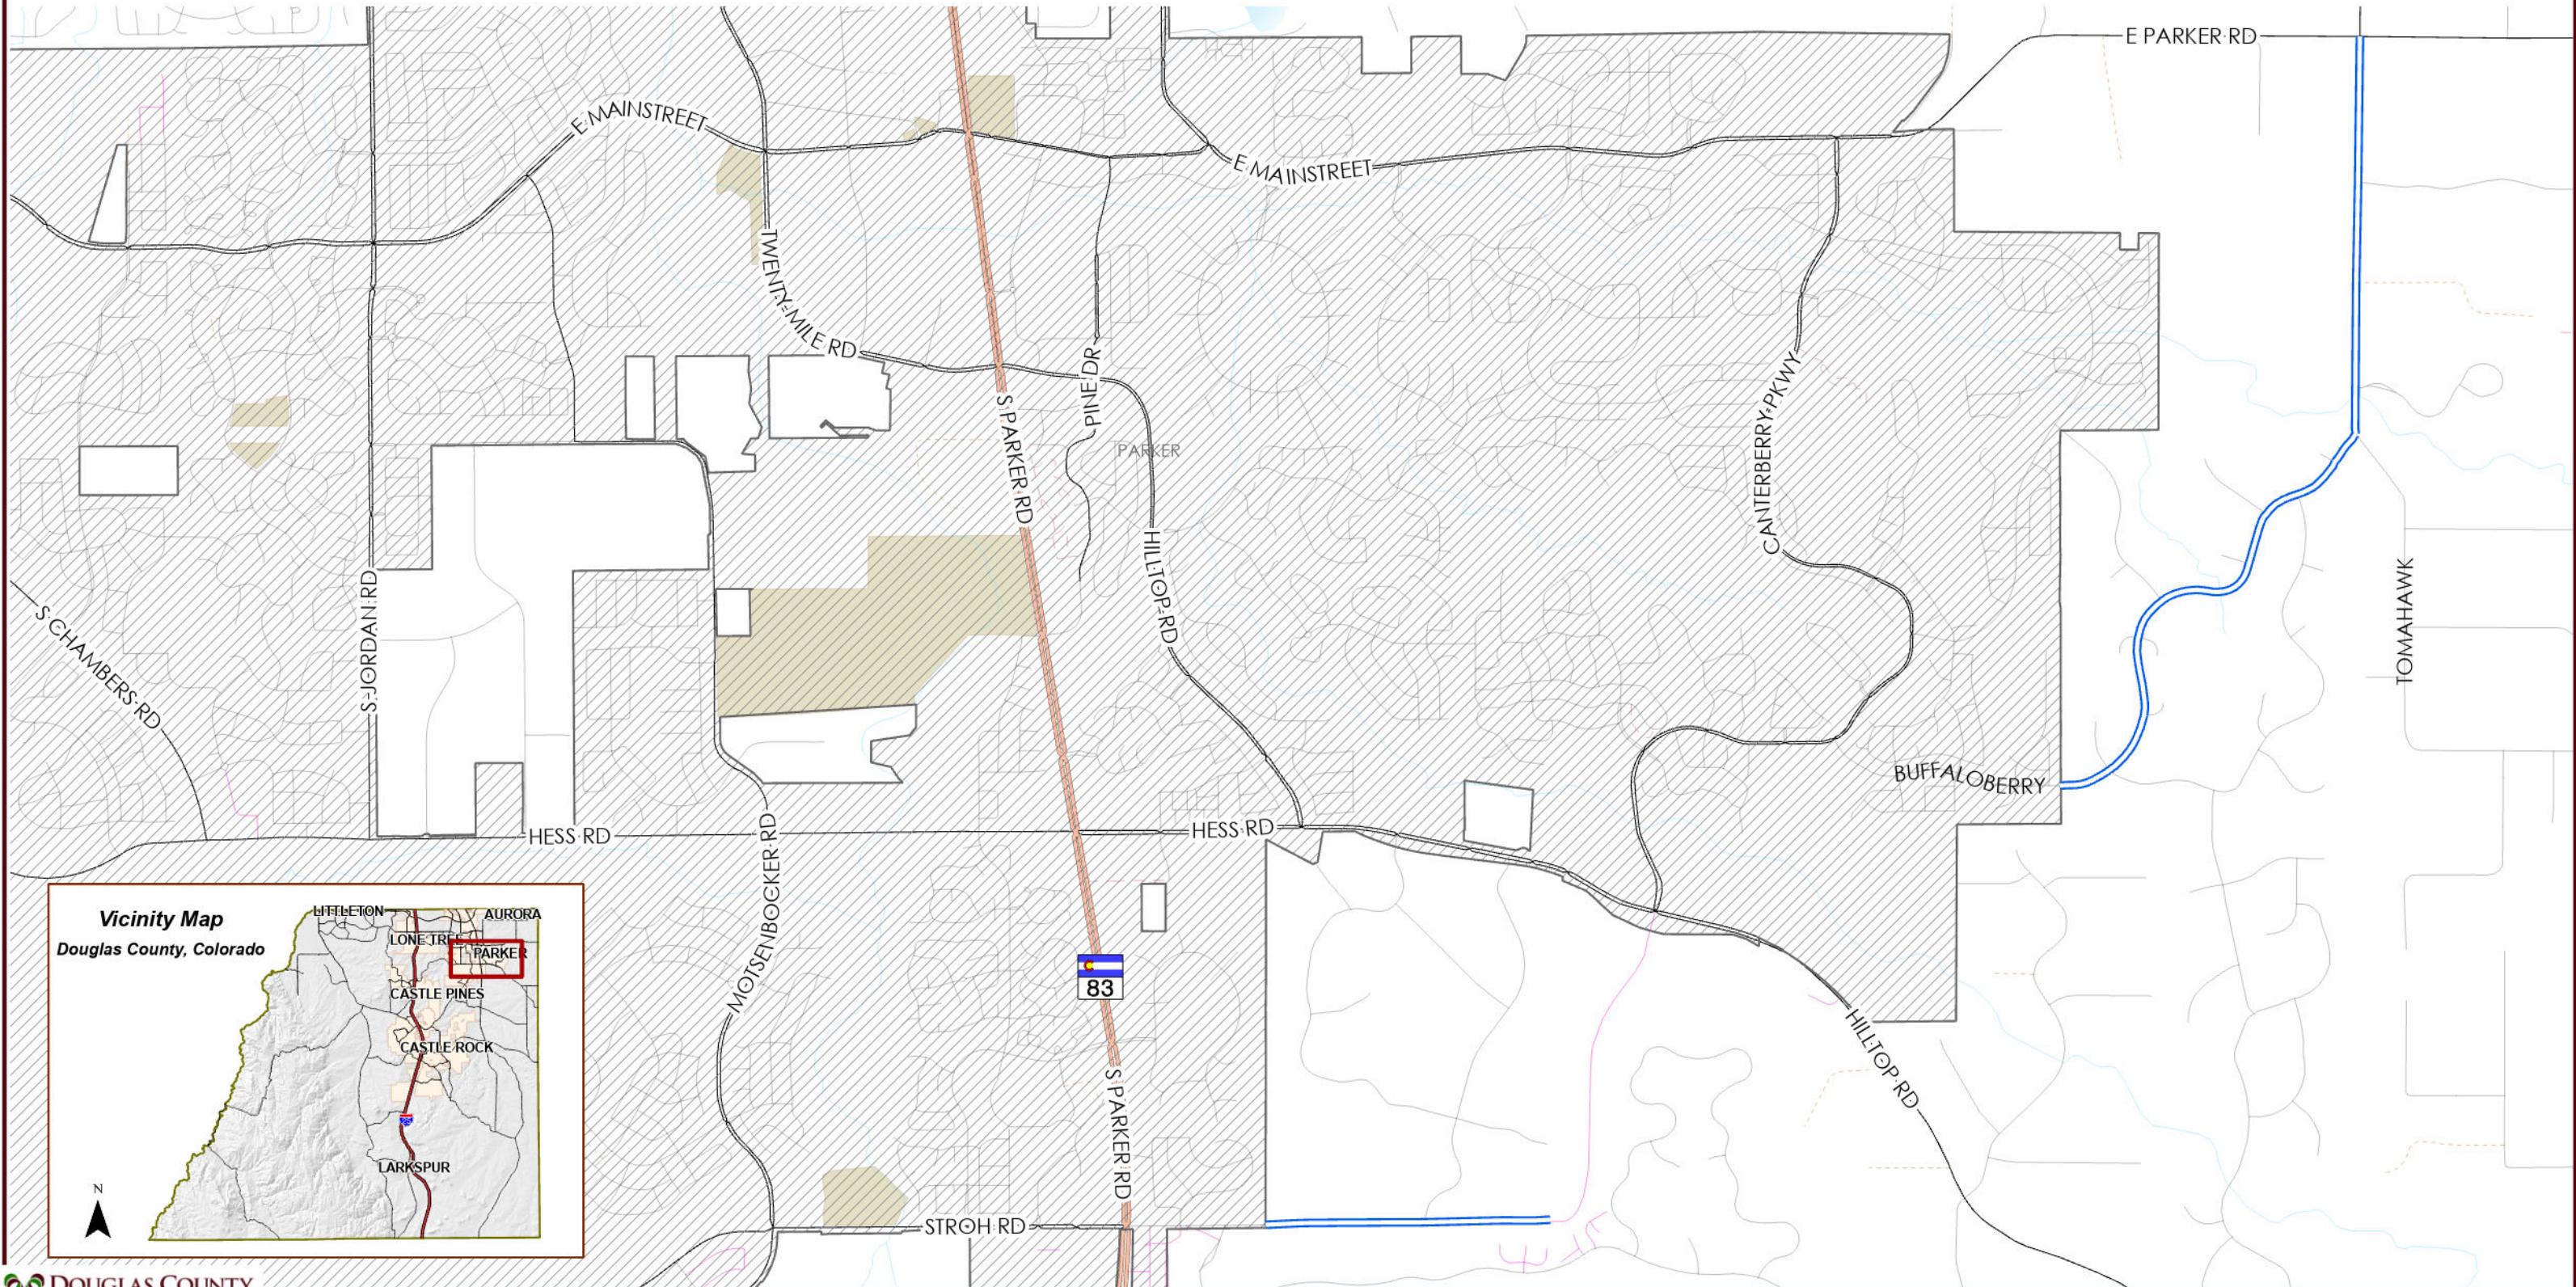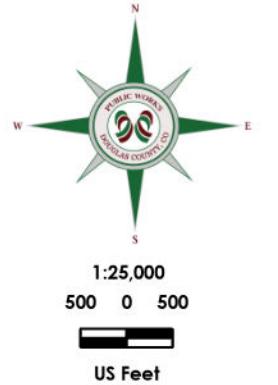



**As Built
2020 Contract Maintenance Projects
Douglas County, Colorado**

- HMA Overlay
- County Boundary
- Municipalities
- Parks
- Lakes
- Intermittent Lakes
- Streams
- Roads
- State Highway
- Major Road
- Local Road
- Private
- Platted Not Built
- Access Easement

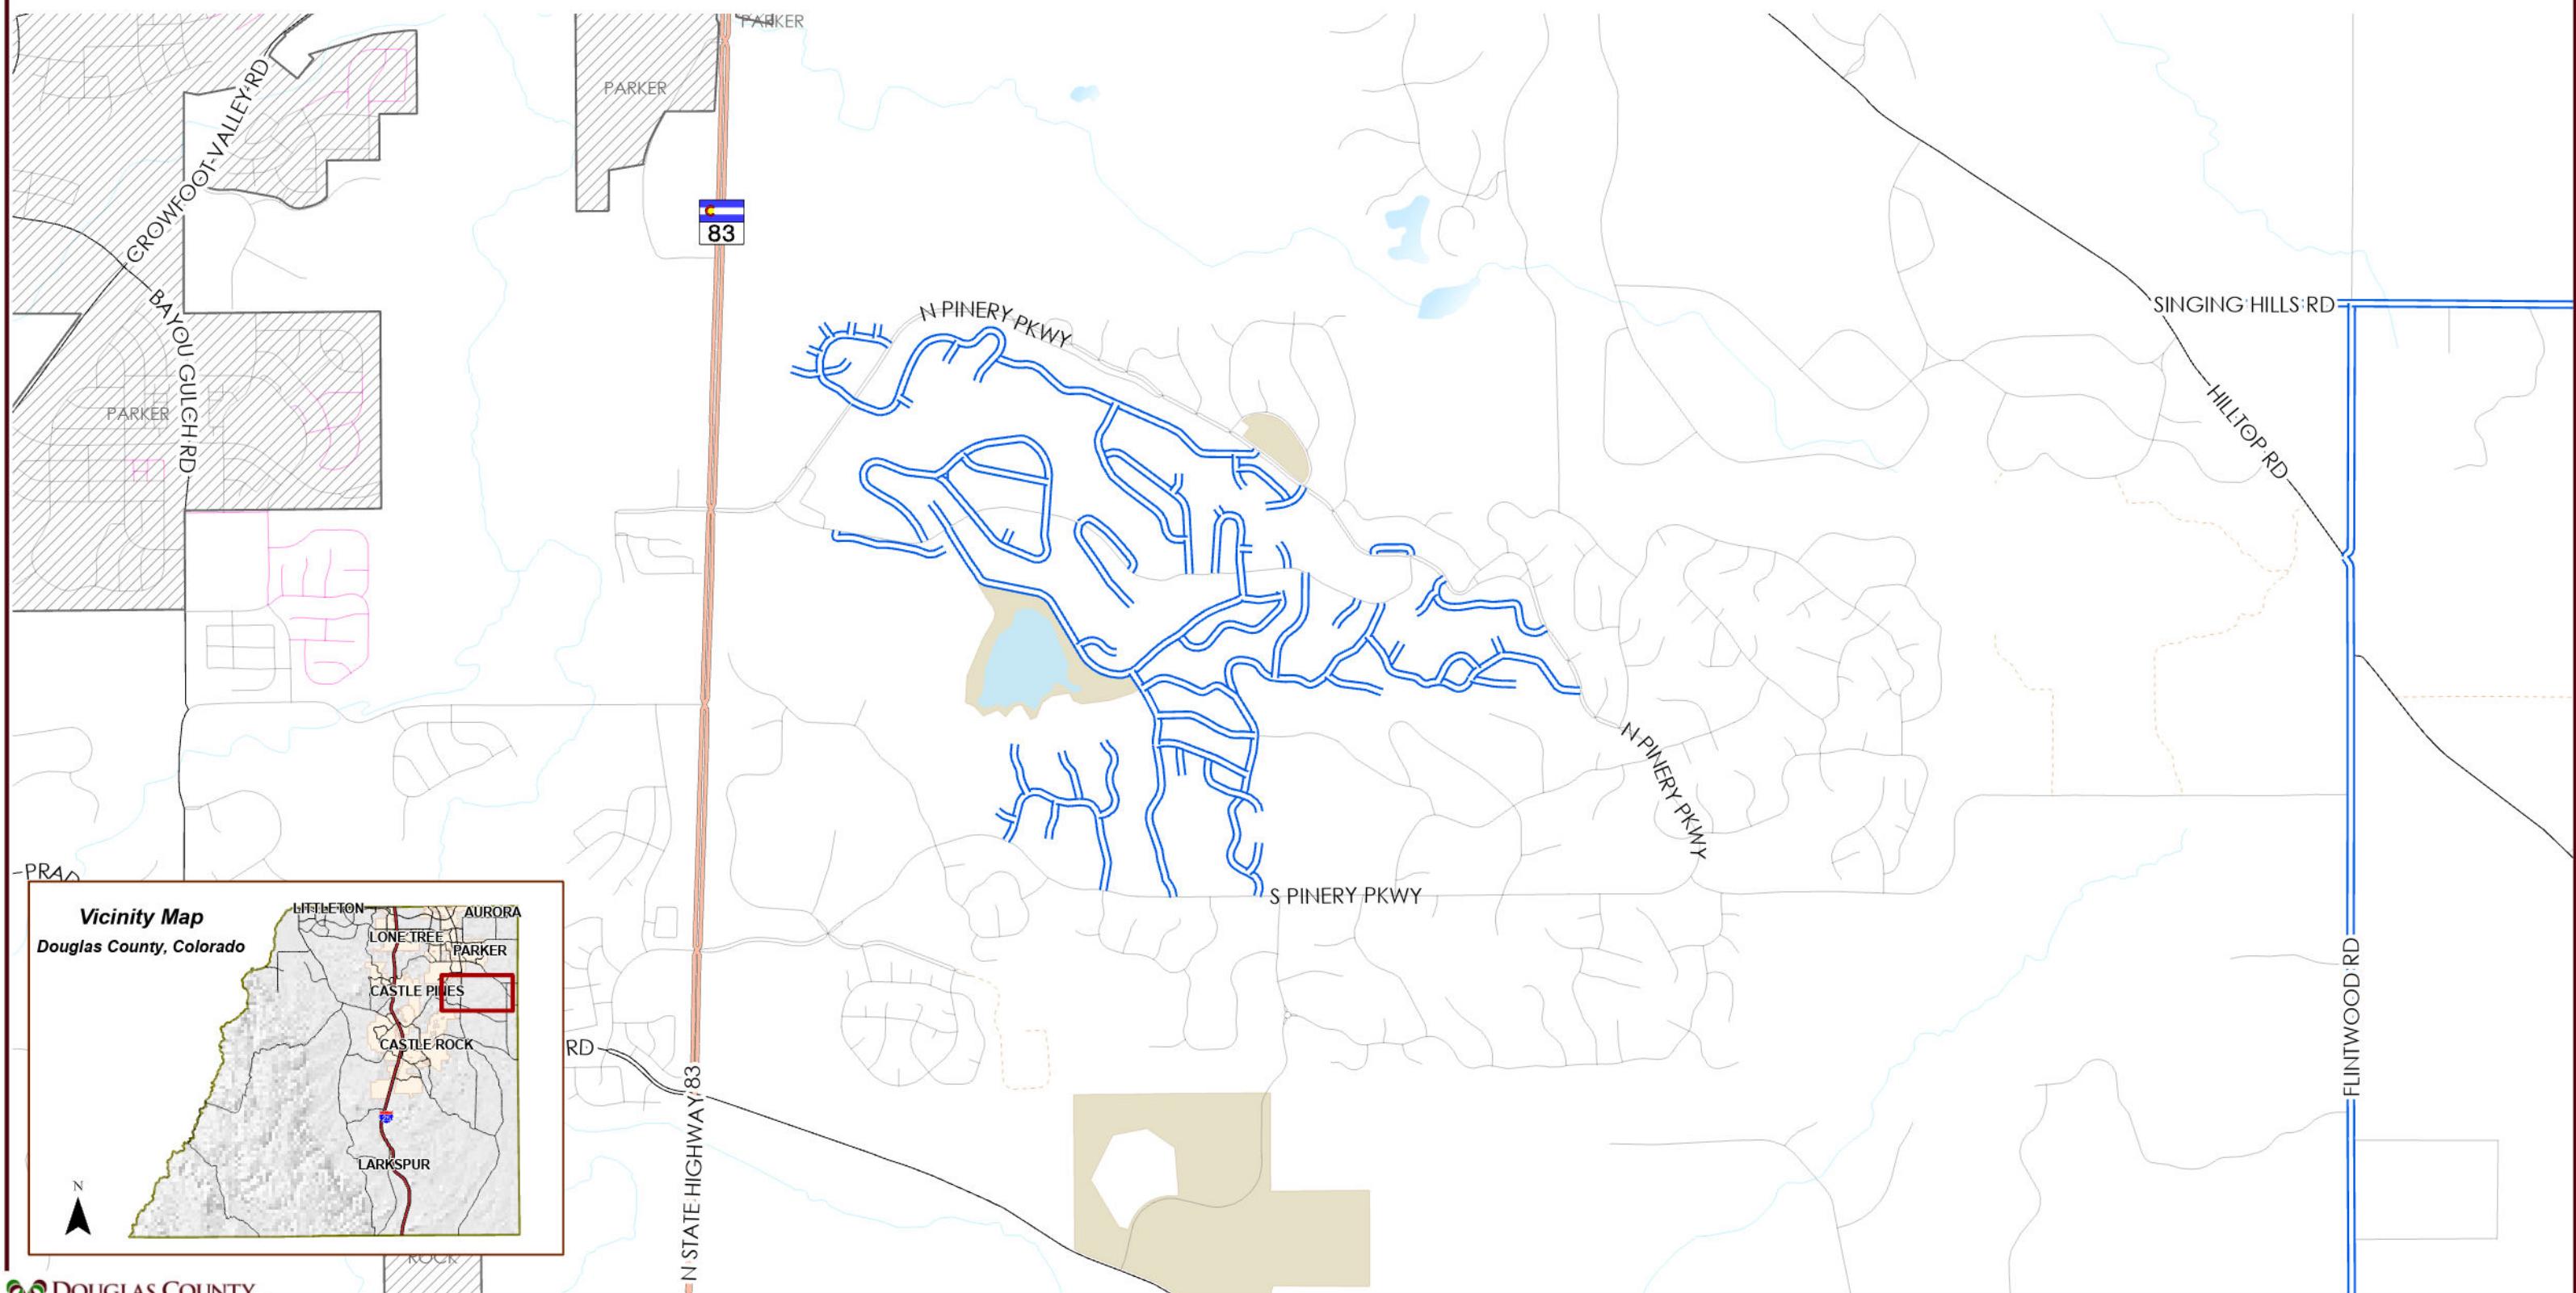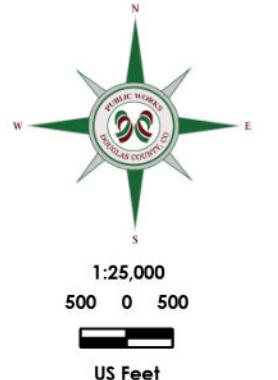




**As Built
2020 Contract Maintenance Projects
Douglas County, Colorado**

	HMA Overlay		Intermittent Lakes		Major Road		Access Easement
	County Boundary		Streams		Local Road		Entrance/Exit Ramp
	Municipalities		Roads		Private		Platted Not Built
	Parks		Interstate		State Highway		Gated Community
	Lakes						

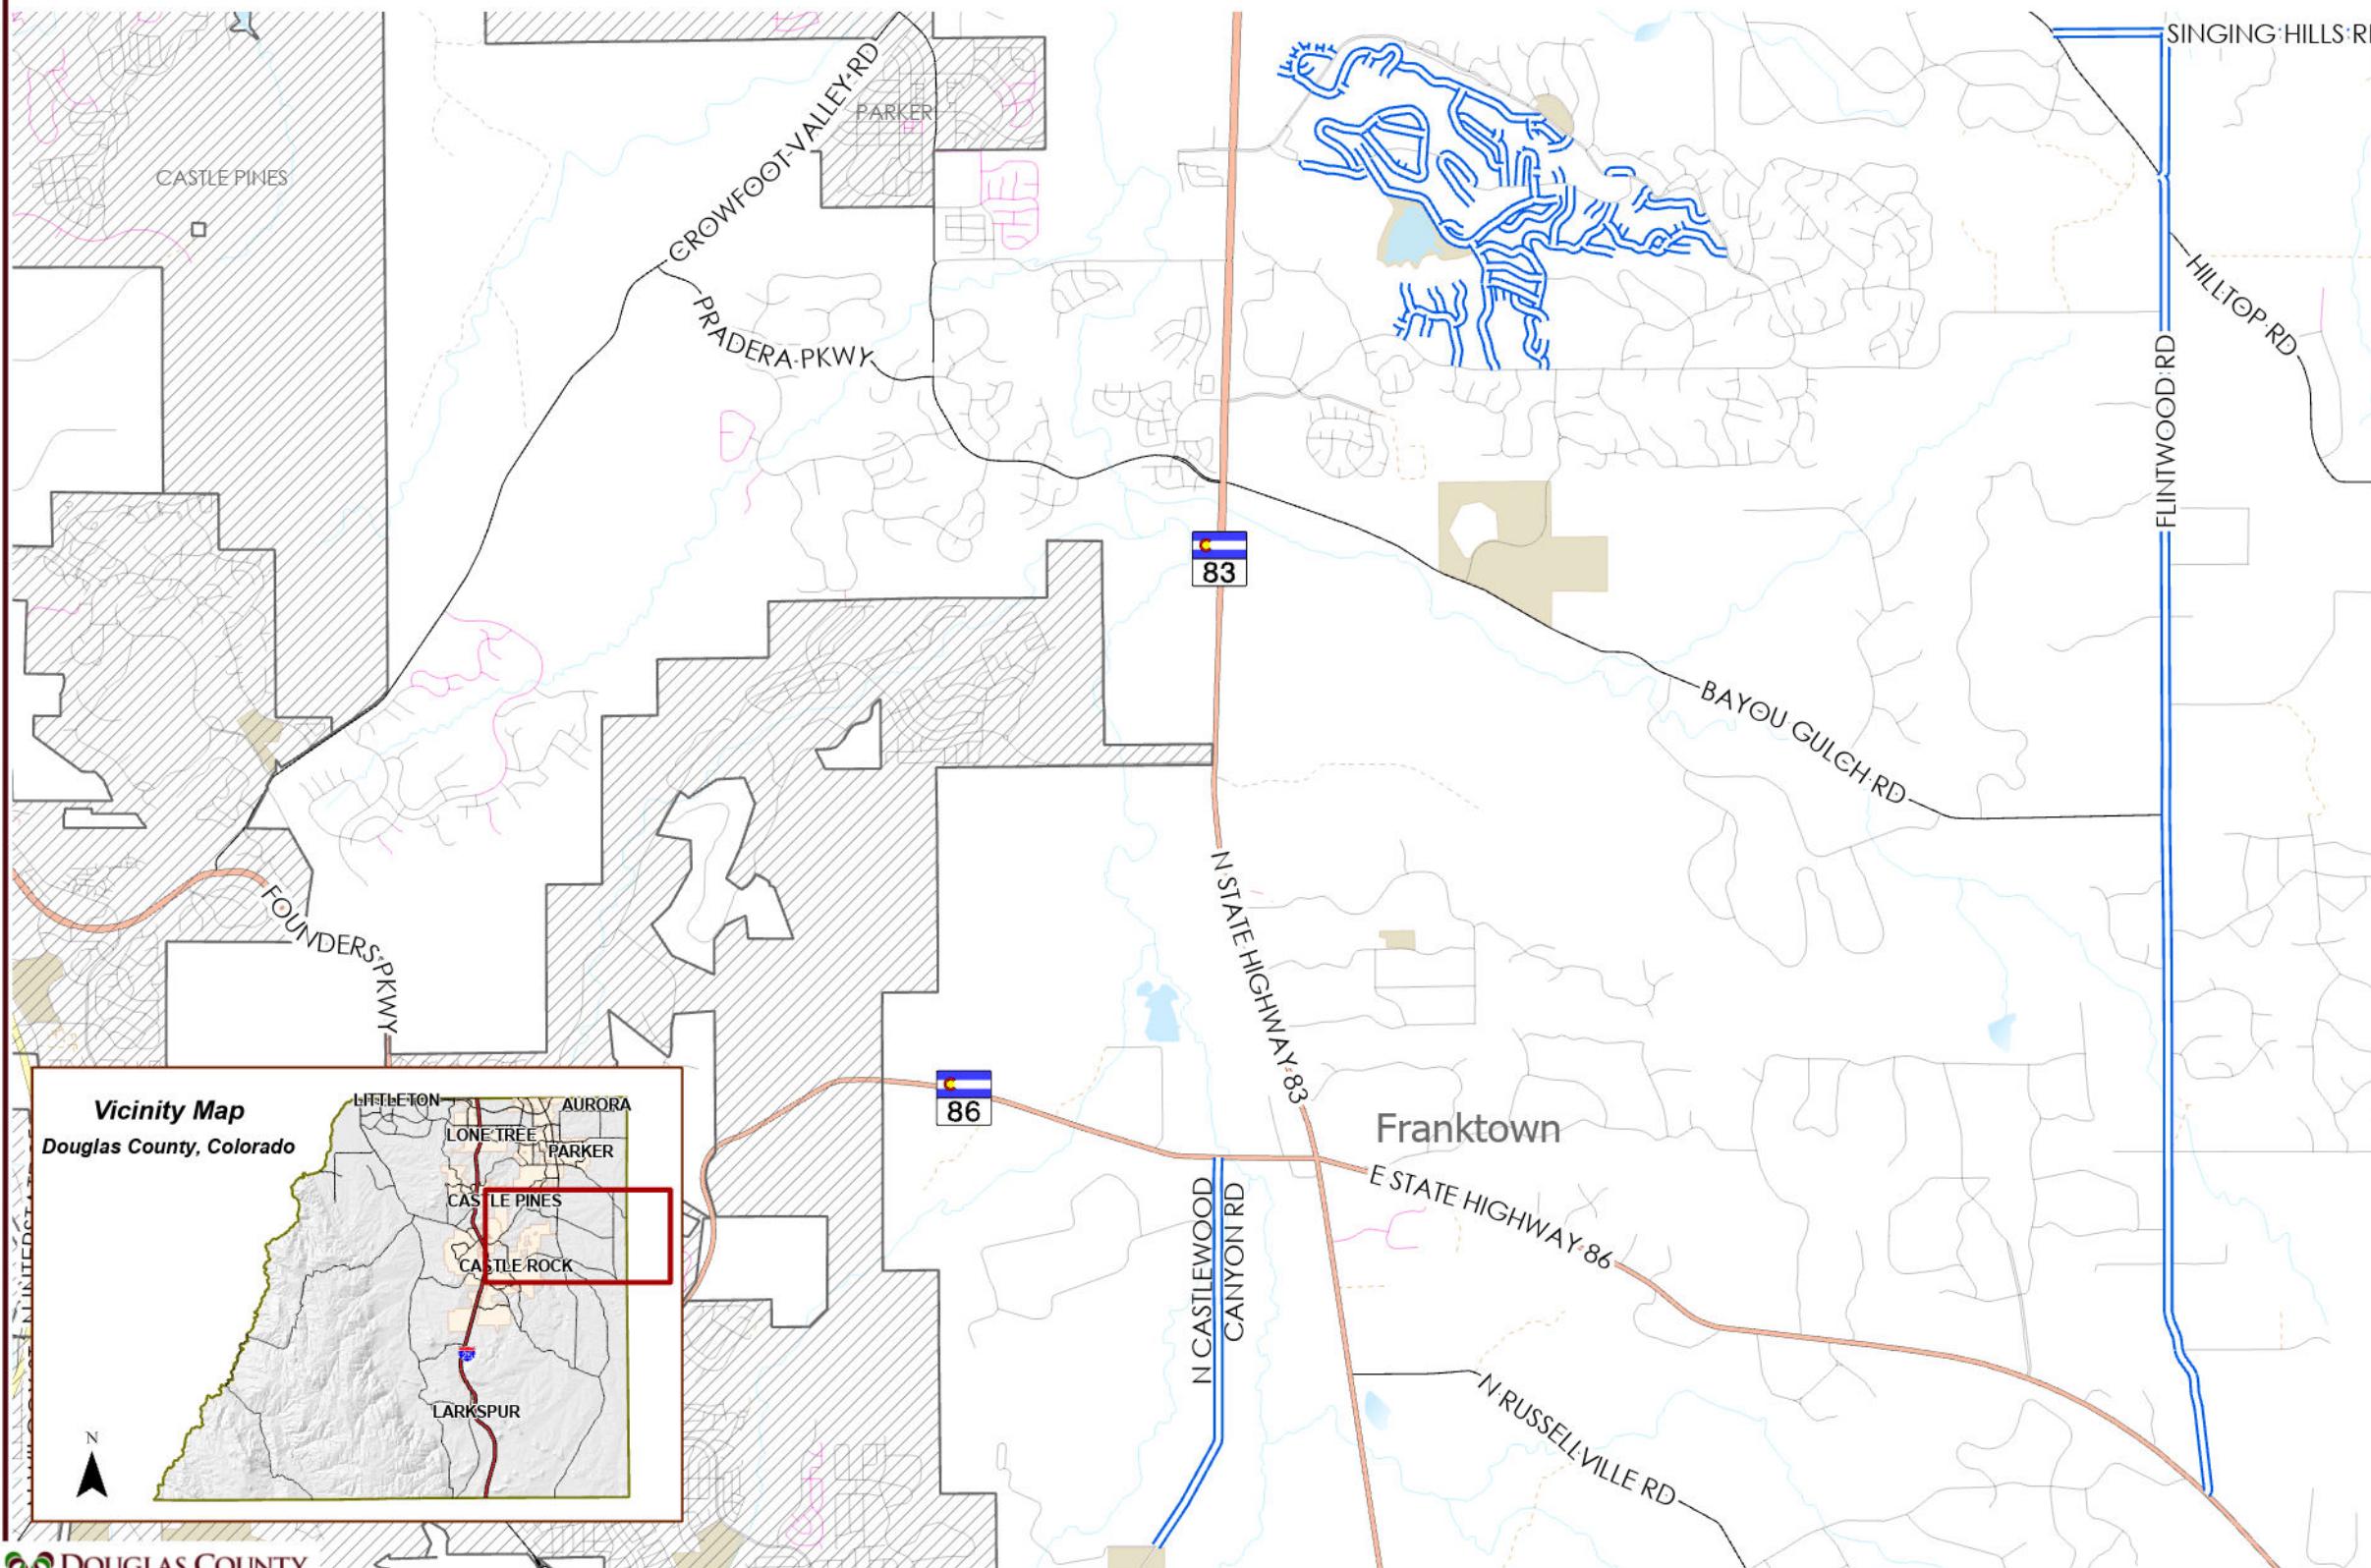
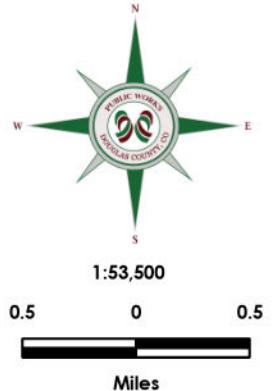


**As Built
2020 Contract Maintenance Projects
Douglas County, Colorado**

 Asphalt Full Depth Roads
 County Boundary State Highway
 Intermittent Lakes Major Road
 Streams Local Road

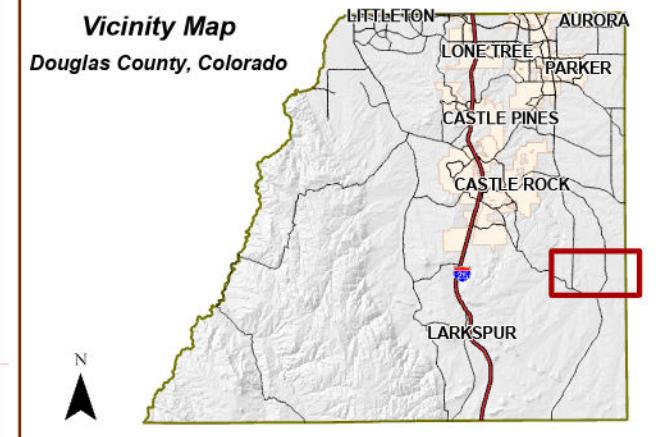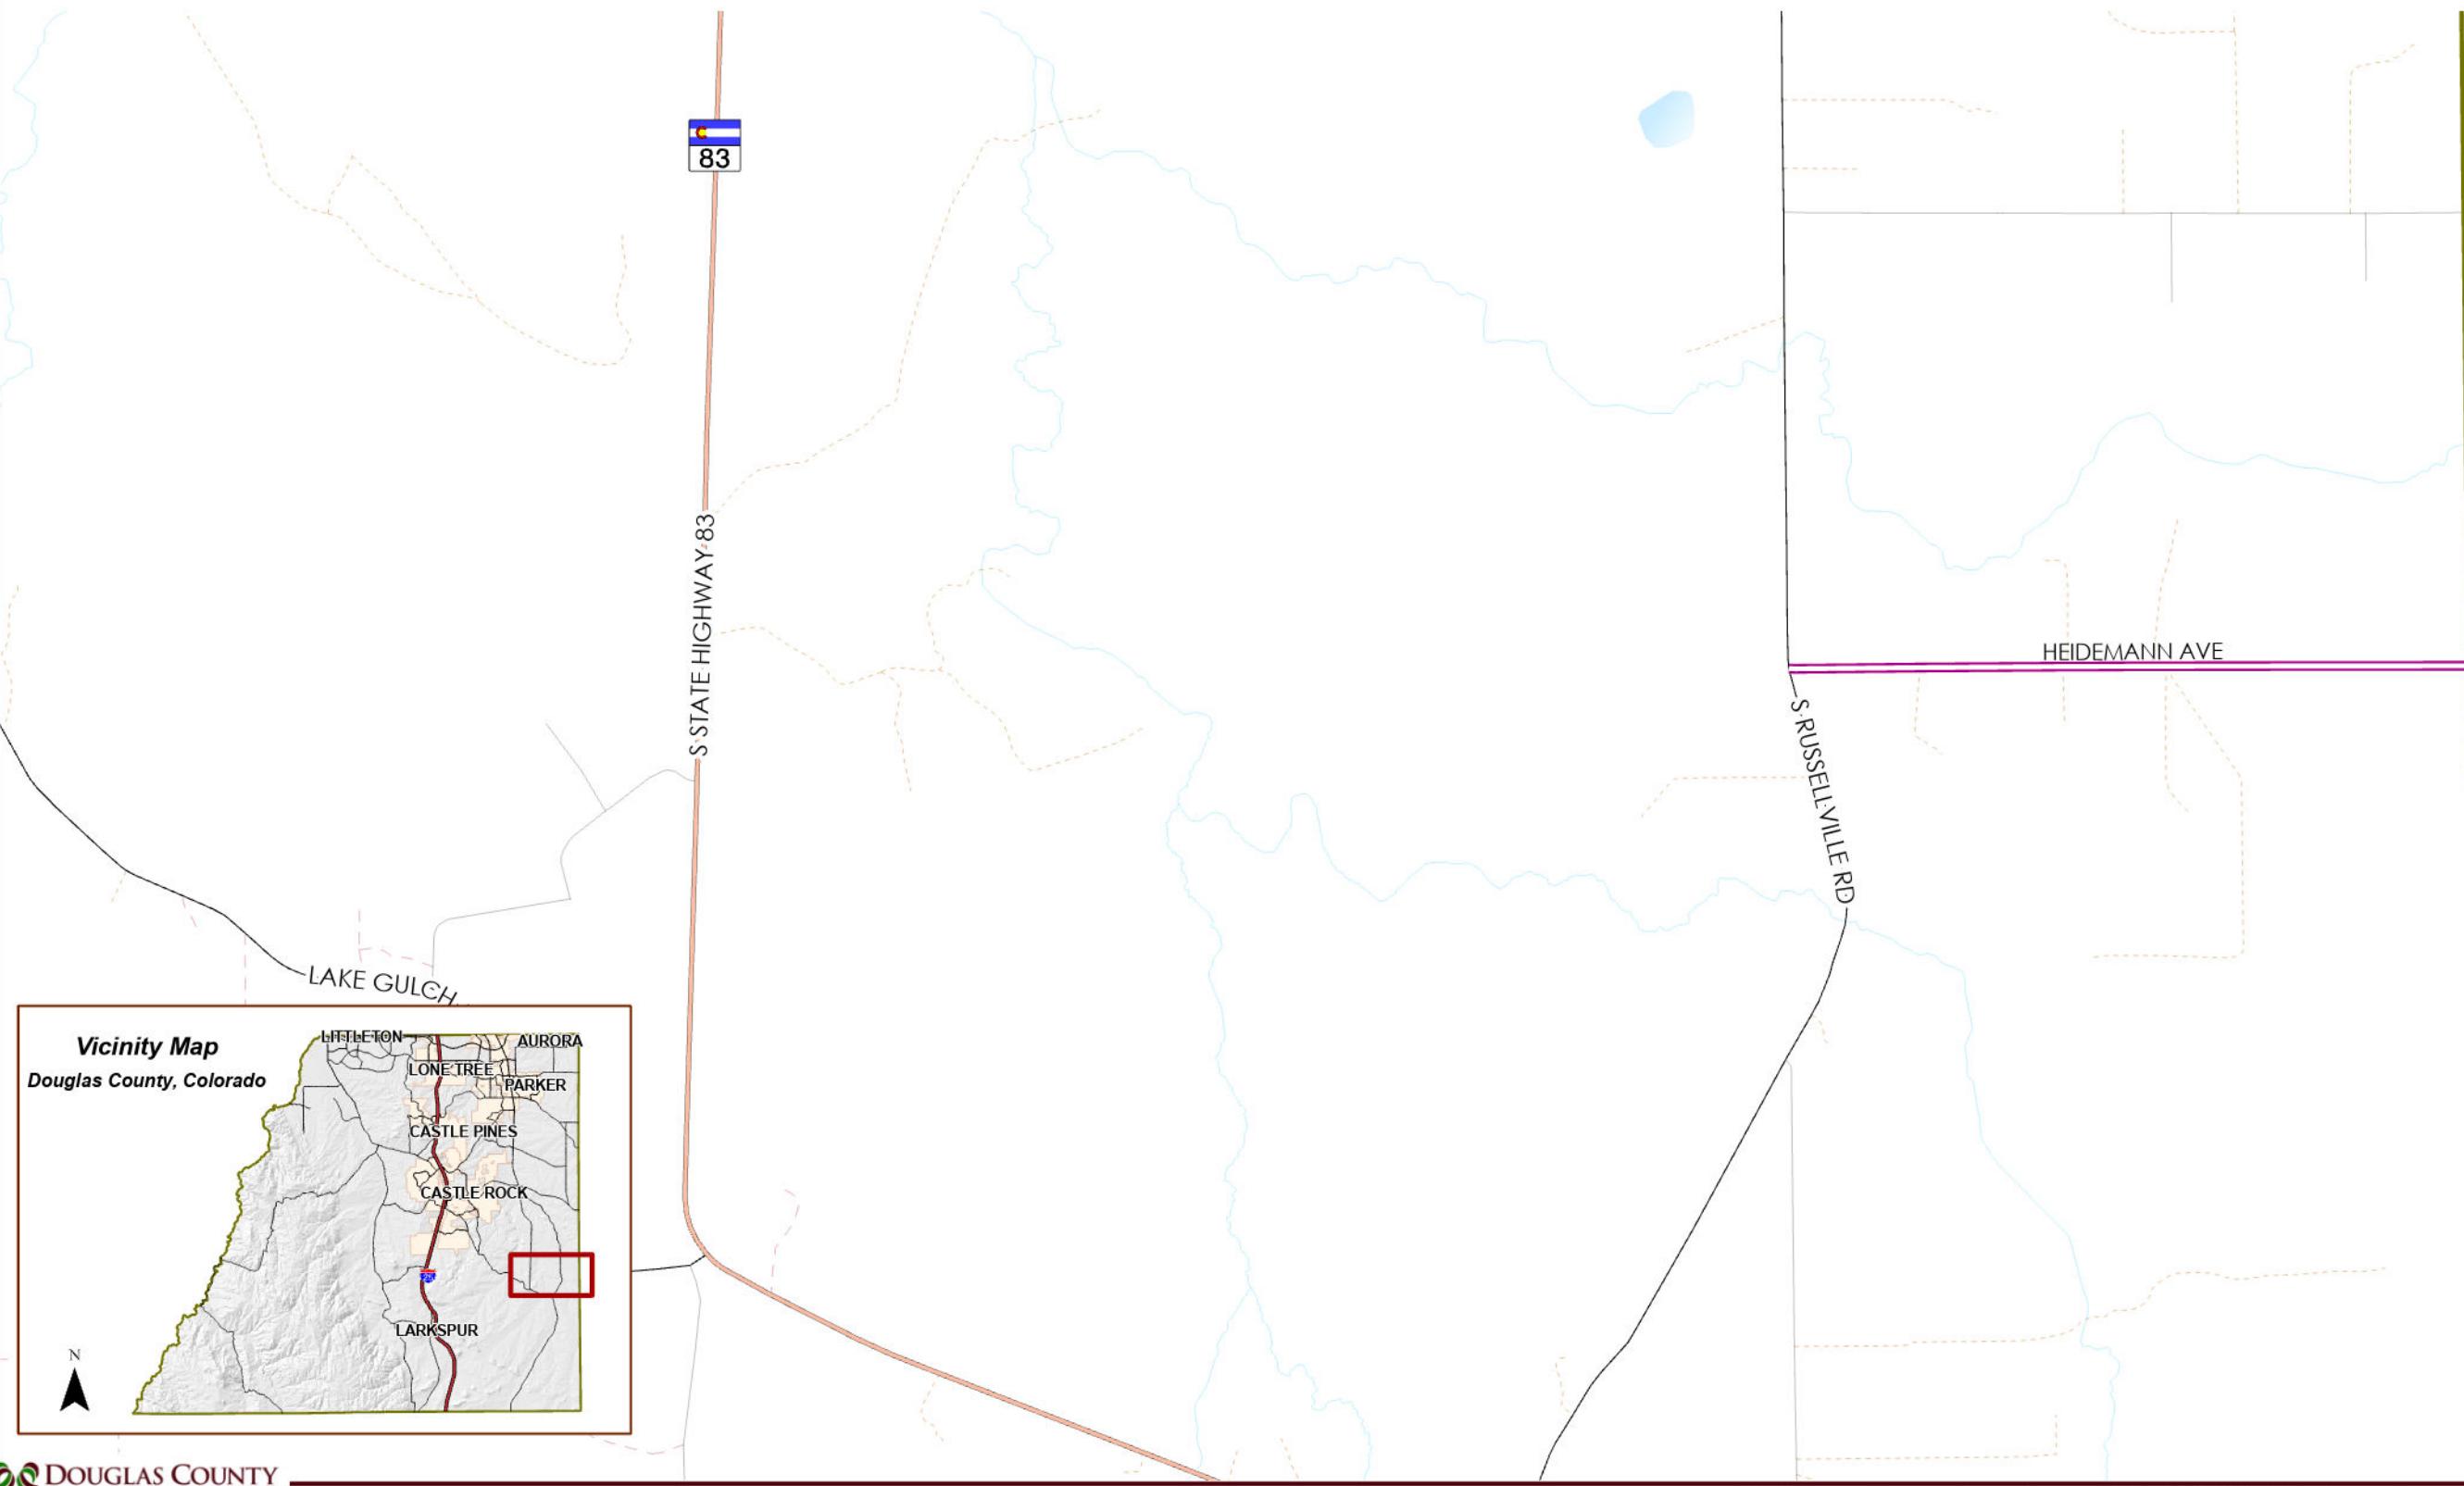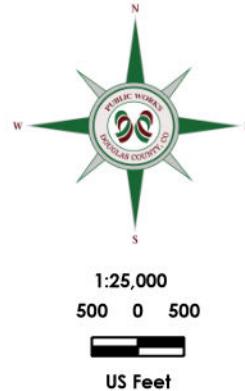

As Built 2020 Contract Maintenance Projects Douglas County, Colorado

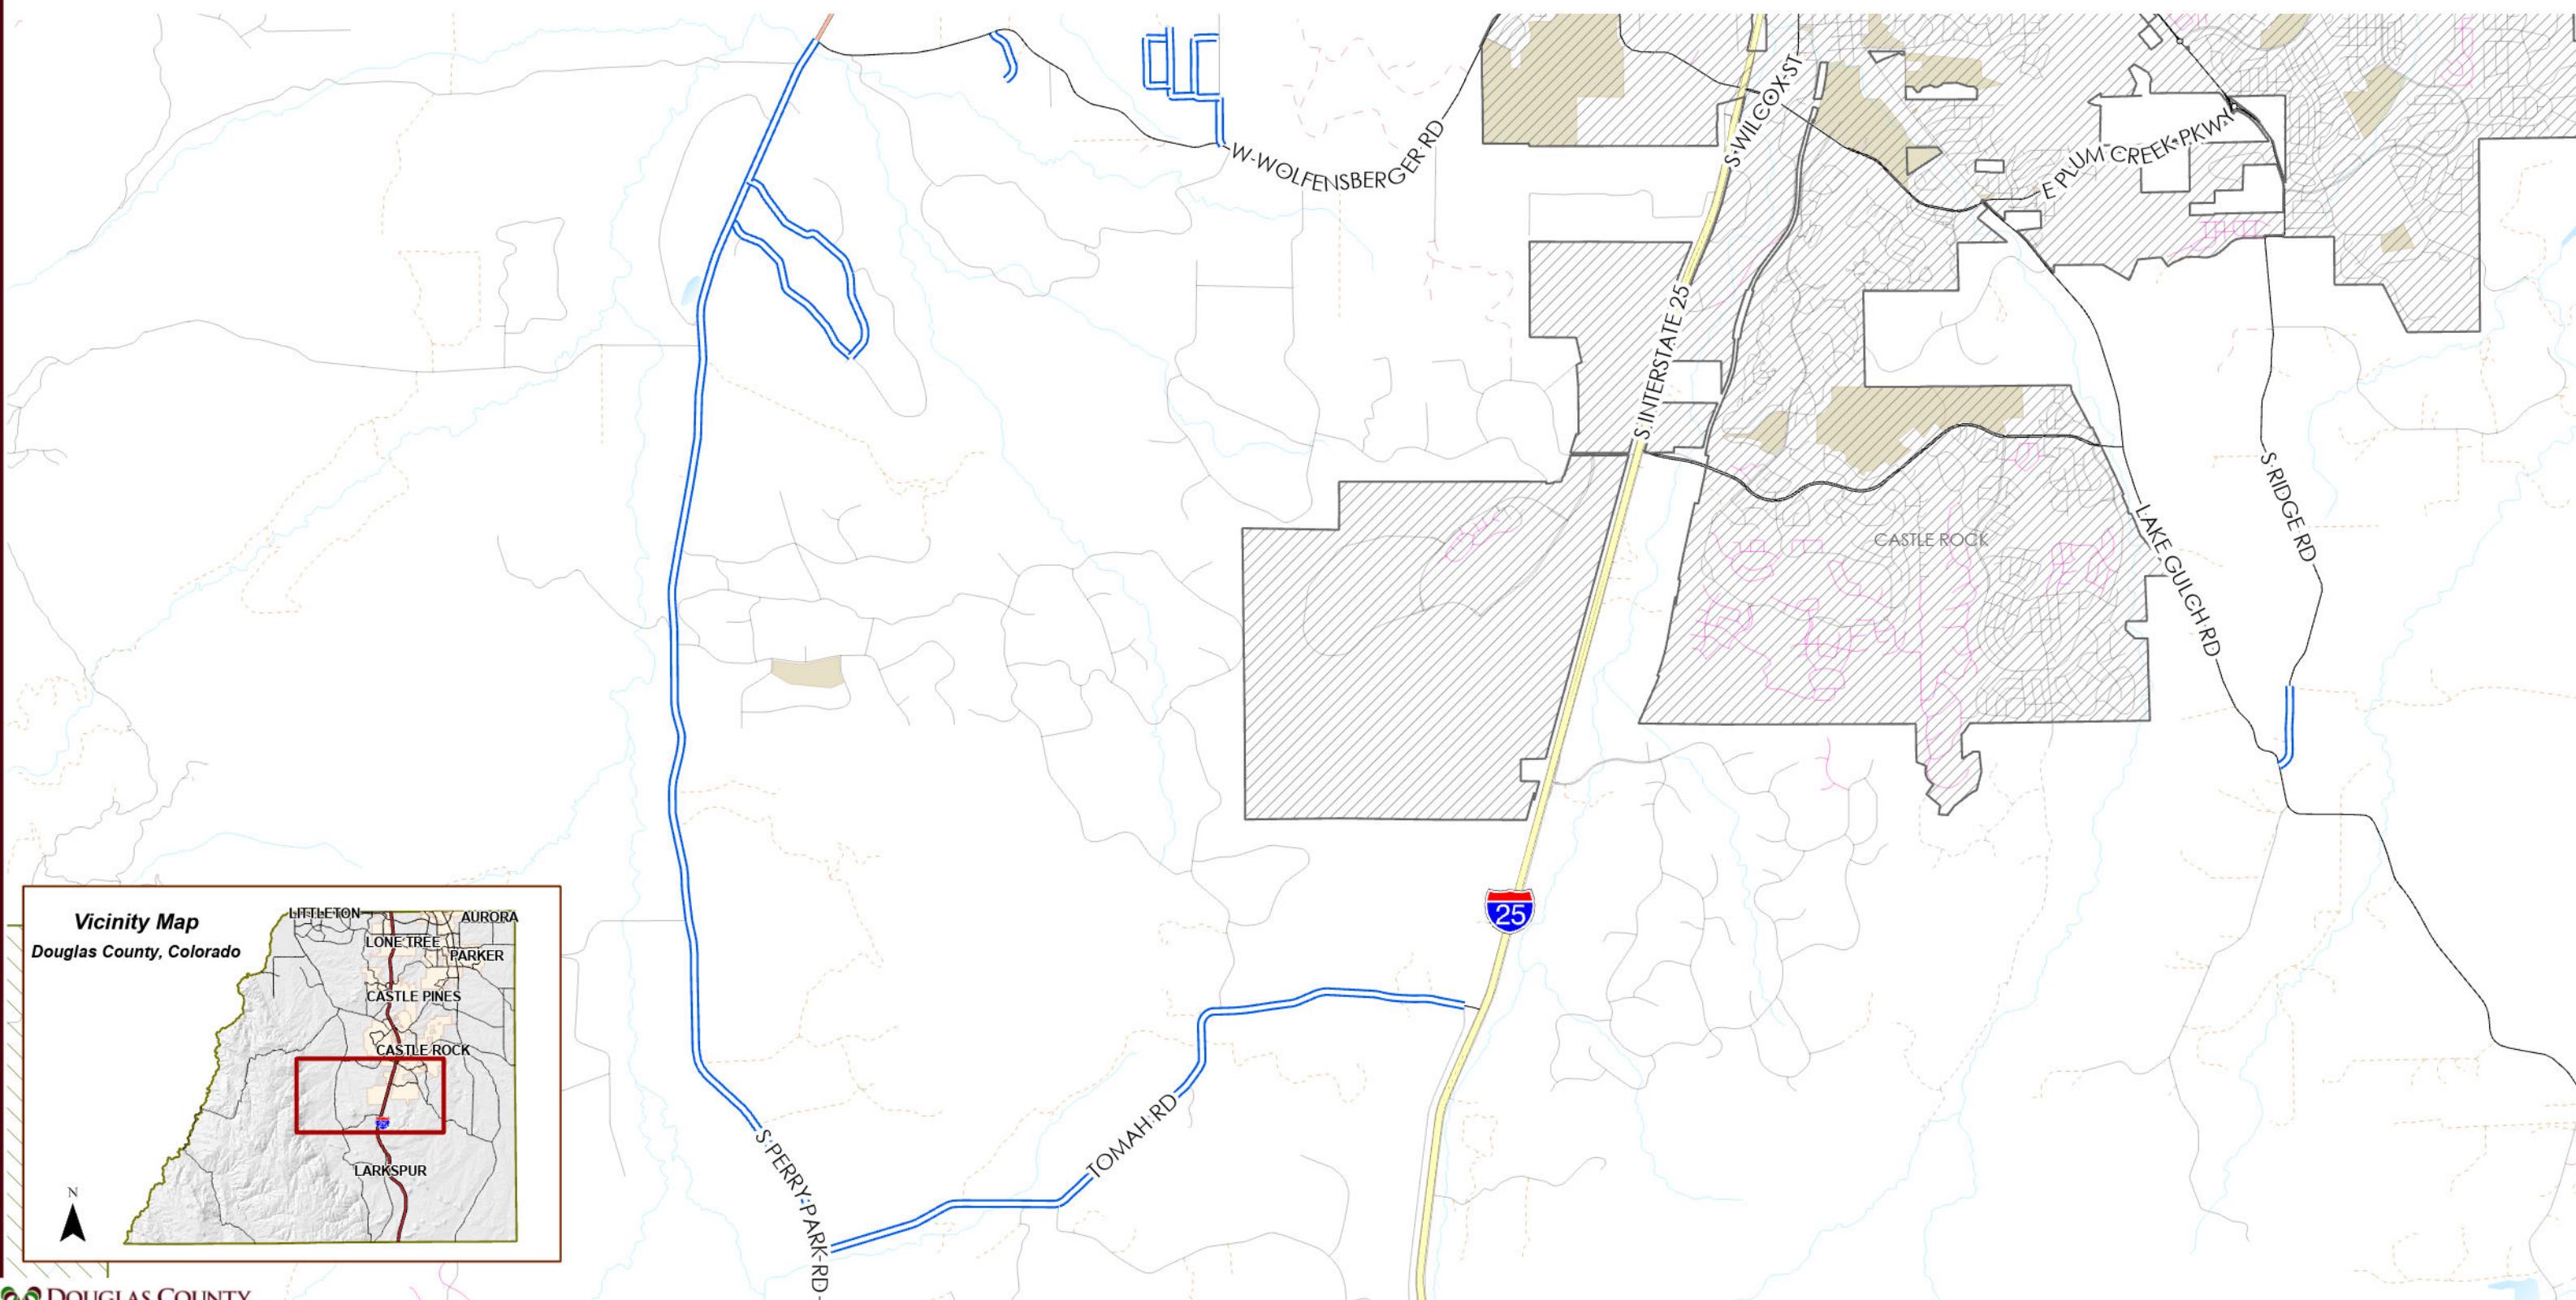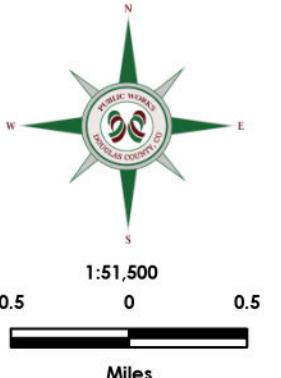

**As Built
2020 Contract Maintenance Projects
Douglas County, Colorado**

