


# As Built 2021 Contract Maintenance Projects Douglas County, Colorado

Roads	
HMA Overlay	Interstate
SMA Overlay	US Highway
Asphalt Full Depth	State Highway
Concrete	Toll Highway
County Boundary	Major Road
Municipalities	Local Road
Parks	Private
Pike National Forest	Forest Road
Lakes	Platted Not Built
Intermittent Lakes	Gated Community
Streams	Access Easement
	Entrance/Exit Ramp

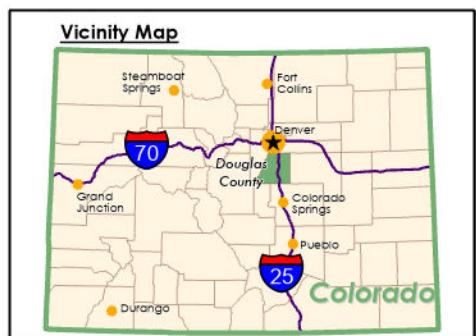

1:190,000


1 0 1

Scale in Miles

Douglas County Public Works Department: GIS Disclaimer



All GIS data and information products provided by the Douglas County Public Works Department are for illustrative purposes only. While products are considered to be accurate when provided, Douglas County does not warrant that they are error free. Douglas County Public Works Department shall not be liable for direct, indirect, incidental, or consequential damages arising from the use of such products. The recipient, and/or user, acknowledges and agrees that the use of such products is at their sole risk. Questions concerning this or any other product provided by Douglas County Public Works Department, including errors, corrections and/or updates should be directed to:

Douglas County Public Works Engineering  
100 Third St. Castle Rock, CO, 80104  
(303) 660-7490  
Engineering@douglas.co.us

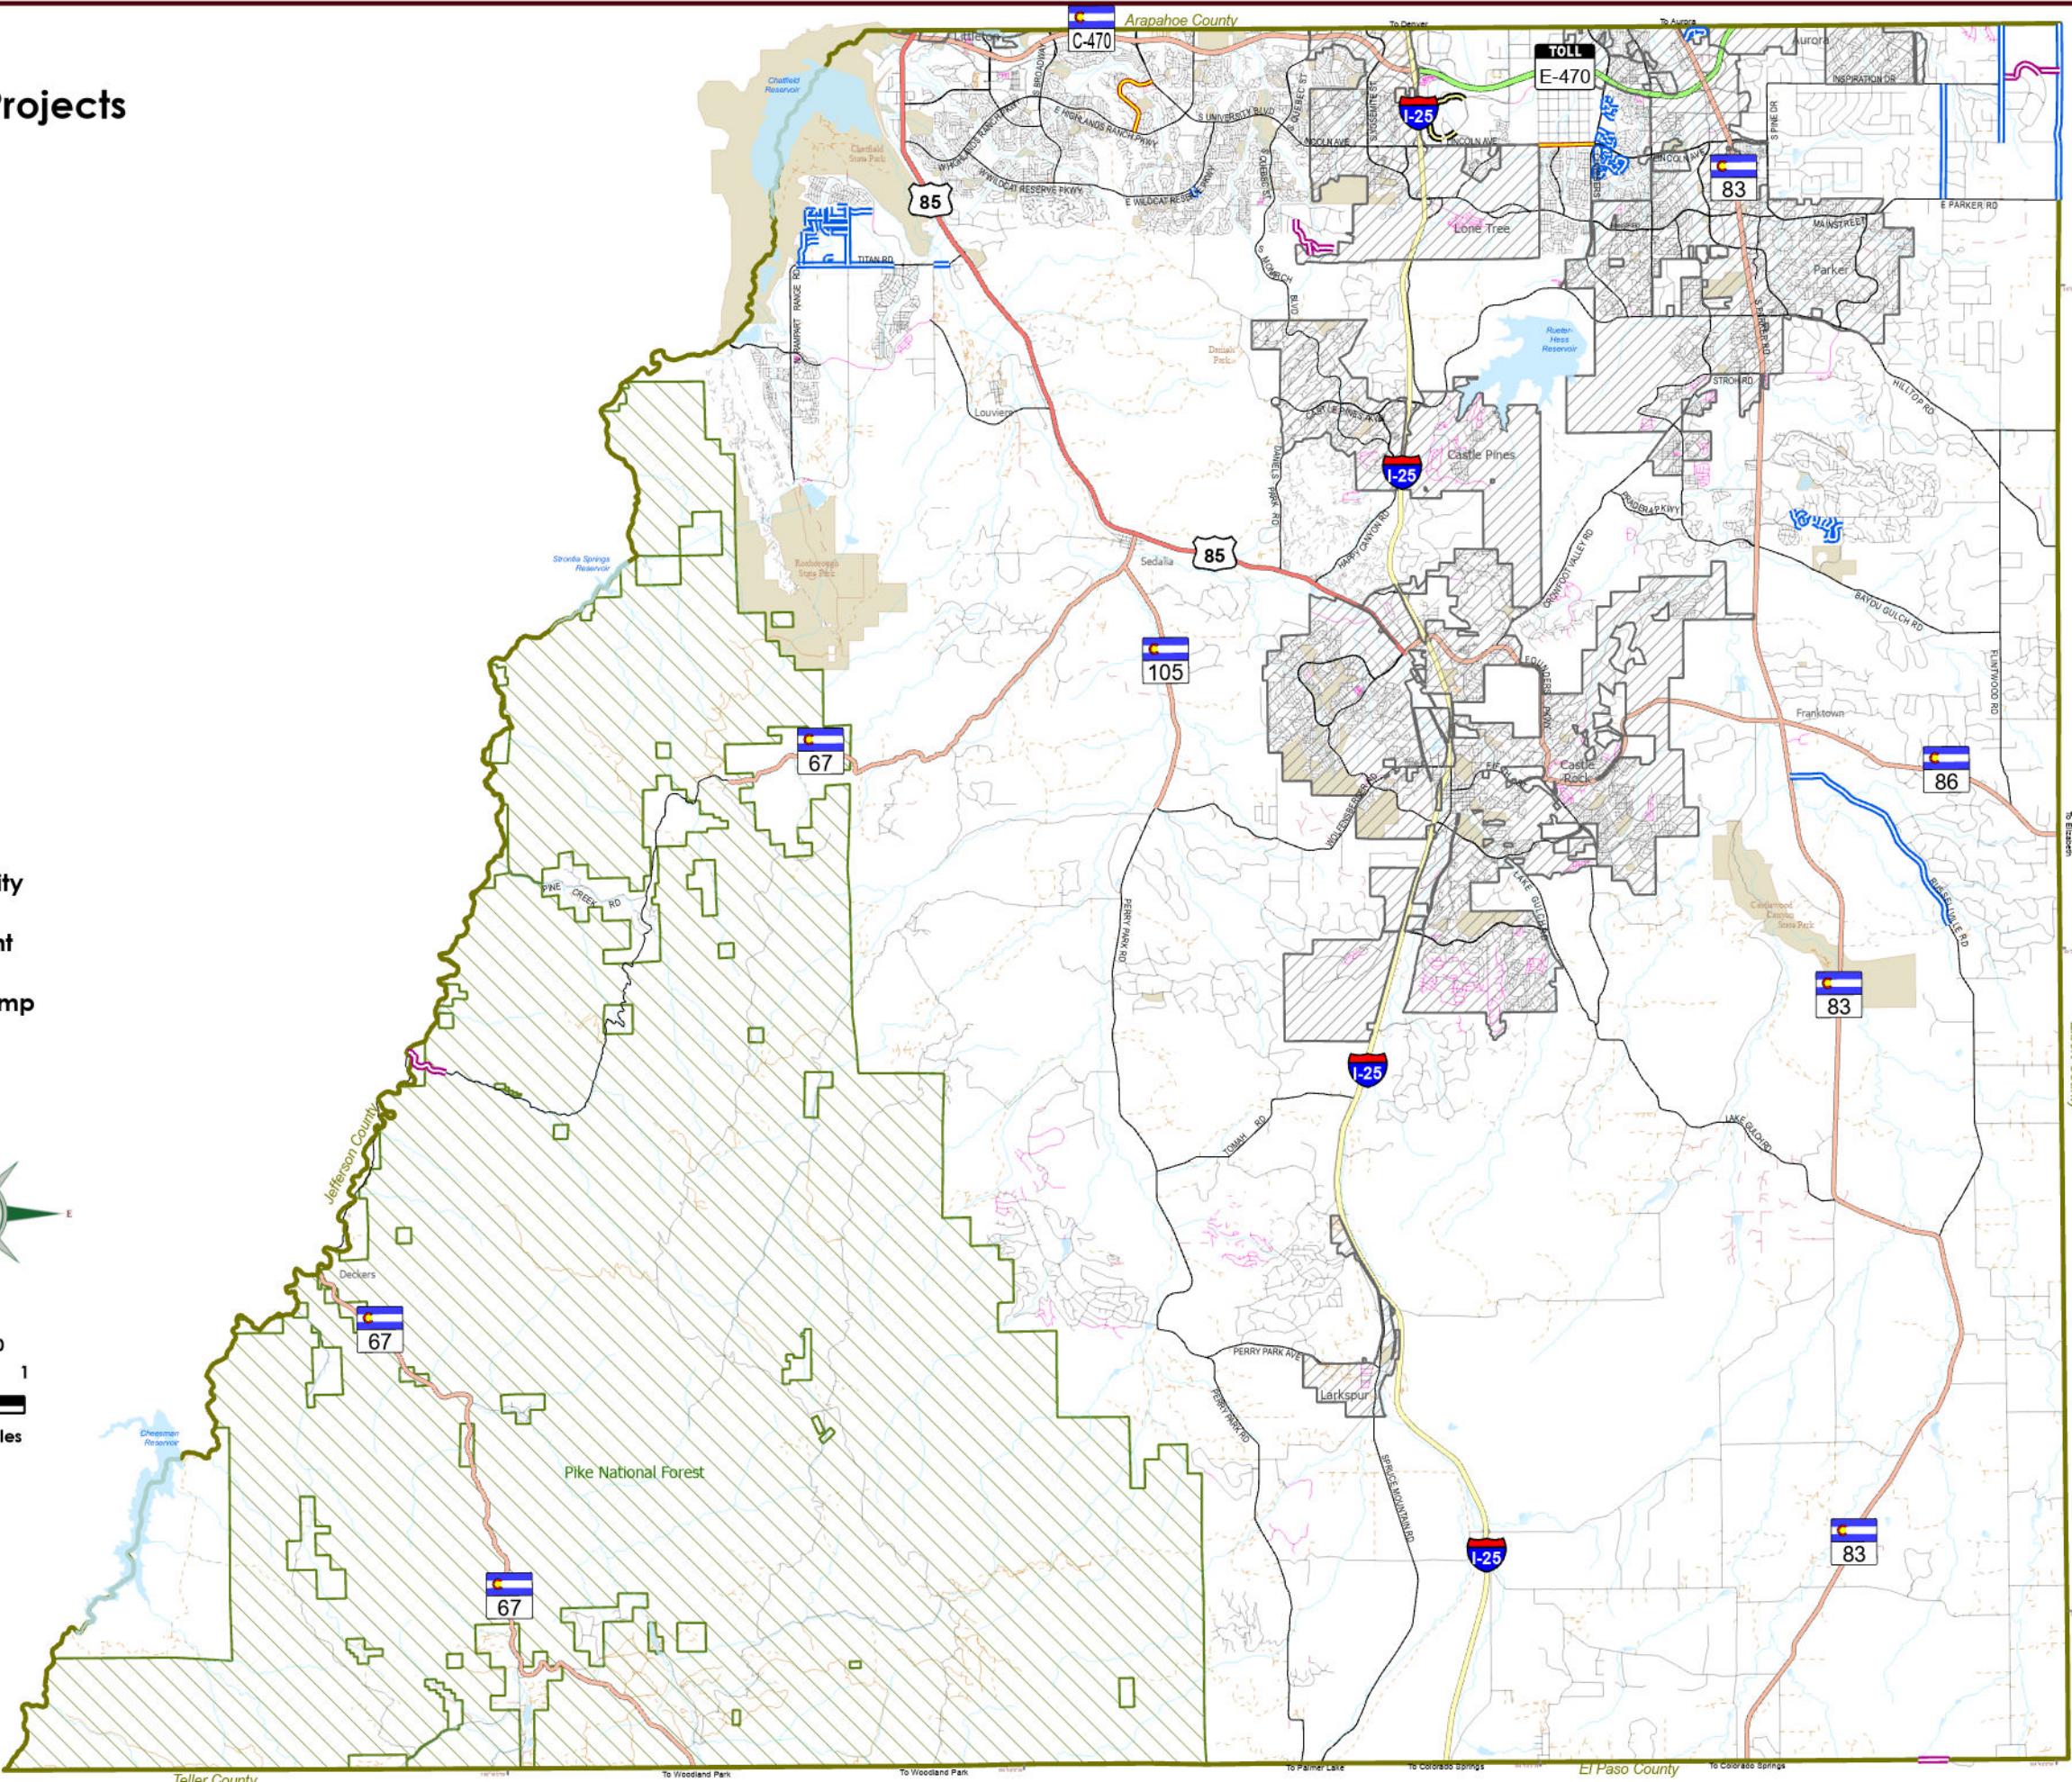



**As Built  
2021 Contract Maintenance Projects  
Douglas County, Colorado**

HMA Overlay	Parks	Toll Highway	Gated Community
SMA Overlay	Streams	Major Road	Access Easement
Asphalt Full Depth	Roads	Local Road	Entrance/Exit Ramp
County Boundary	Interstate	Private	
Municipalities	State Highway	Platted Not Built	

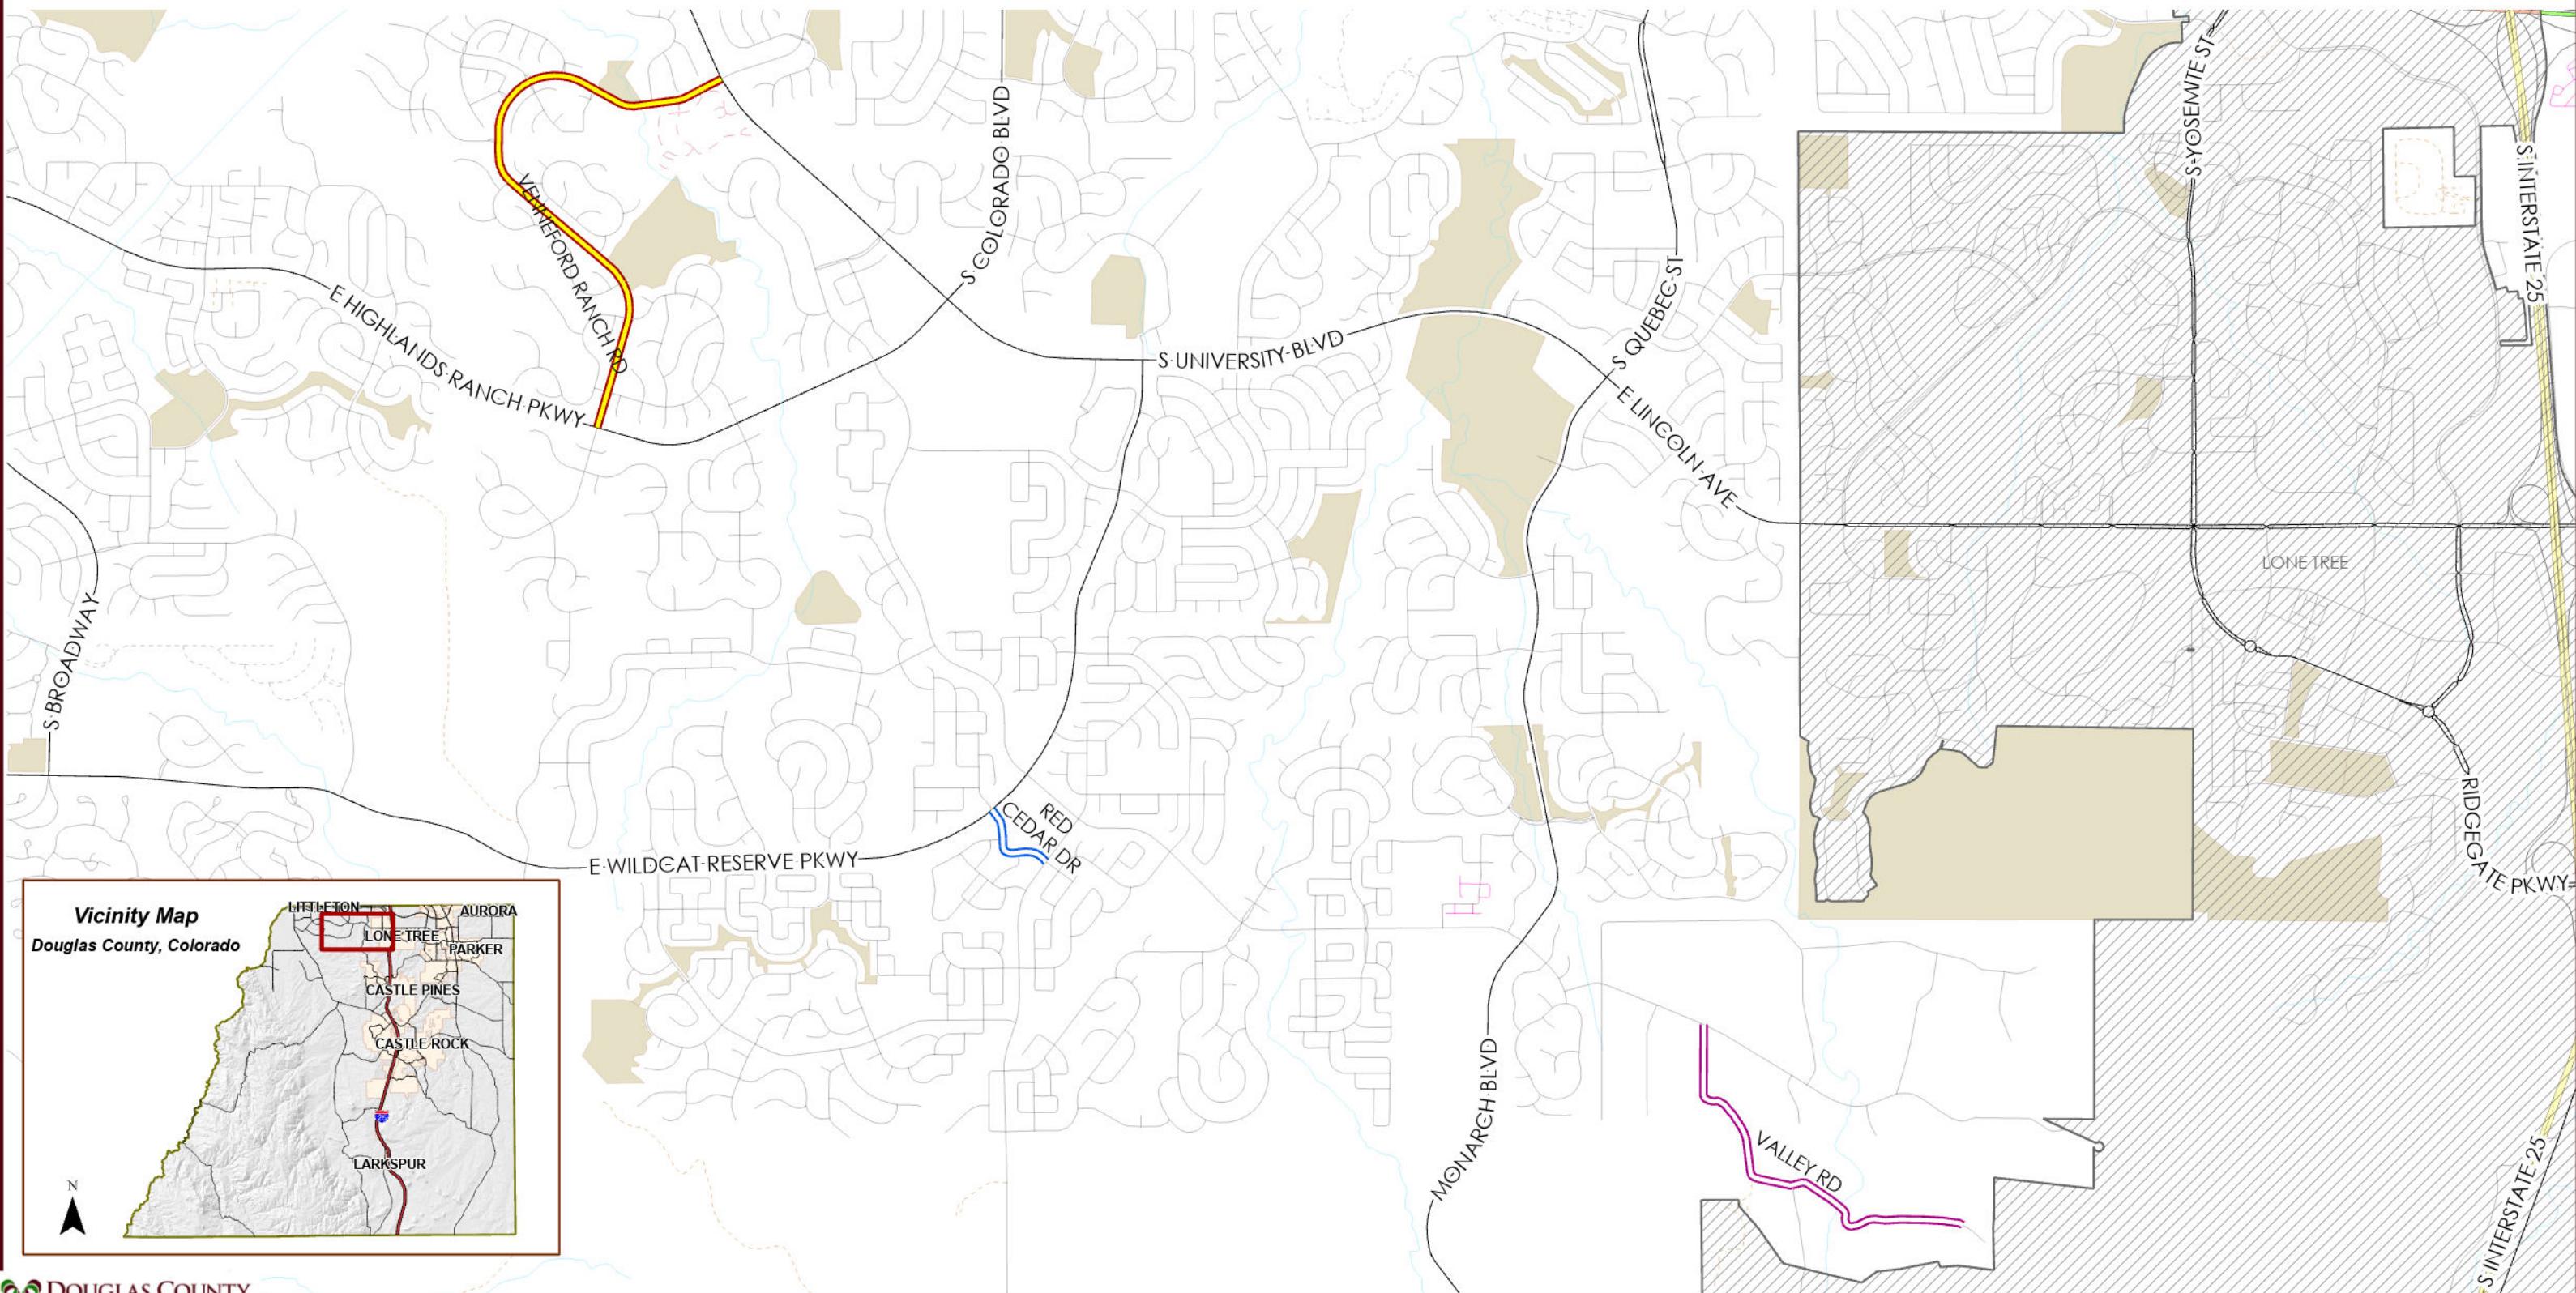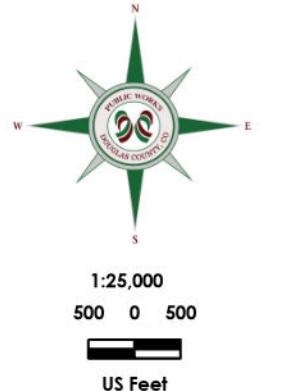


**As Built  
2021 Contract Maintenance Projects  
Douglas County, Colorado**

	HMA Overlay		Parks		State Highway		Platted Not Built
	SMA Overlay		Intermittent Lakes		Toll Highway		Gated Community
	Concrete		Streams		Major Road		Access Easement
	County Boundary		Roads		Local Road		Entrance/Exit Ramp
	Municipalities		Interstate		Private		

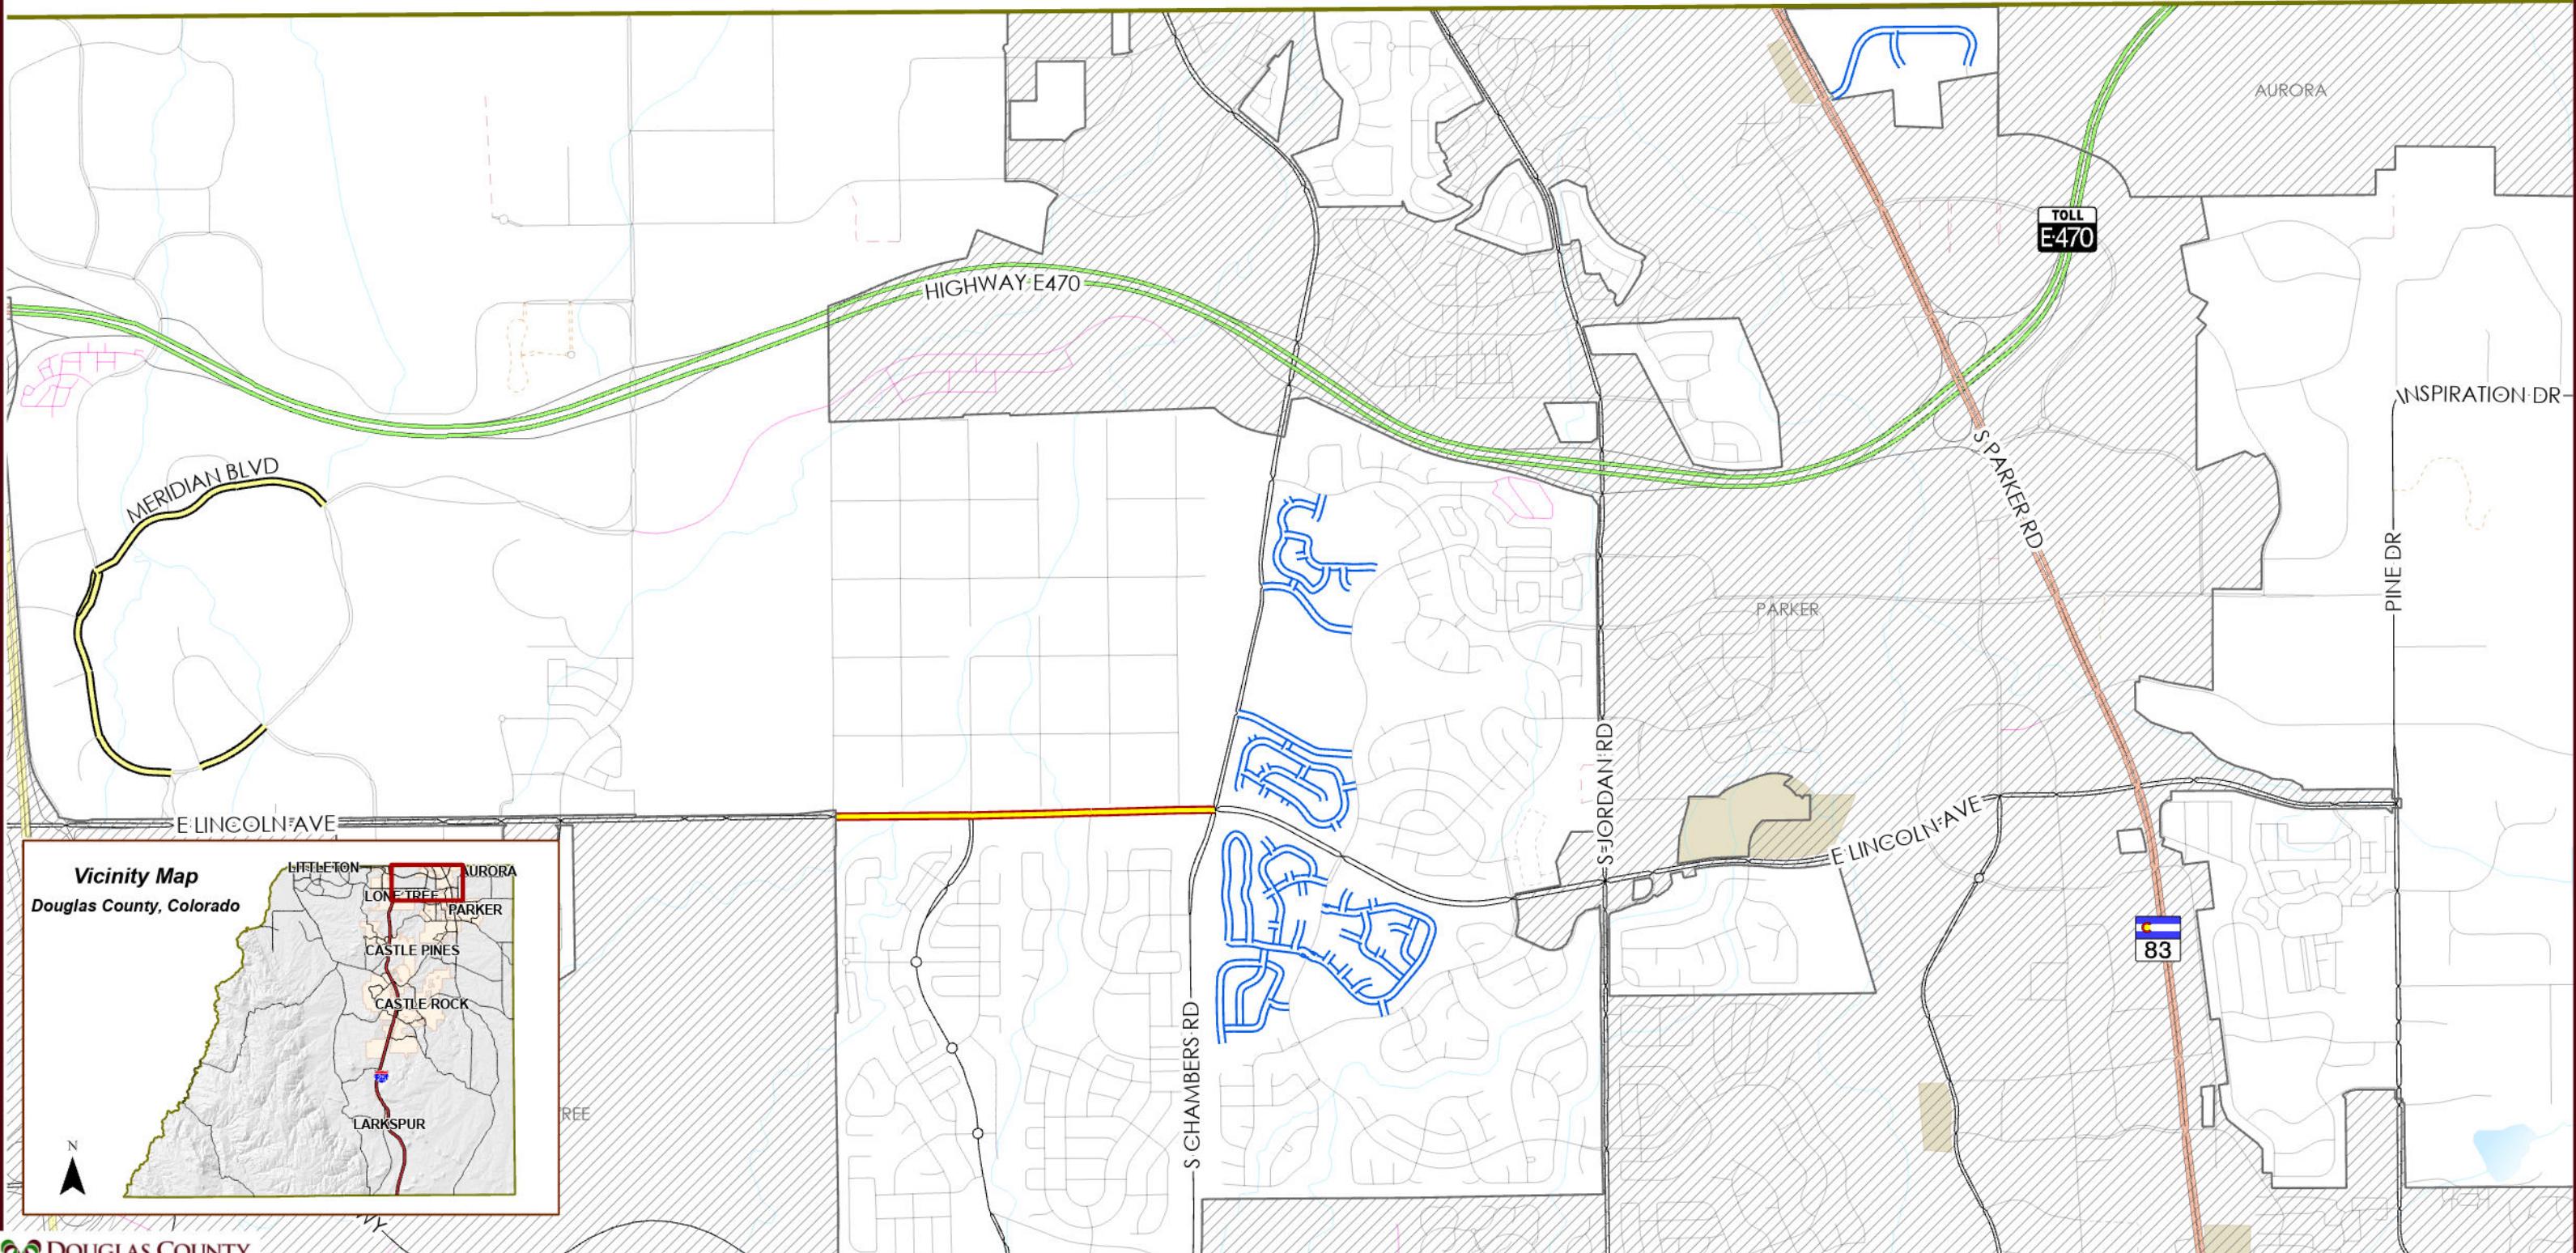
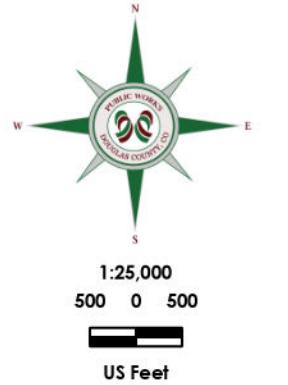


**As Built  
2021 Contract Maintenance Projects  
Douglas County, Colorado**



- HMA Overlay
- Asphalt Full Depth
- County Boundary
- Municipalities
- Intermittent Lakes
- Streams
- Roads
- Major Road
- Local Road
- Private
- Platted Not Built
- Access Easement

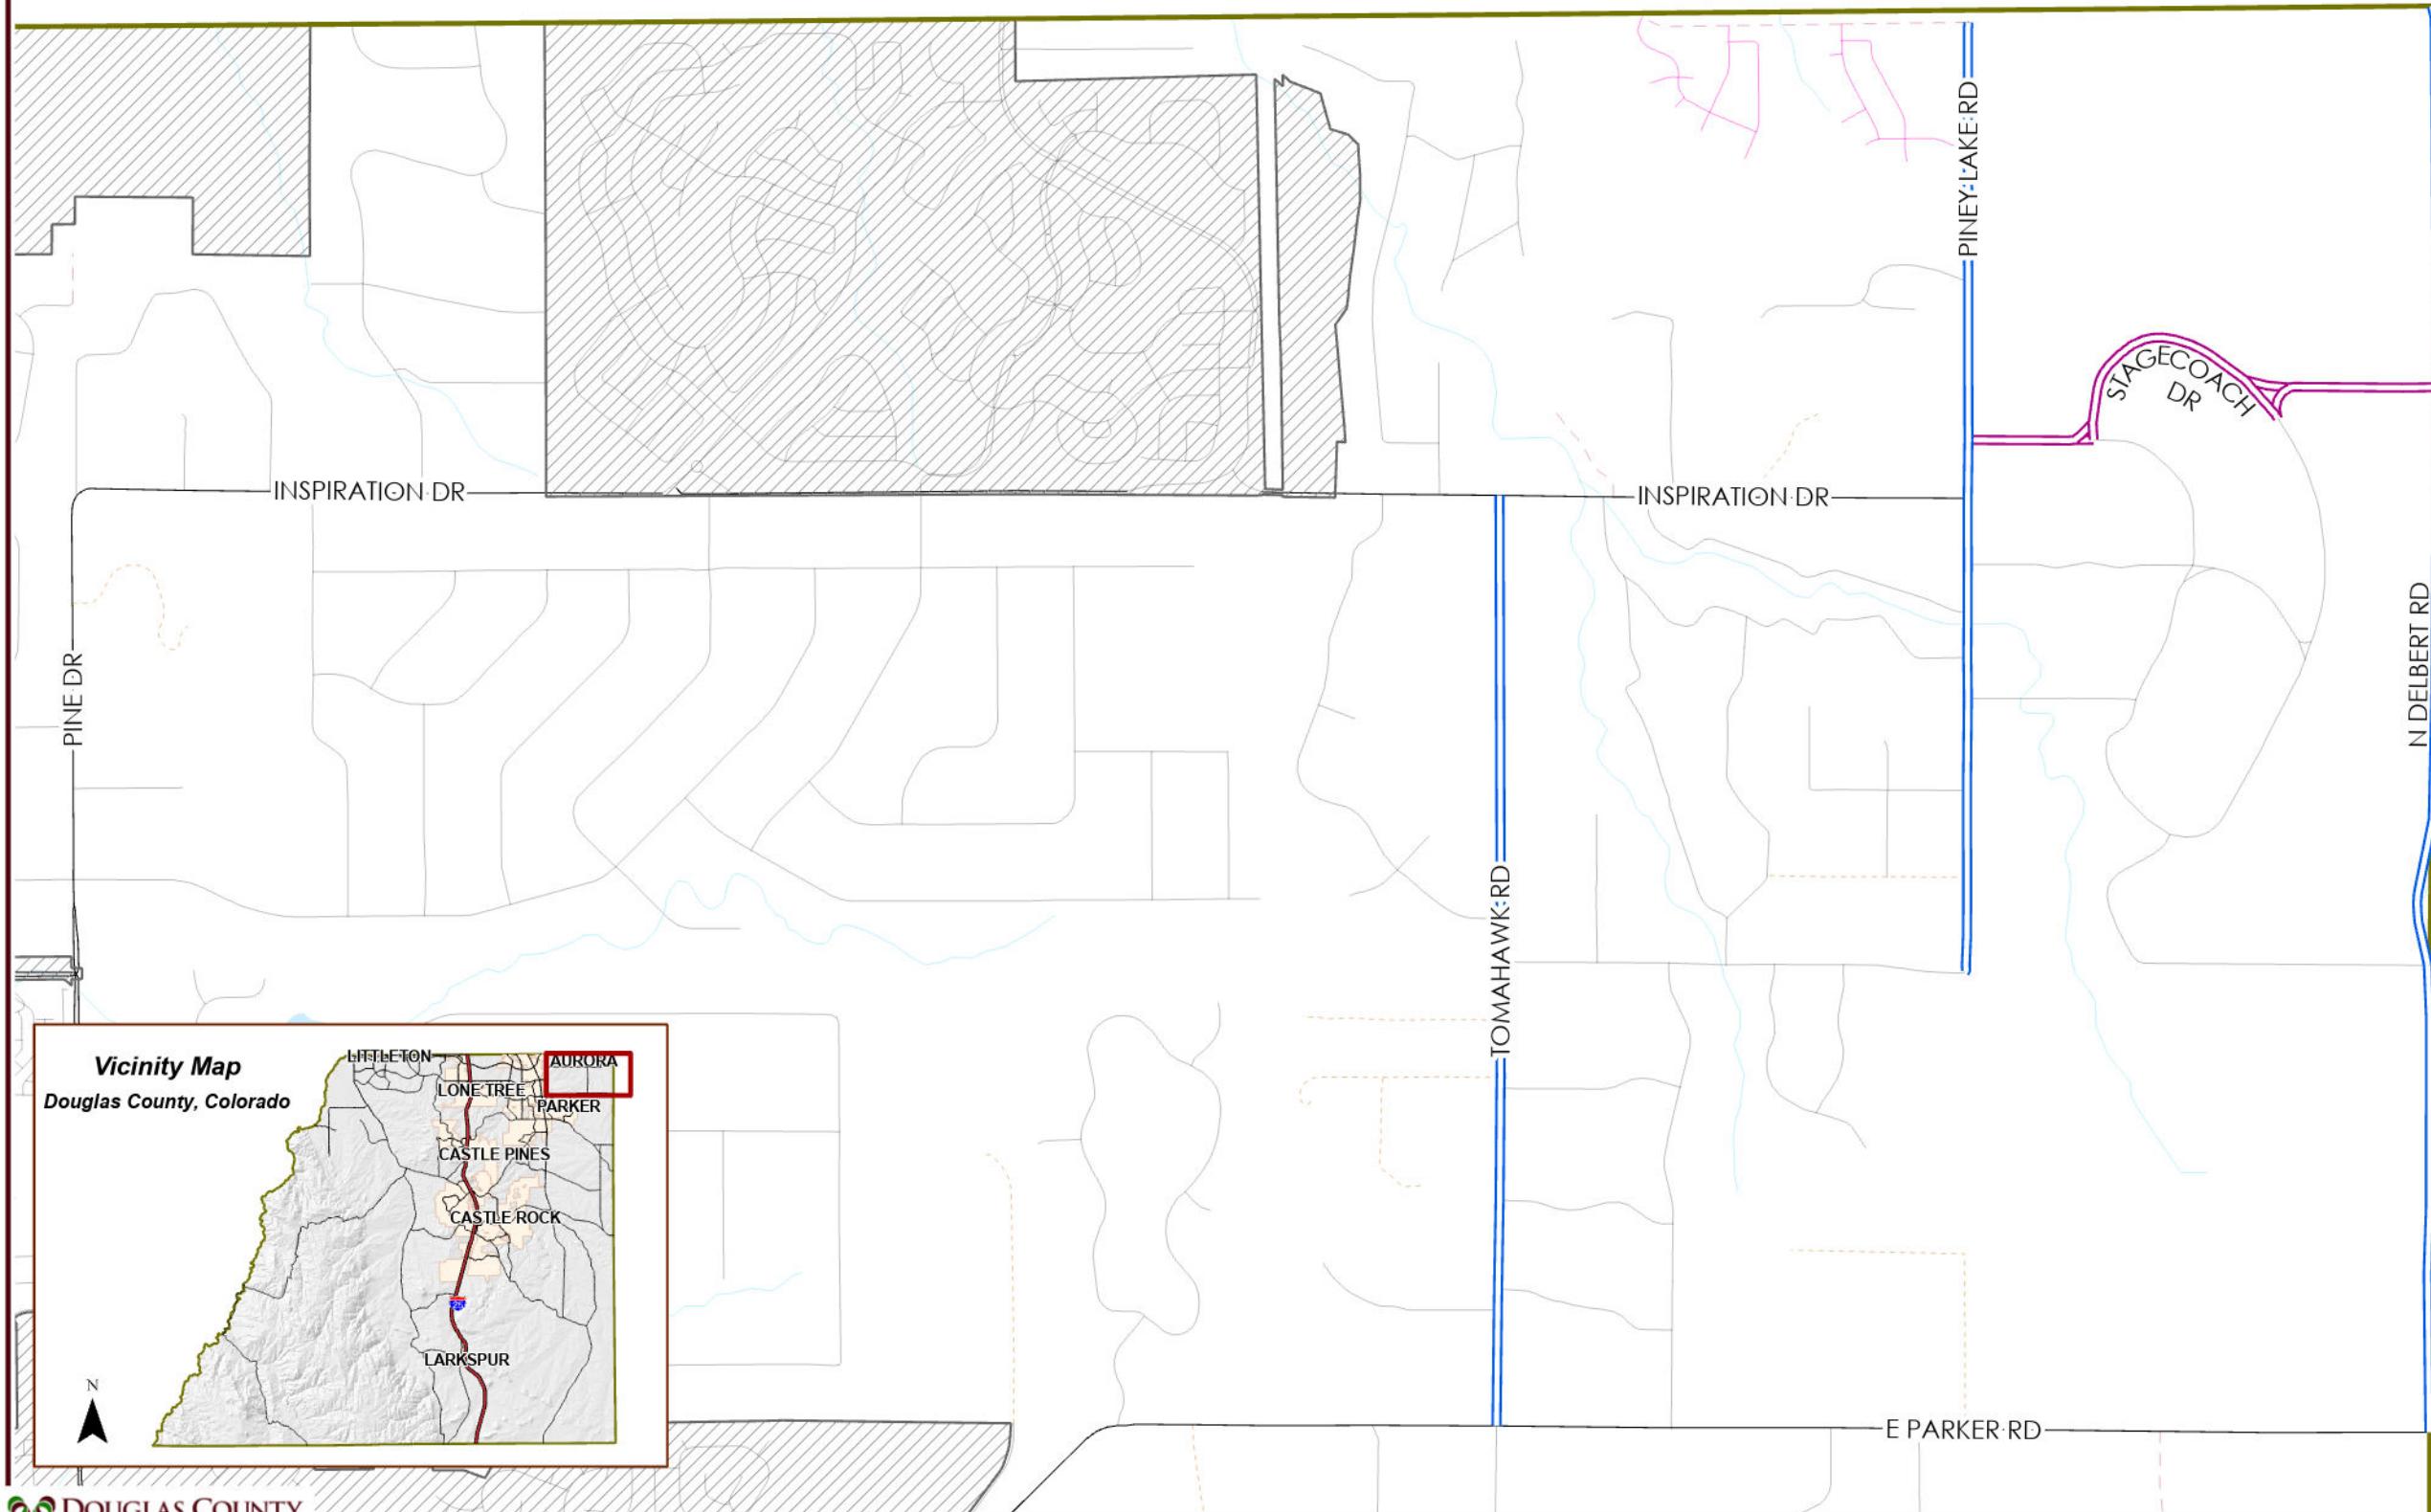

# As Built 2021 Contract Maintenance Projects Douglas County, Colorado

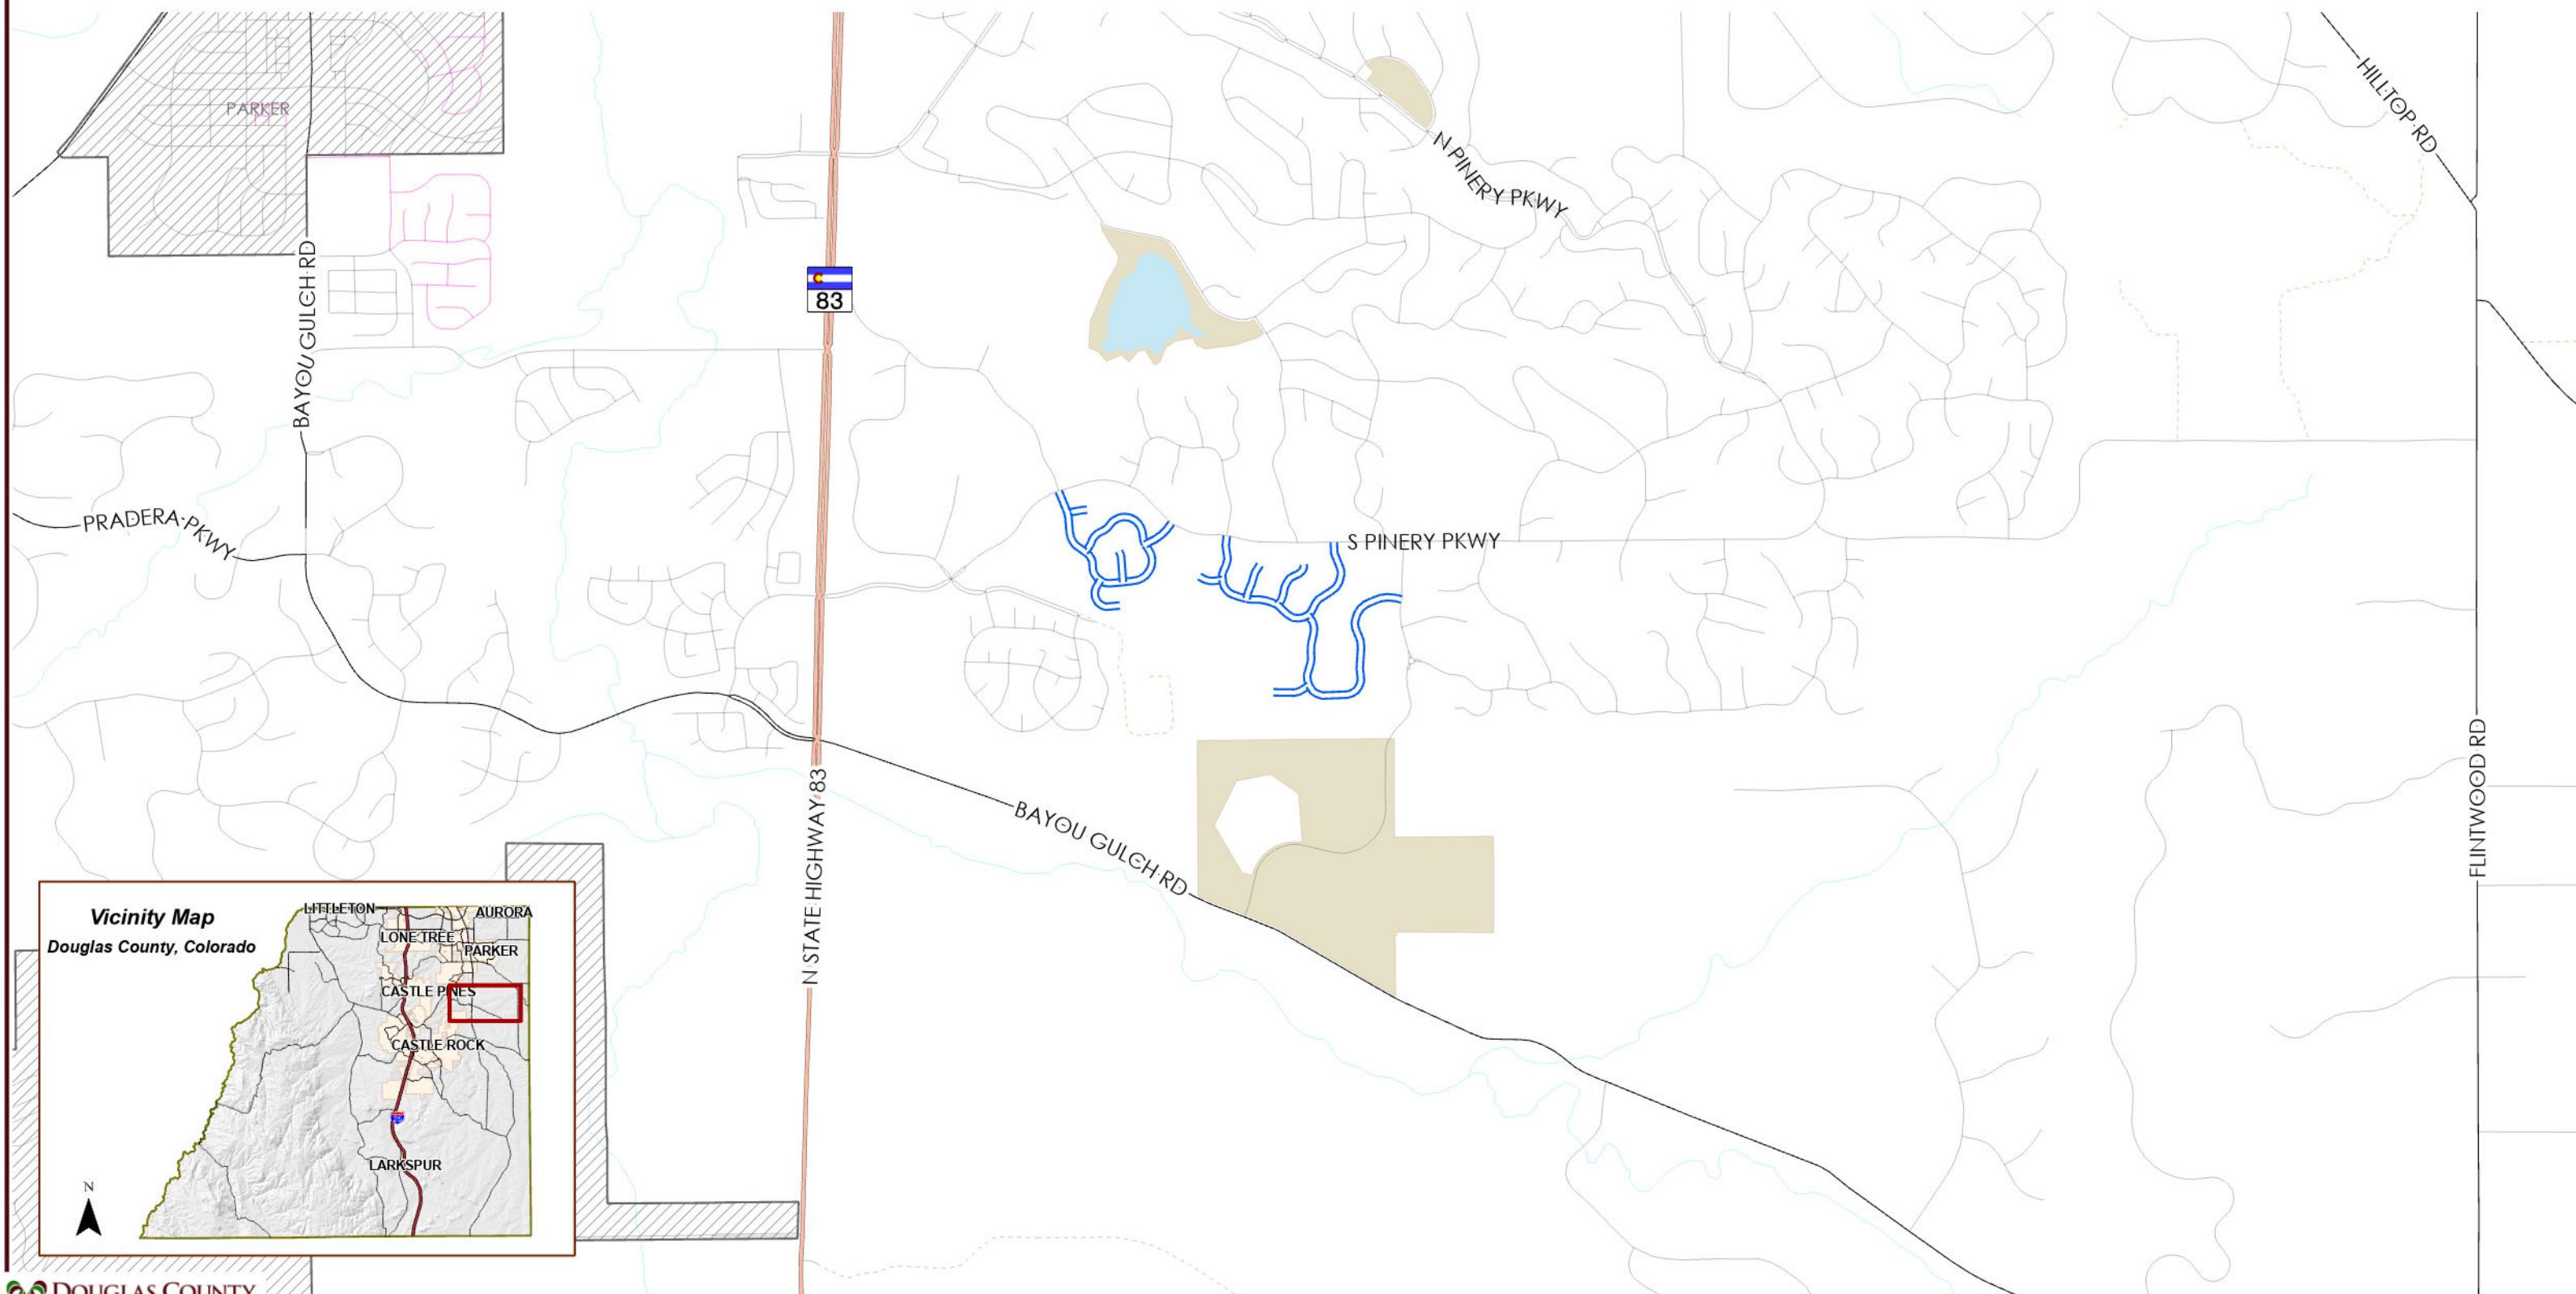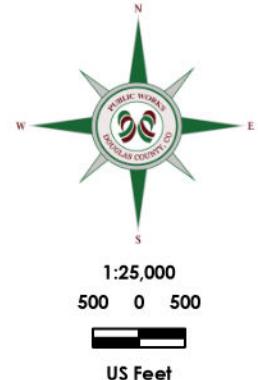


**As Built  
2021 Contract Maintenance Projects  
Douglas County, Colorado**

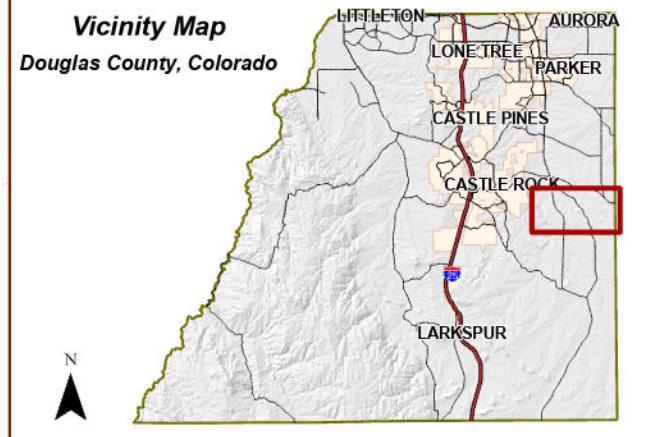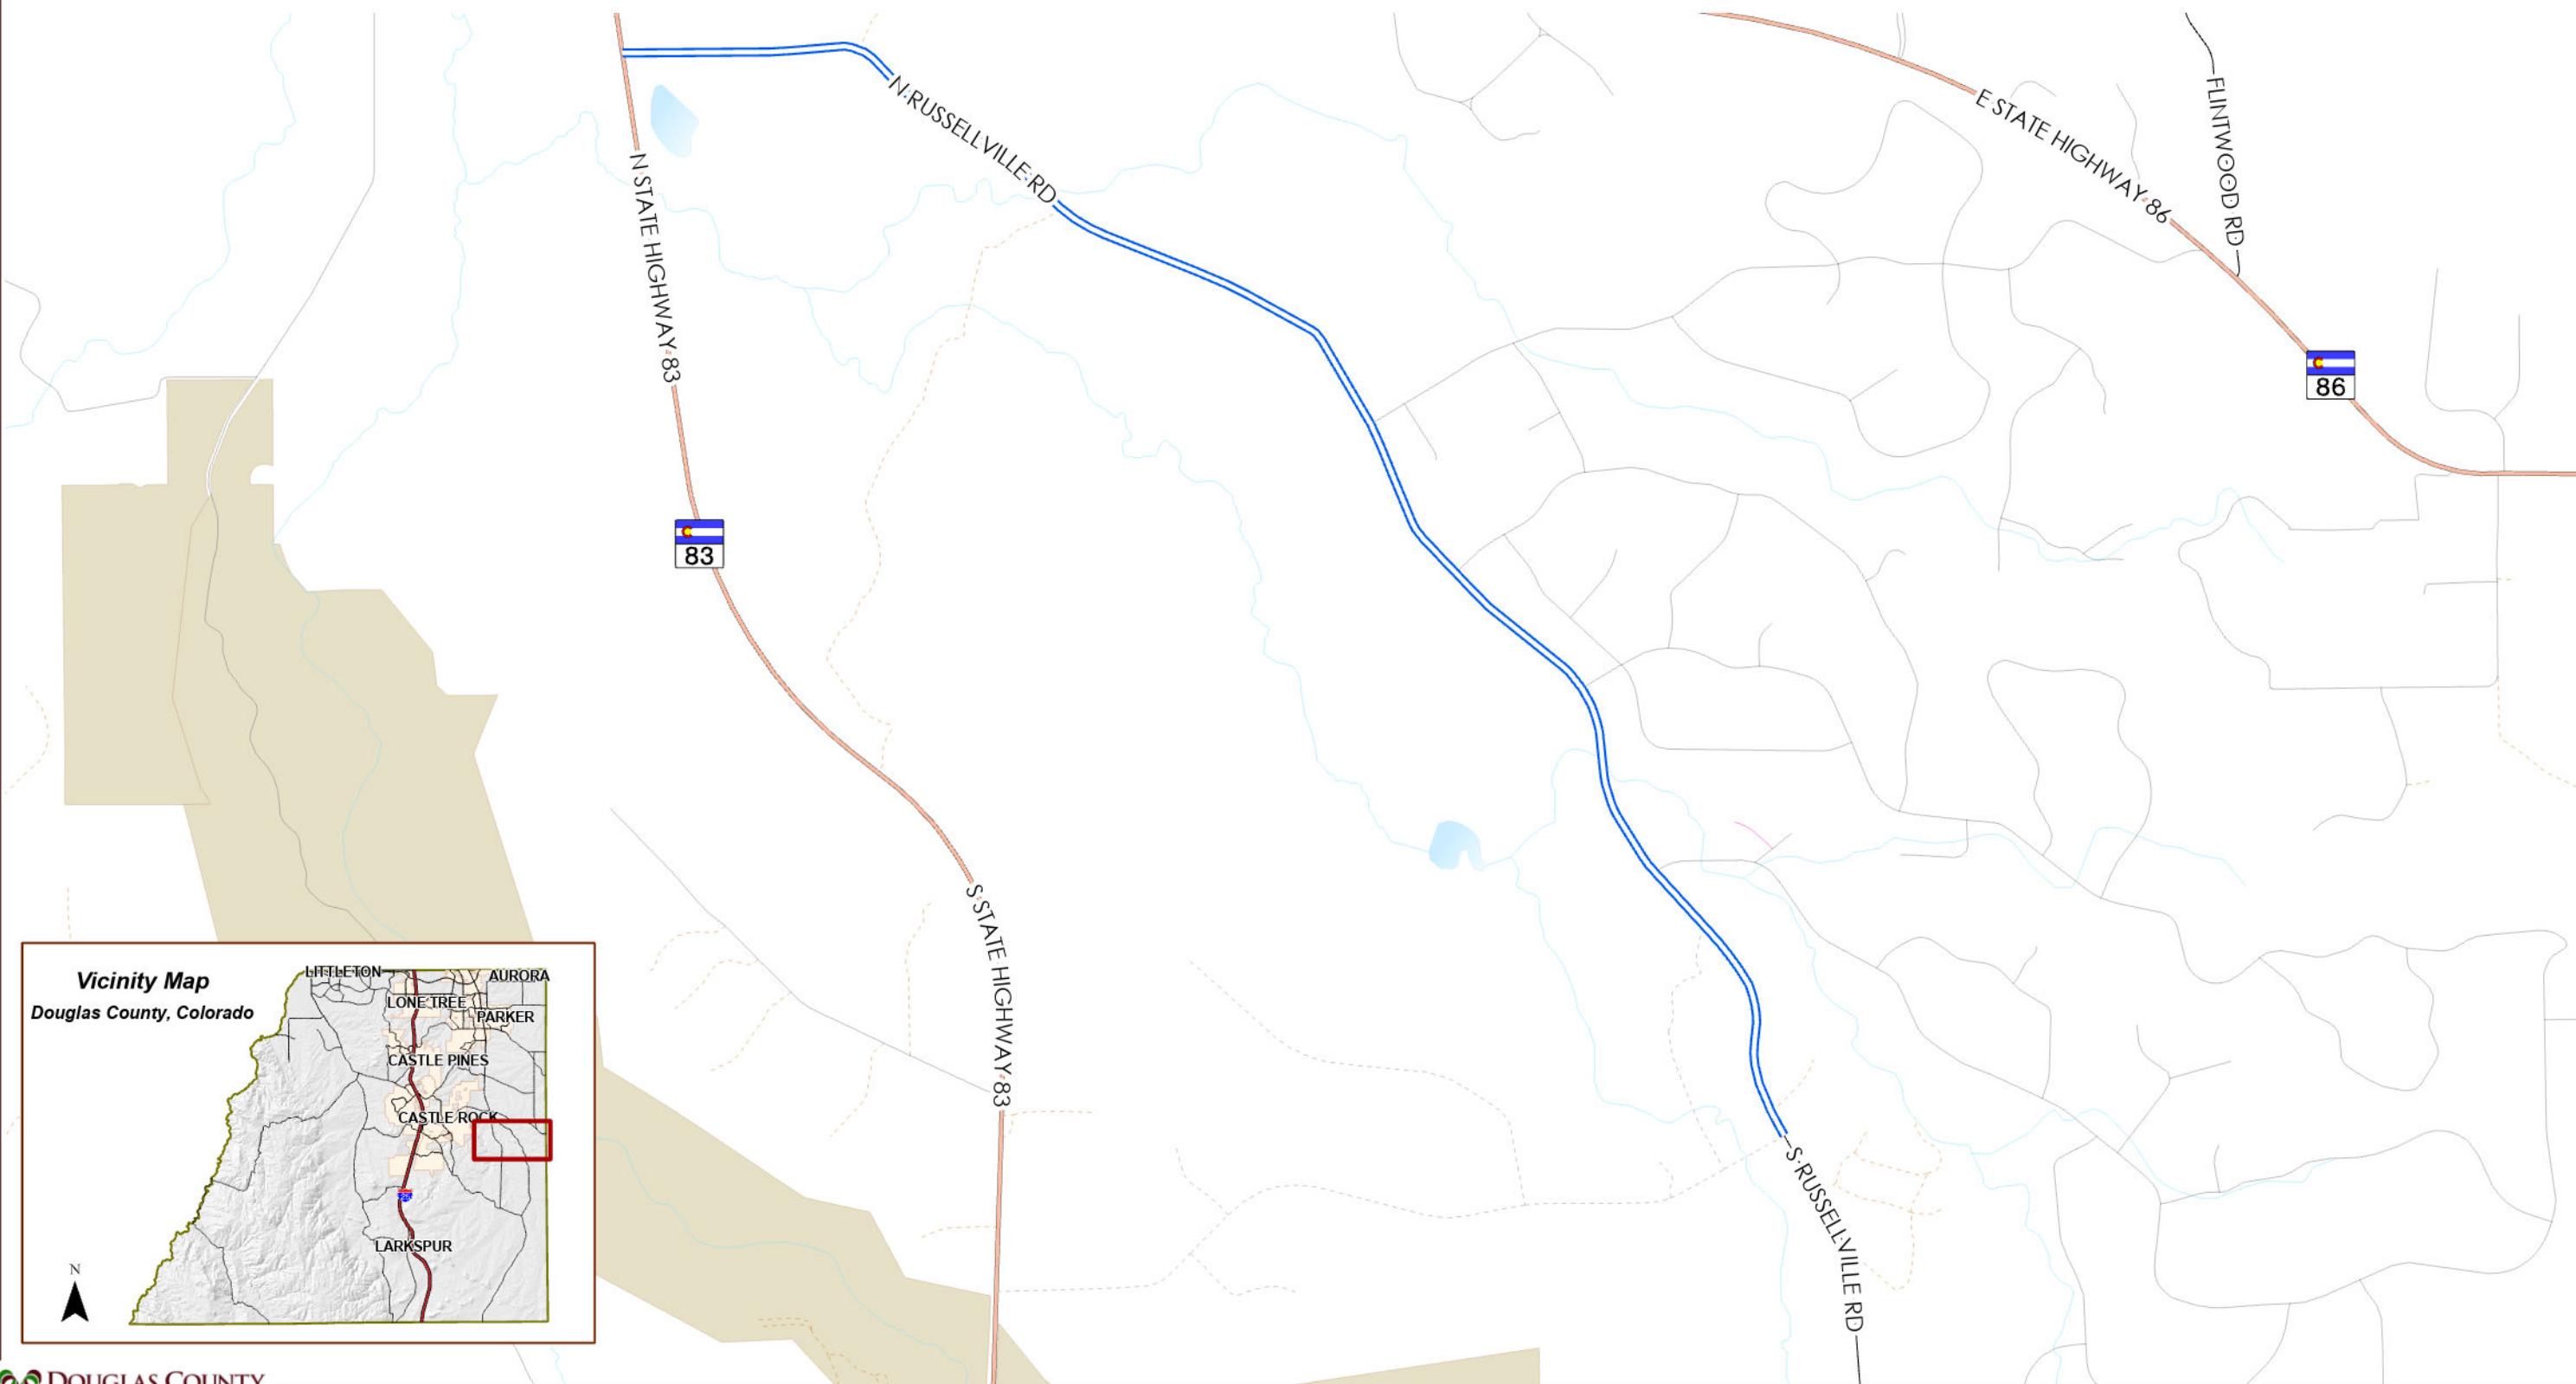

**As Built  
2021 Contract Maintenance Projects  
Douglas County, Colorado**



- Asphalt Full Depth — Roads
- County Boundary — State Highway
- Lakes — Local Road
- Intermittent Lakes — Private
- Streams

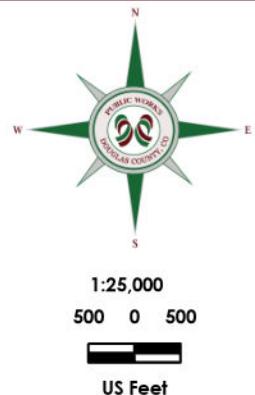

**As Built  
2021 Contract Maintenance Projects  
Douglas County, Colorado**

 Asphalt Full Depth  Roads  
 County Boundary  Private  
 Pike National Forest  Forest Road  
 Streams

  
N  
W E  
S  
1:25,000  
500 0 500  
US Feet

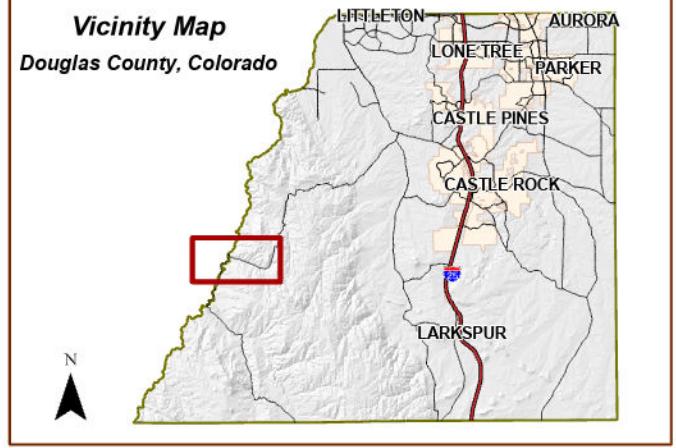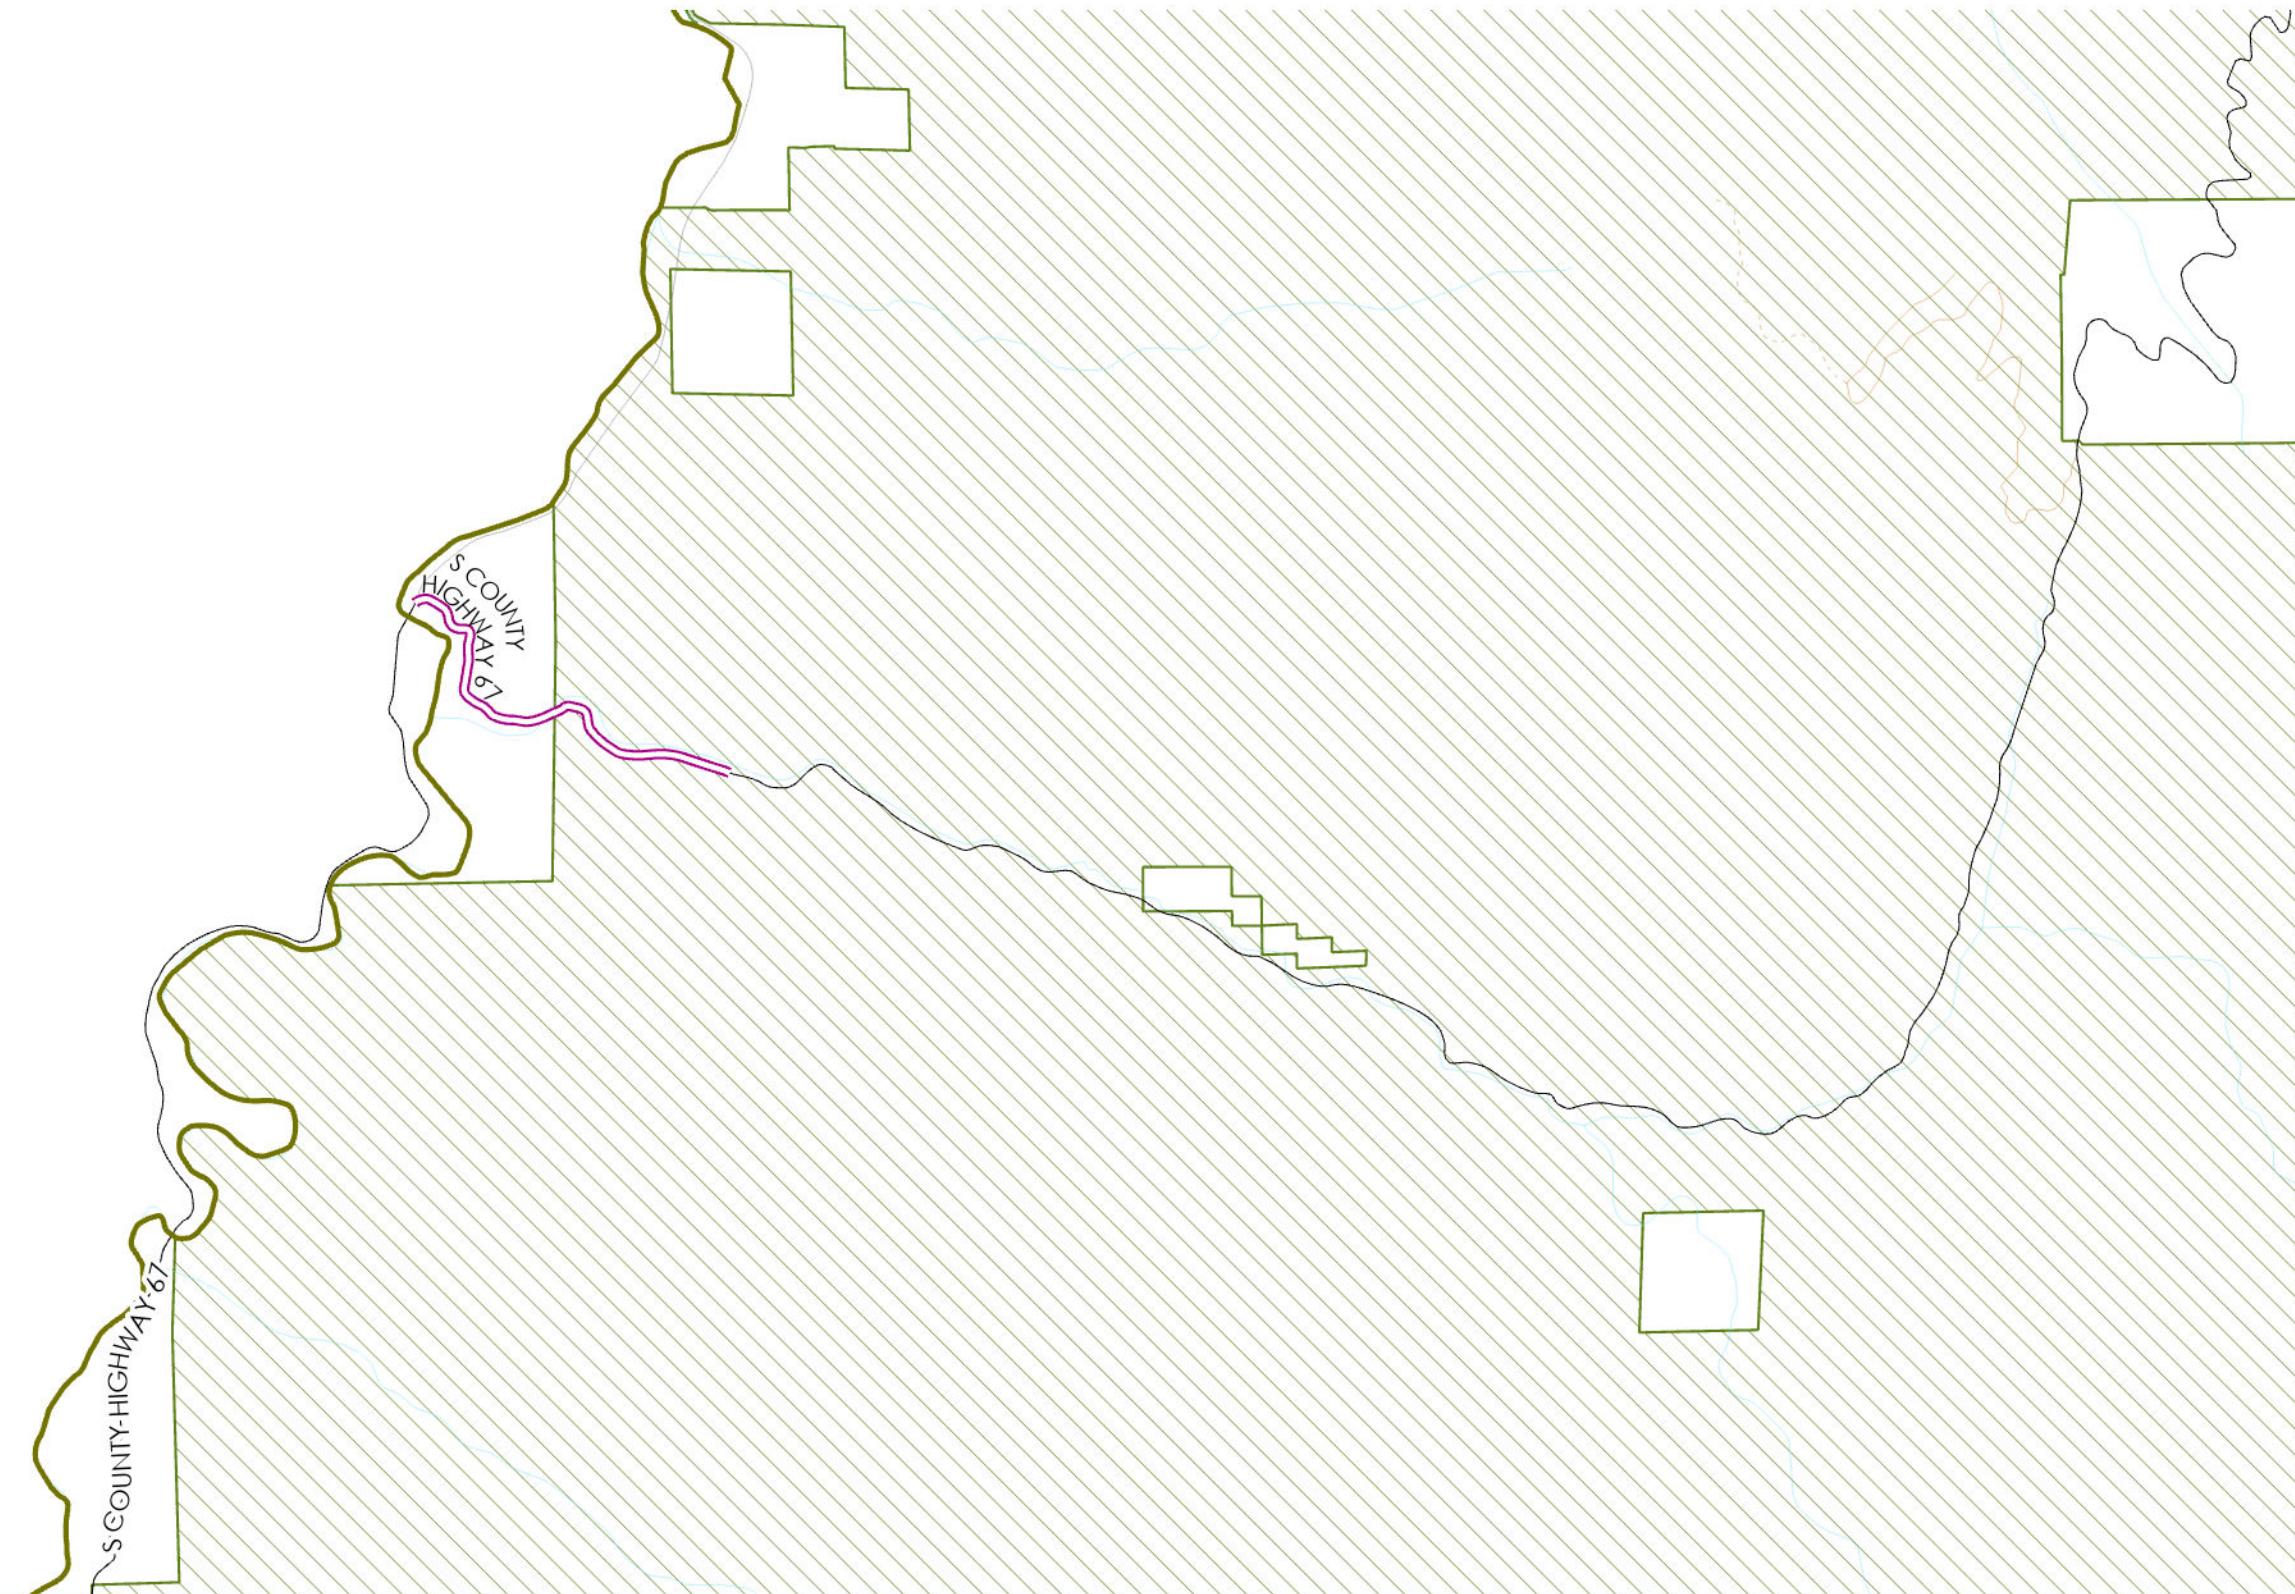

**As Built  
2021 Contract Maintenance Projects  
Douglas County, Colorado**

 HMA Overlay	<b>Roads</b>	 Private
 County Boundary	 US Highway	 Platted Not Built
 Parks	 Major Road	 Entrance/Exit Ramp
 Lakes	 Local Road	
 Streams		

