

As Built 2022 Contract Maintenance Projects Douglas County, Colorado


Roads	
HMA Overlay	Interstate
SMA Overlay	US Highway
Asphalt Full Depth	State Highway
Concrete	Toll Highway
County Boundary	Major Road
Municipalities	Local Road
Parks	Private
Pike National Forest	Forest Road
Lakes	Platted Not Built
Intermittent Lakes	Gated Community
Streams	Access Easement
	Entrance/Exit Ramp





Douglas County Public Works Department: GIS Disclaimer

All GIS data and information products provided by the Douglas County Public Works Department are for illustrative purposes only. While products are considered to be accurate when provided, Douglas County does not warrant that they are error free. Douglas County Public Works Department shall not be liable for direct, indirect, incidental, or consequential damages arising from the use of such products. The recipient, and/or user, acknowledges and agrees that the use of such products is at their sole risk. Questions concerning this or any other product provided by Douglas County Public Works Department, including errors, corrections and/or updates should be directed to:

Douglas County Public Works Engineering
100 Third St. Castle Rock, CO, 80104
(303) 660-7490
Engineering@douglas.co.us


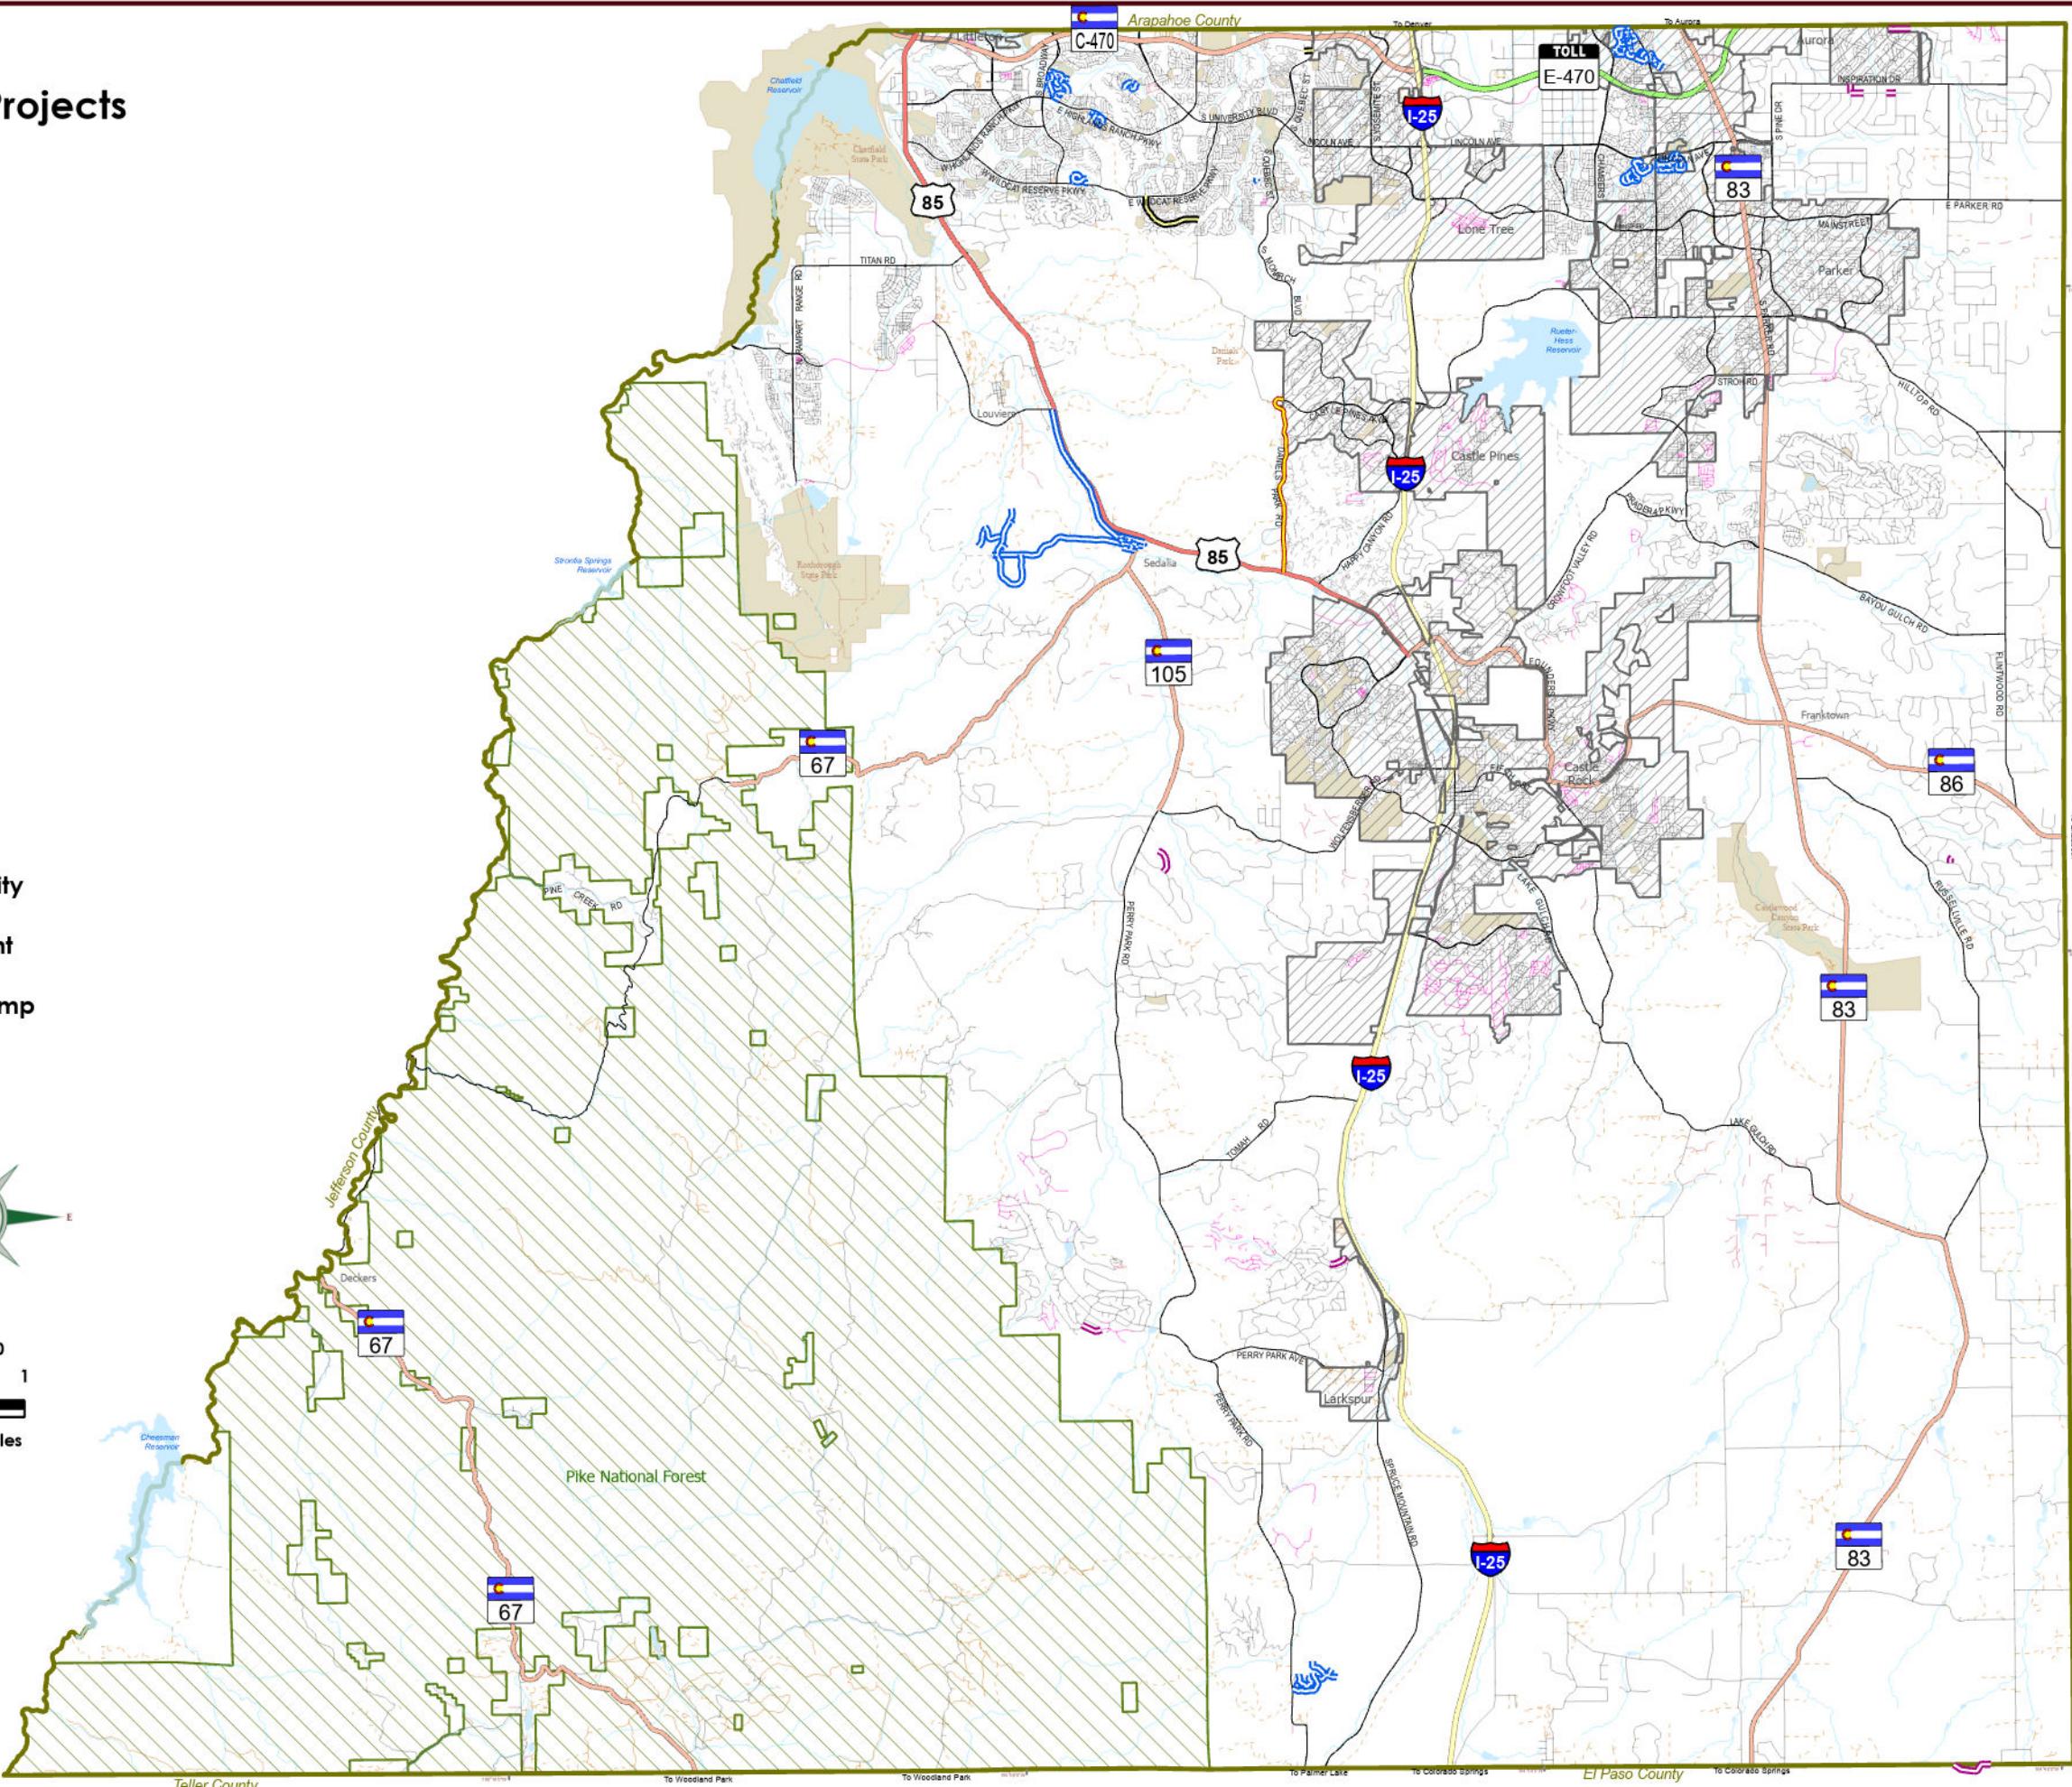


As Built 2022 Contract Maintenance Projects Douglas County, Colorado

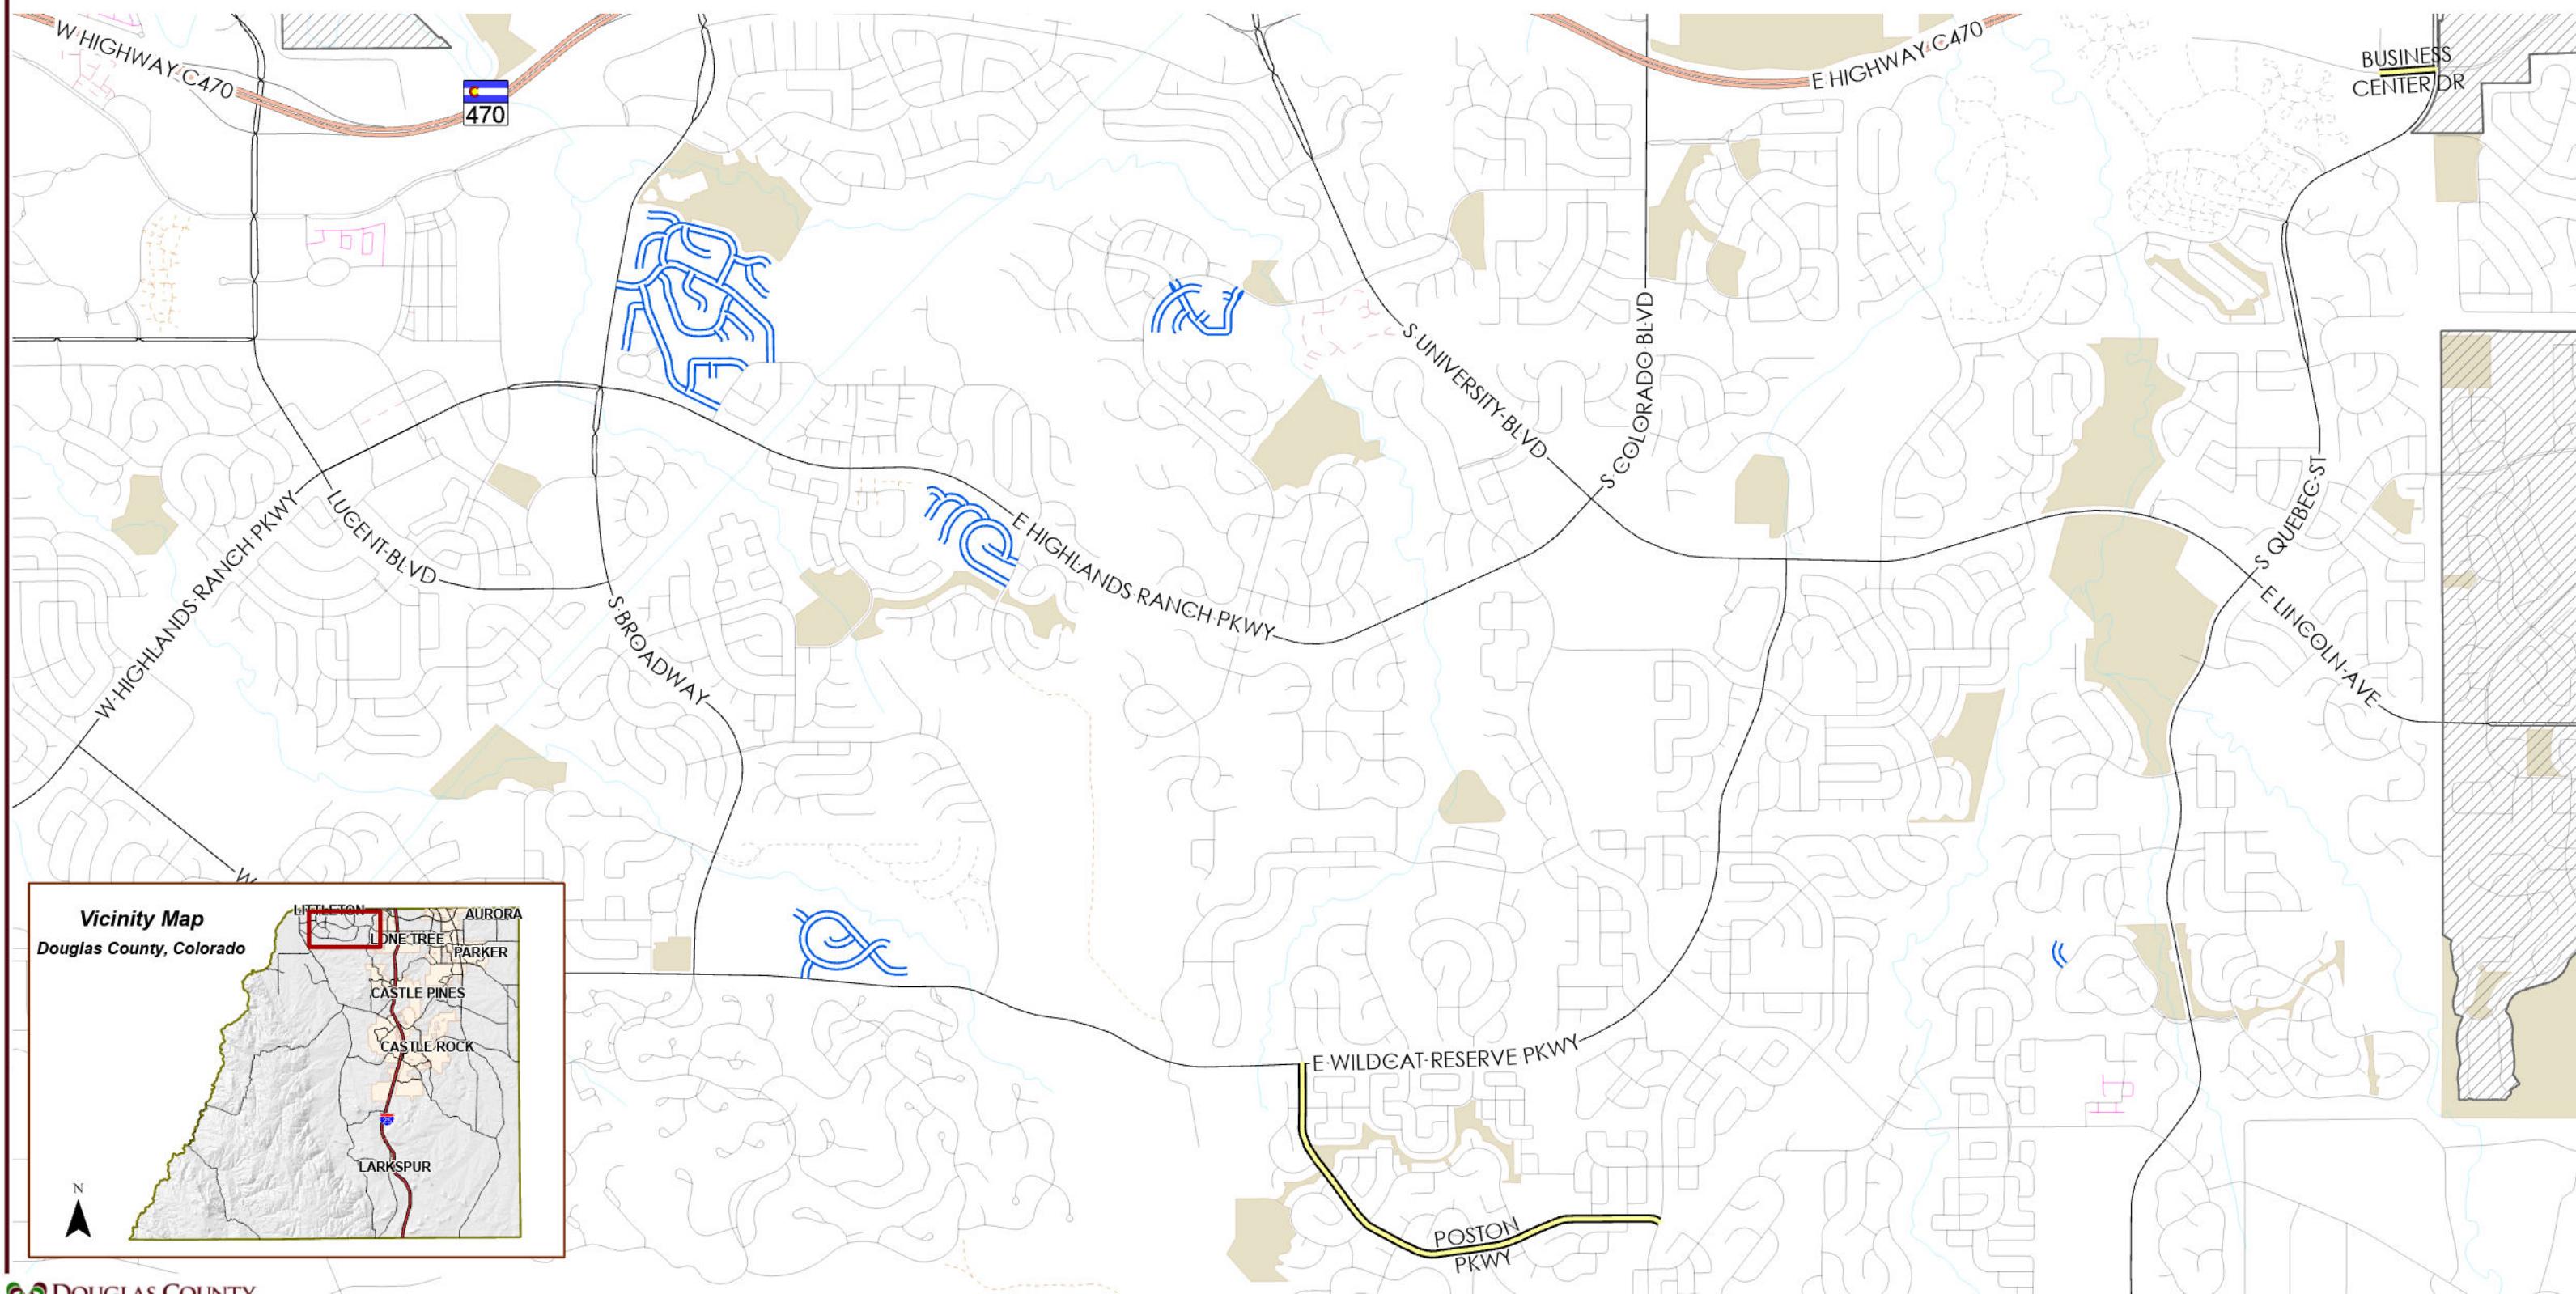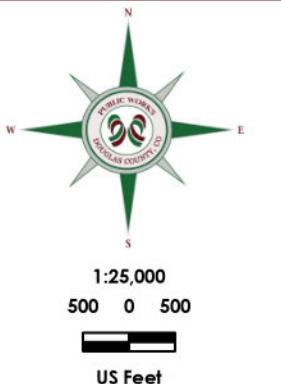


**As Built
2022 Contract Maintenance Projects
Douglas County, Colorado**

- HMA Overlay
- County Boundary
- Municipalities
- Parks
- Intermittent Lakes
- Streams
- Roads
- Major Road
- Local Road
- State Highway
- Toll Highway
- Private
- Platted Not Built
- Gated Community
- Access Easement
- Entrance/Exit Ramp

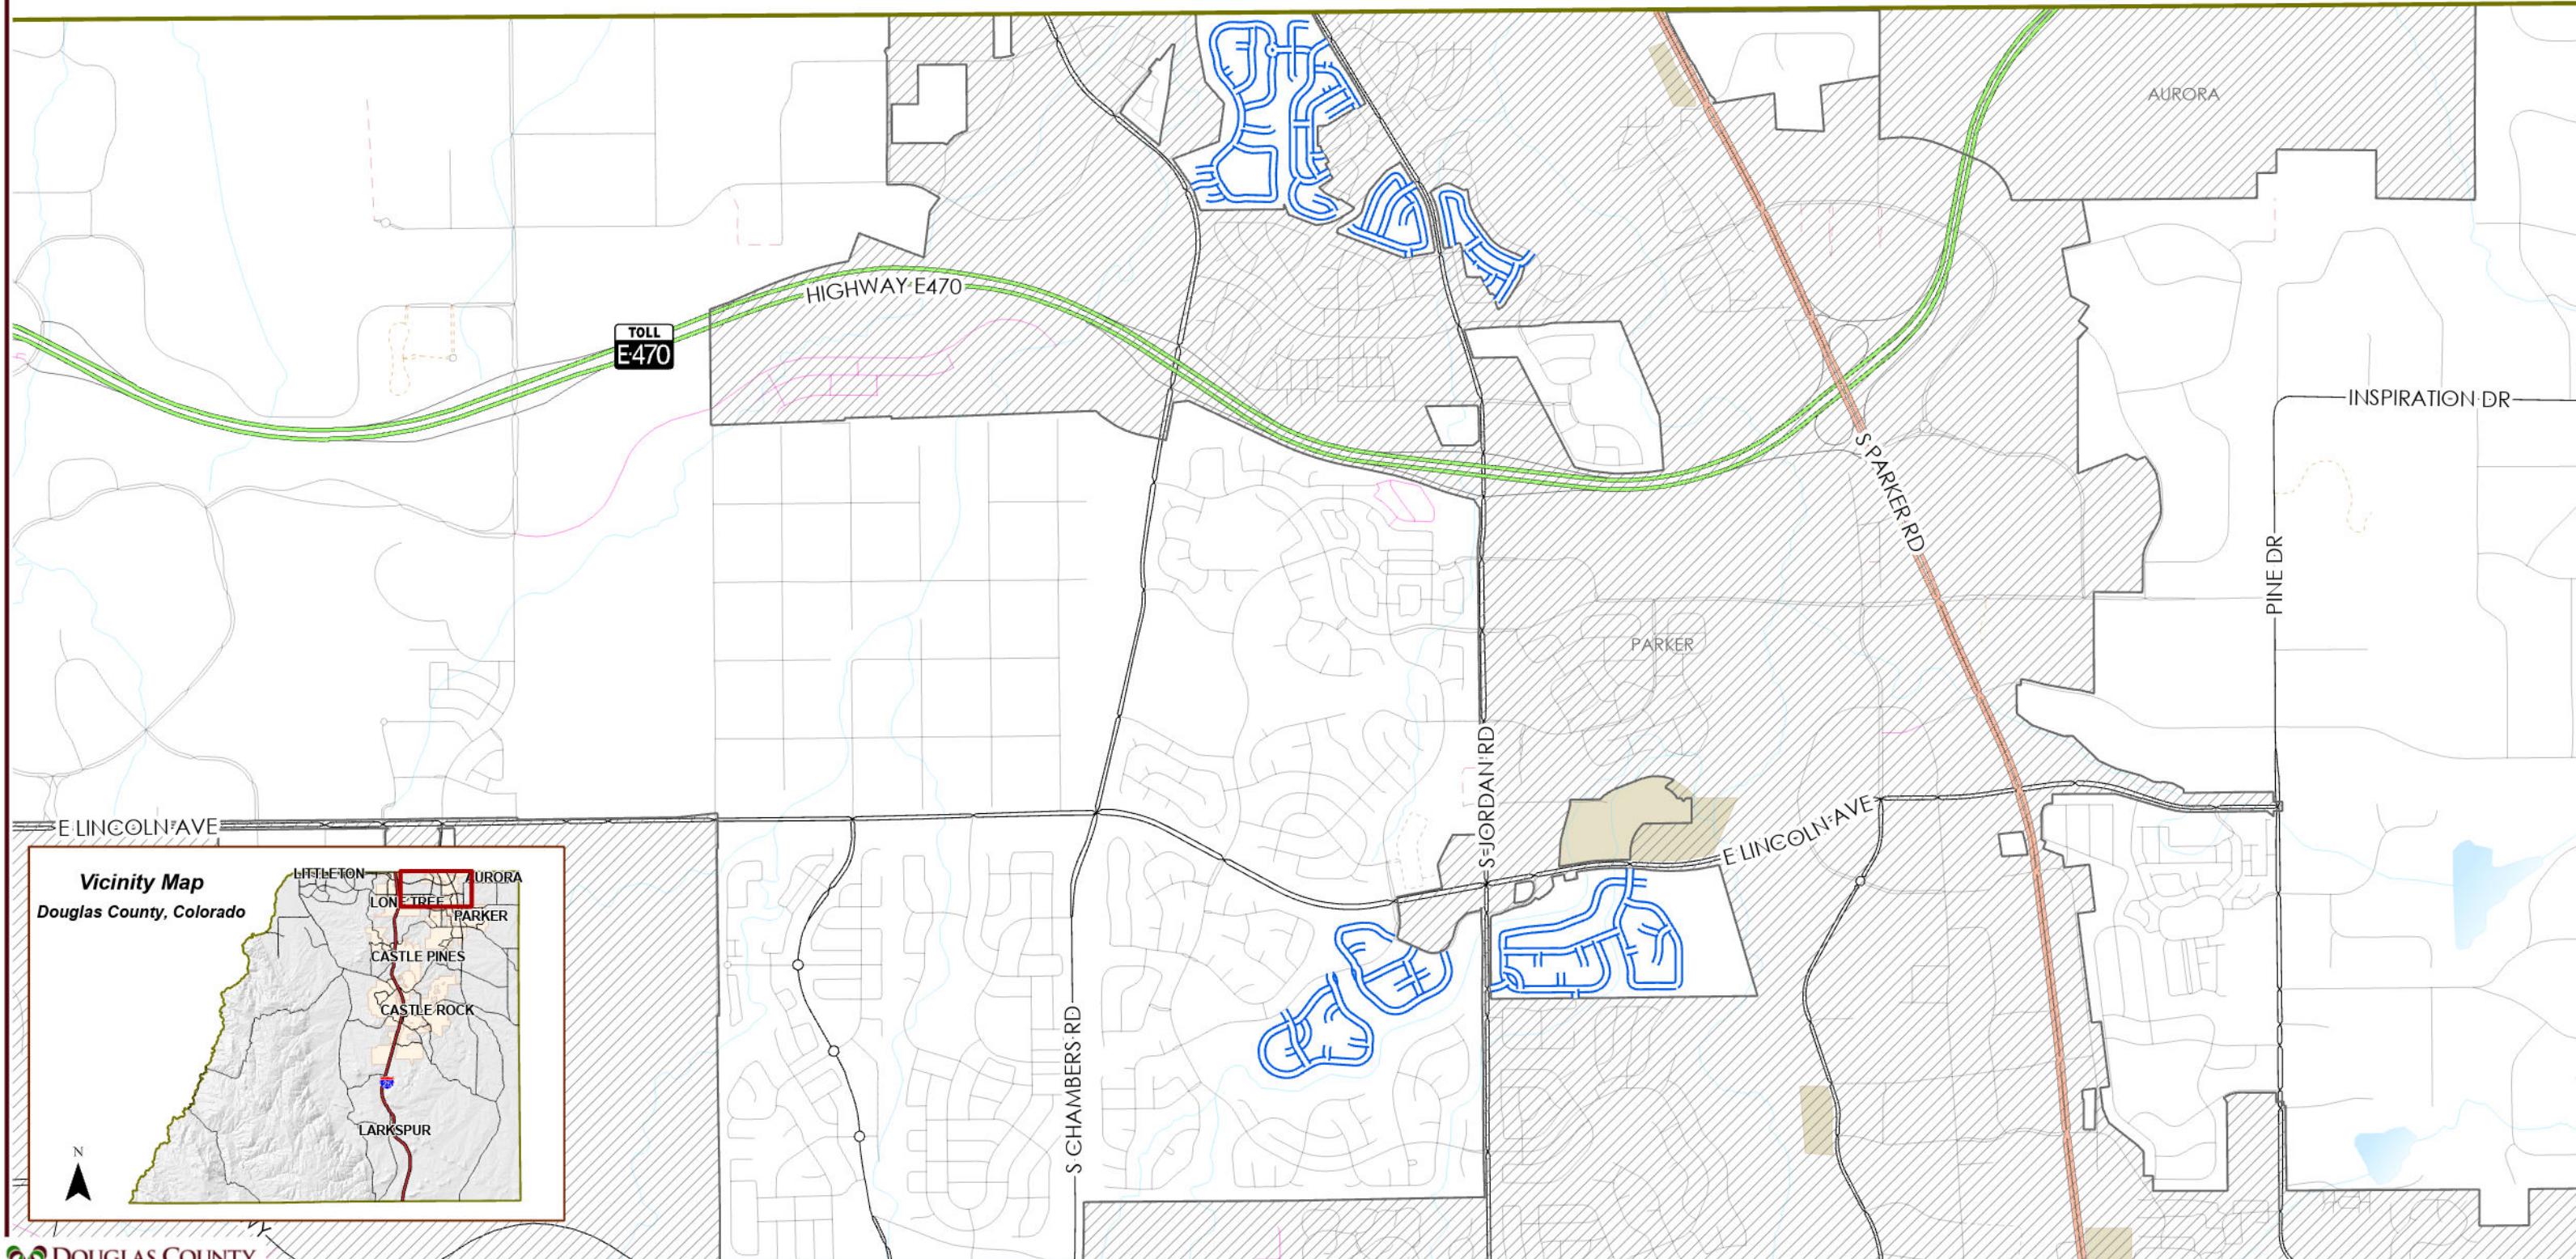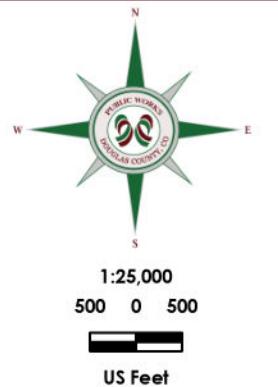


**As Built
2022 Contract Maintenance Projects
Douglas County, Colorado**

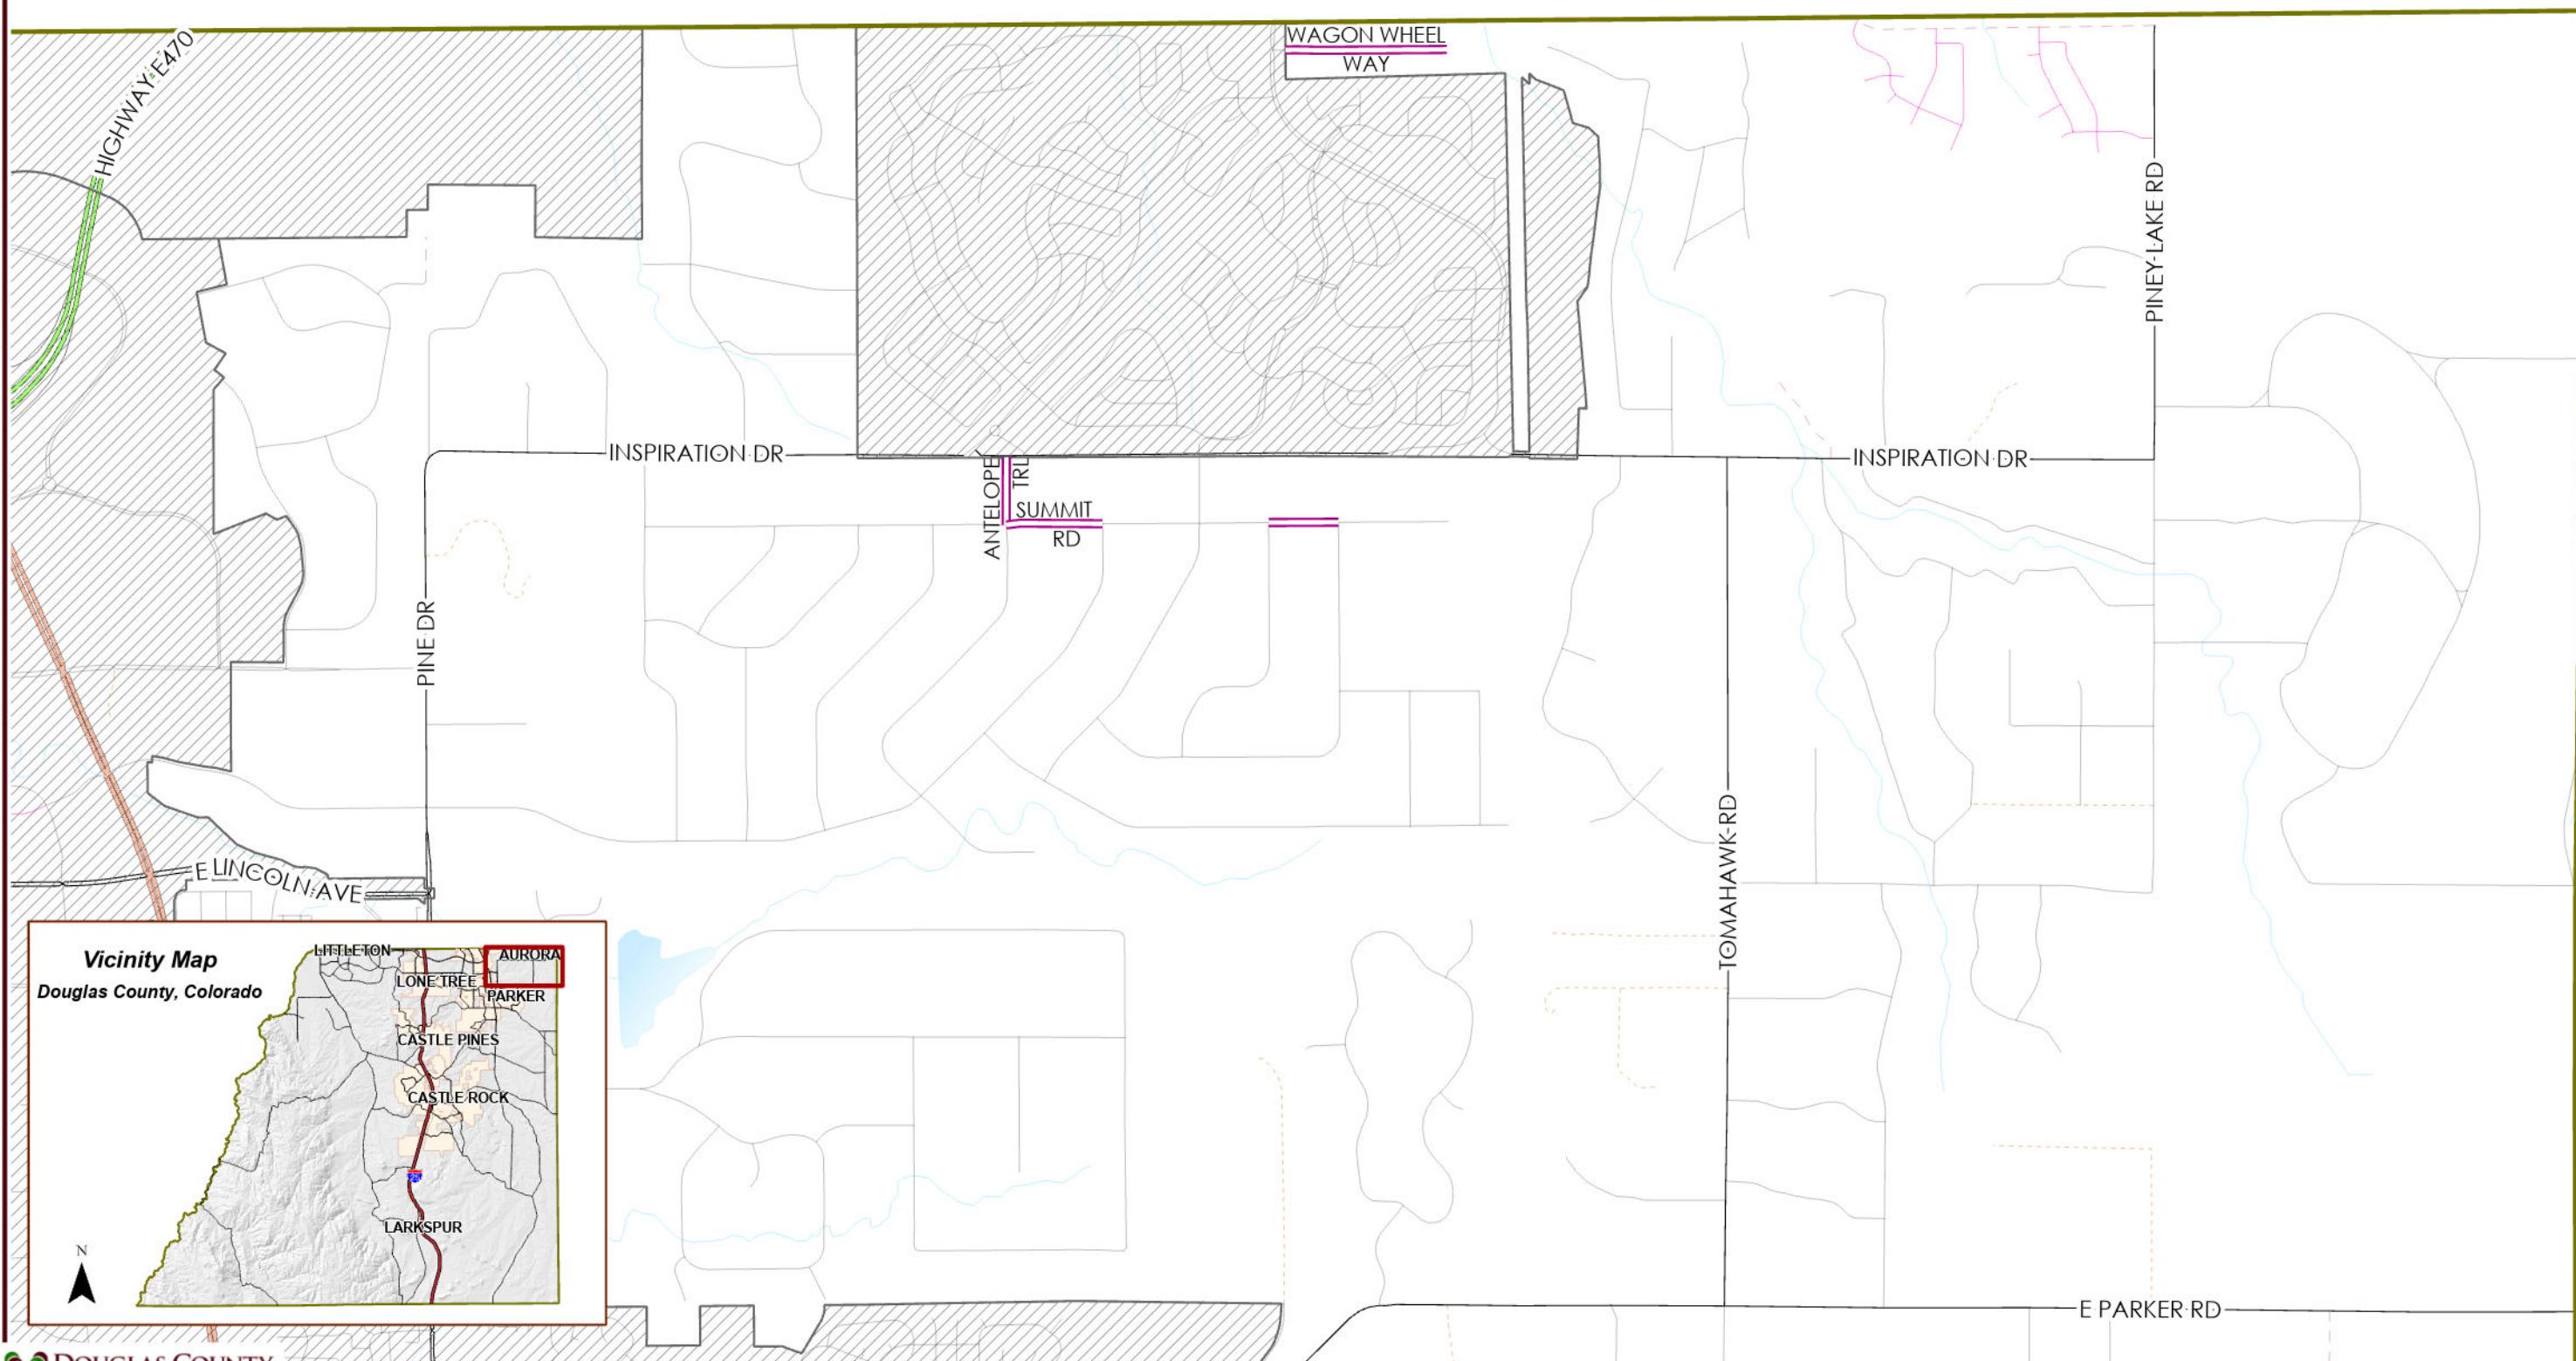



**As Built
2022 Contract Maintenance Projects
Douglas County, Colorado**

	HMA Overlay		Roads		Private
	County Boundary		US Highway		Gated Community
	Parks		State Highway		Access Easement
	Lakes		Major Road		
	Streams		Local Road		

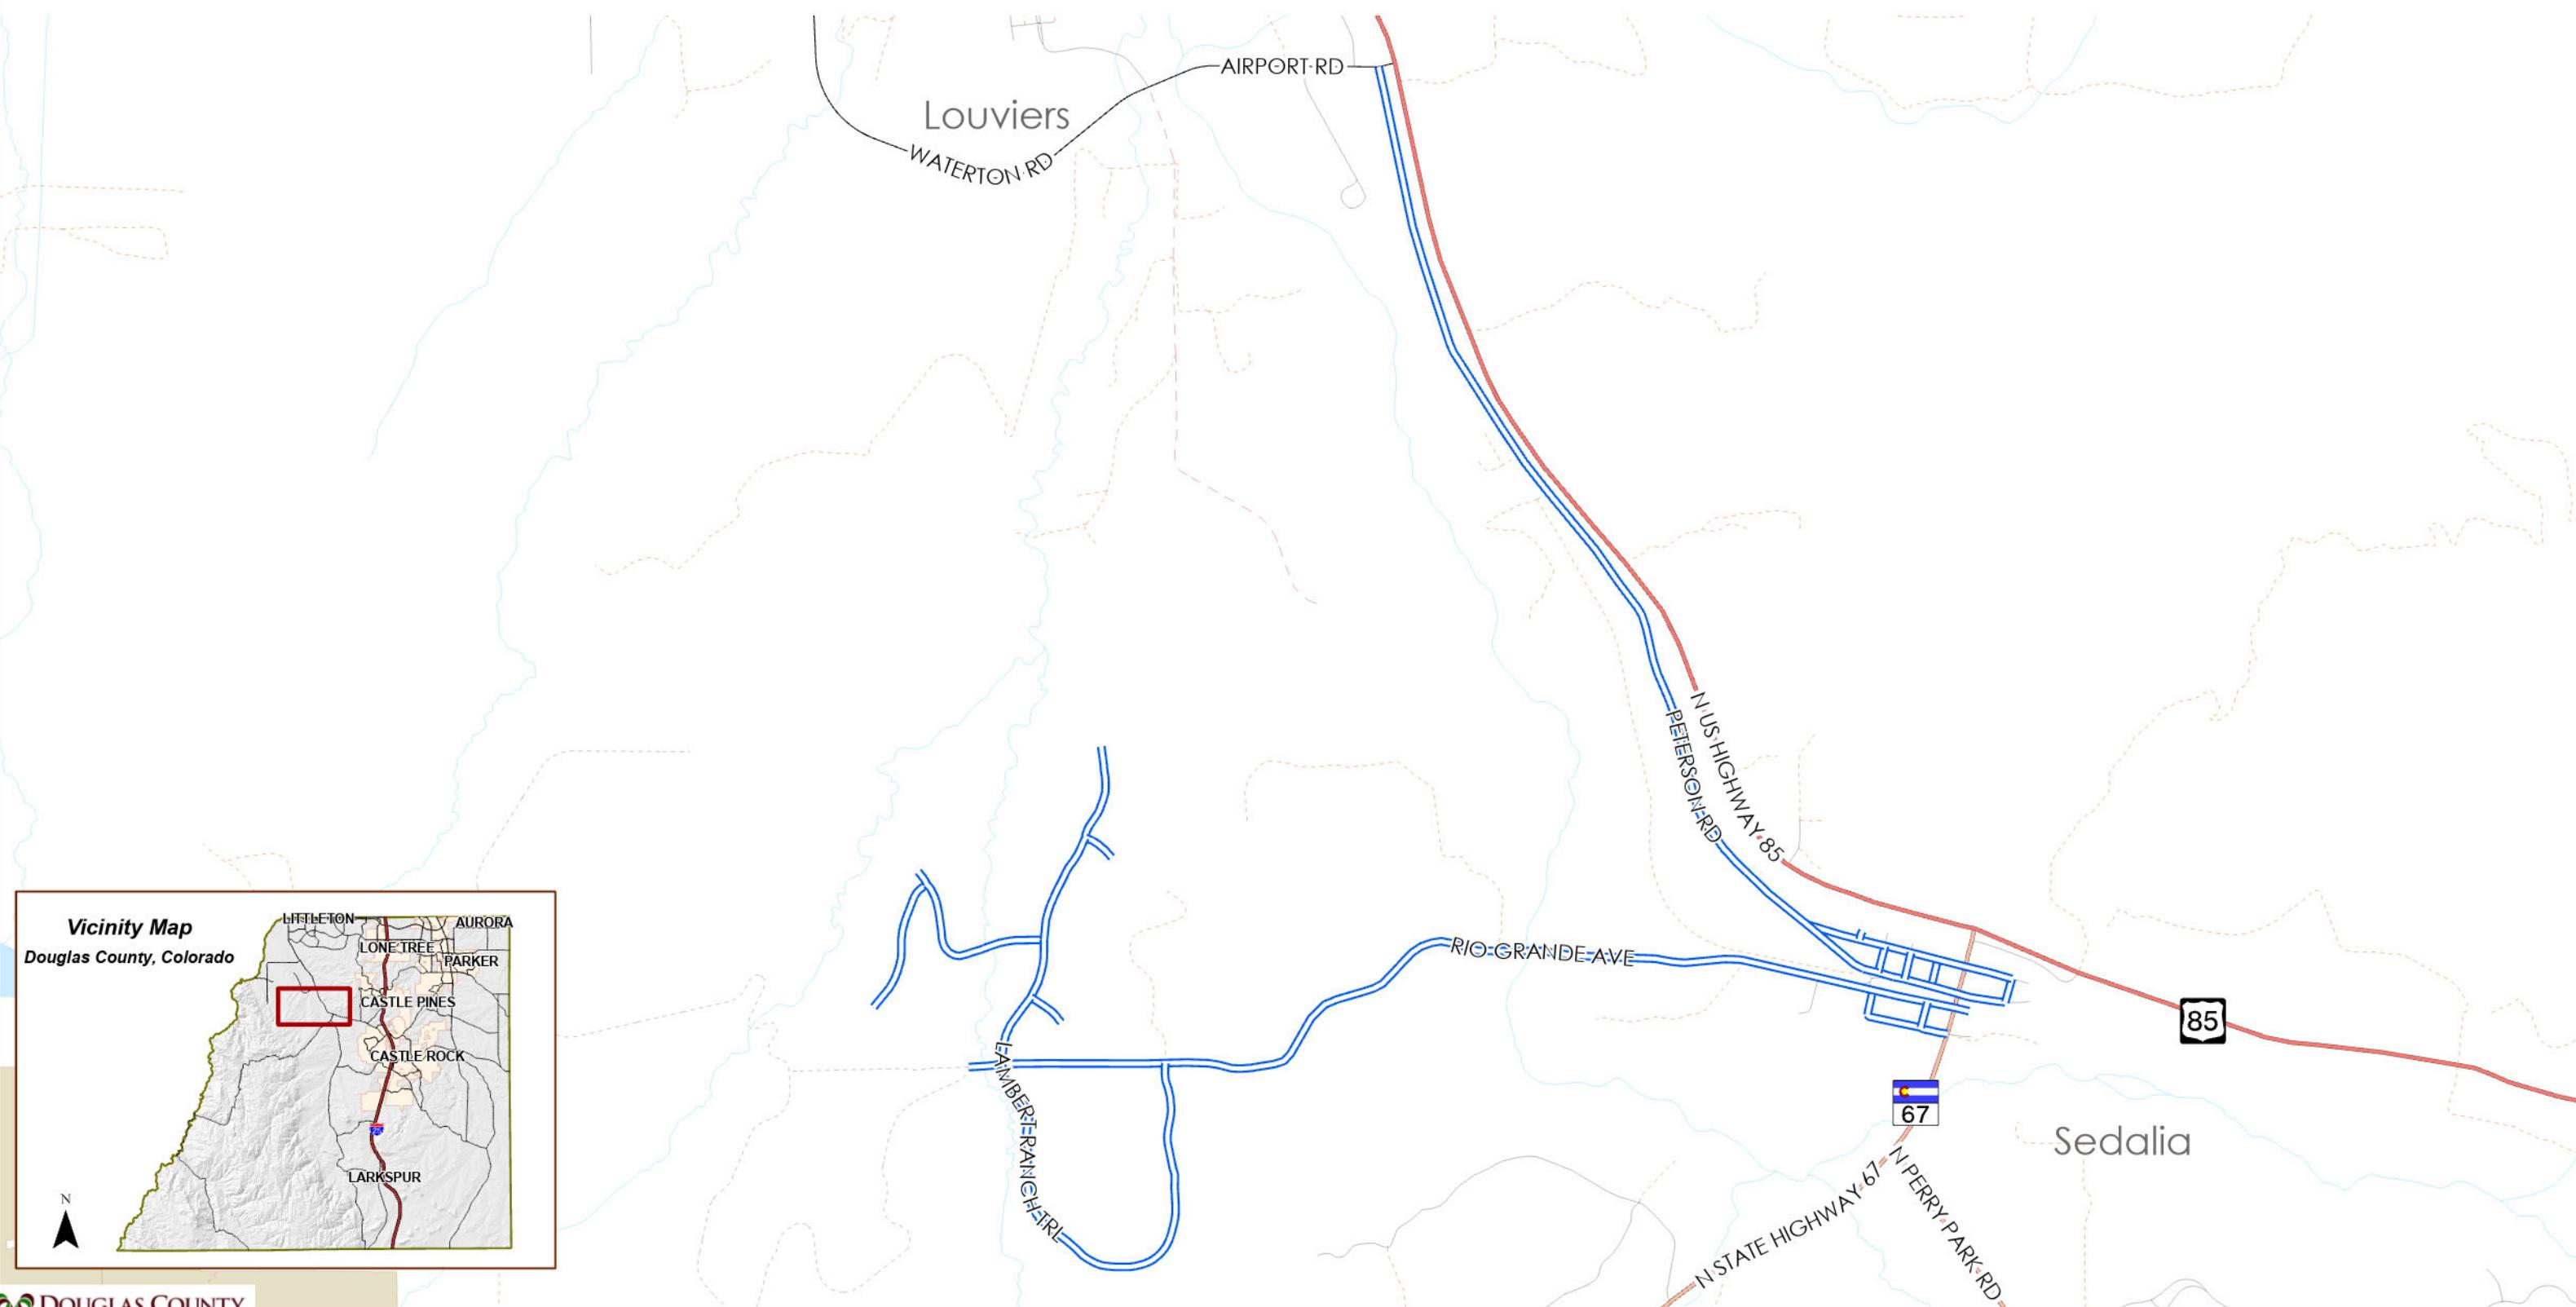



**As Built
2022 Contract Maintenance Projects
Douglas County, Colorado**

- HMA Overlay
- SMA Overlay
- County Boundary
- Municipalities
- Parks
- Lakes
- Streams
- State Highway
- Major Road
- Local Road
- Interstate
- US Highway
- Roads
- Private
- Platted Not Built
- Gated Community
- Access Easement
- Entrance/Exit Ramp

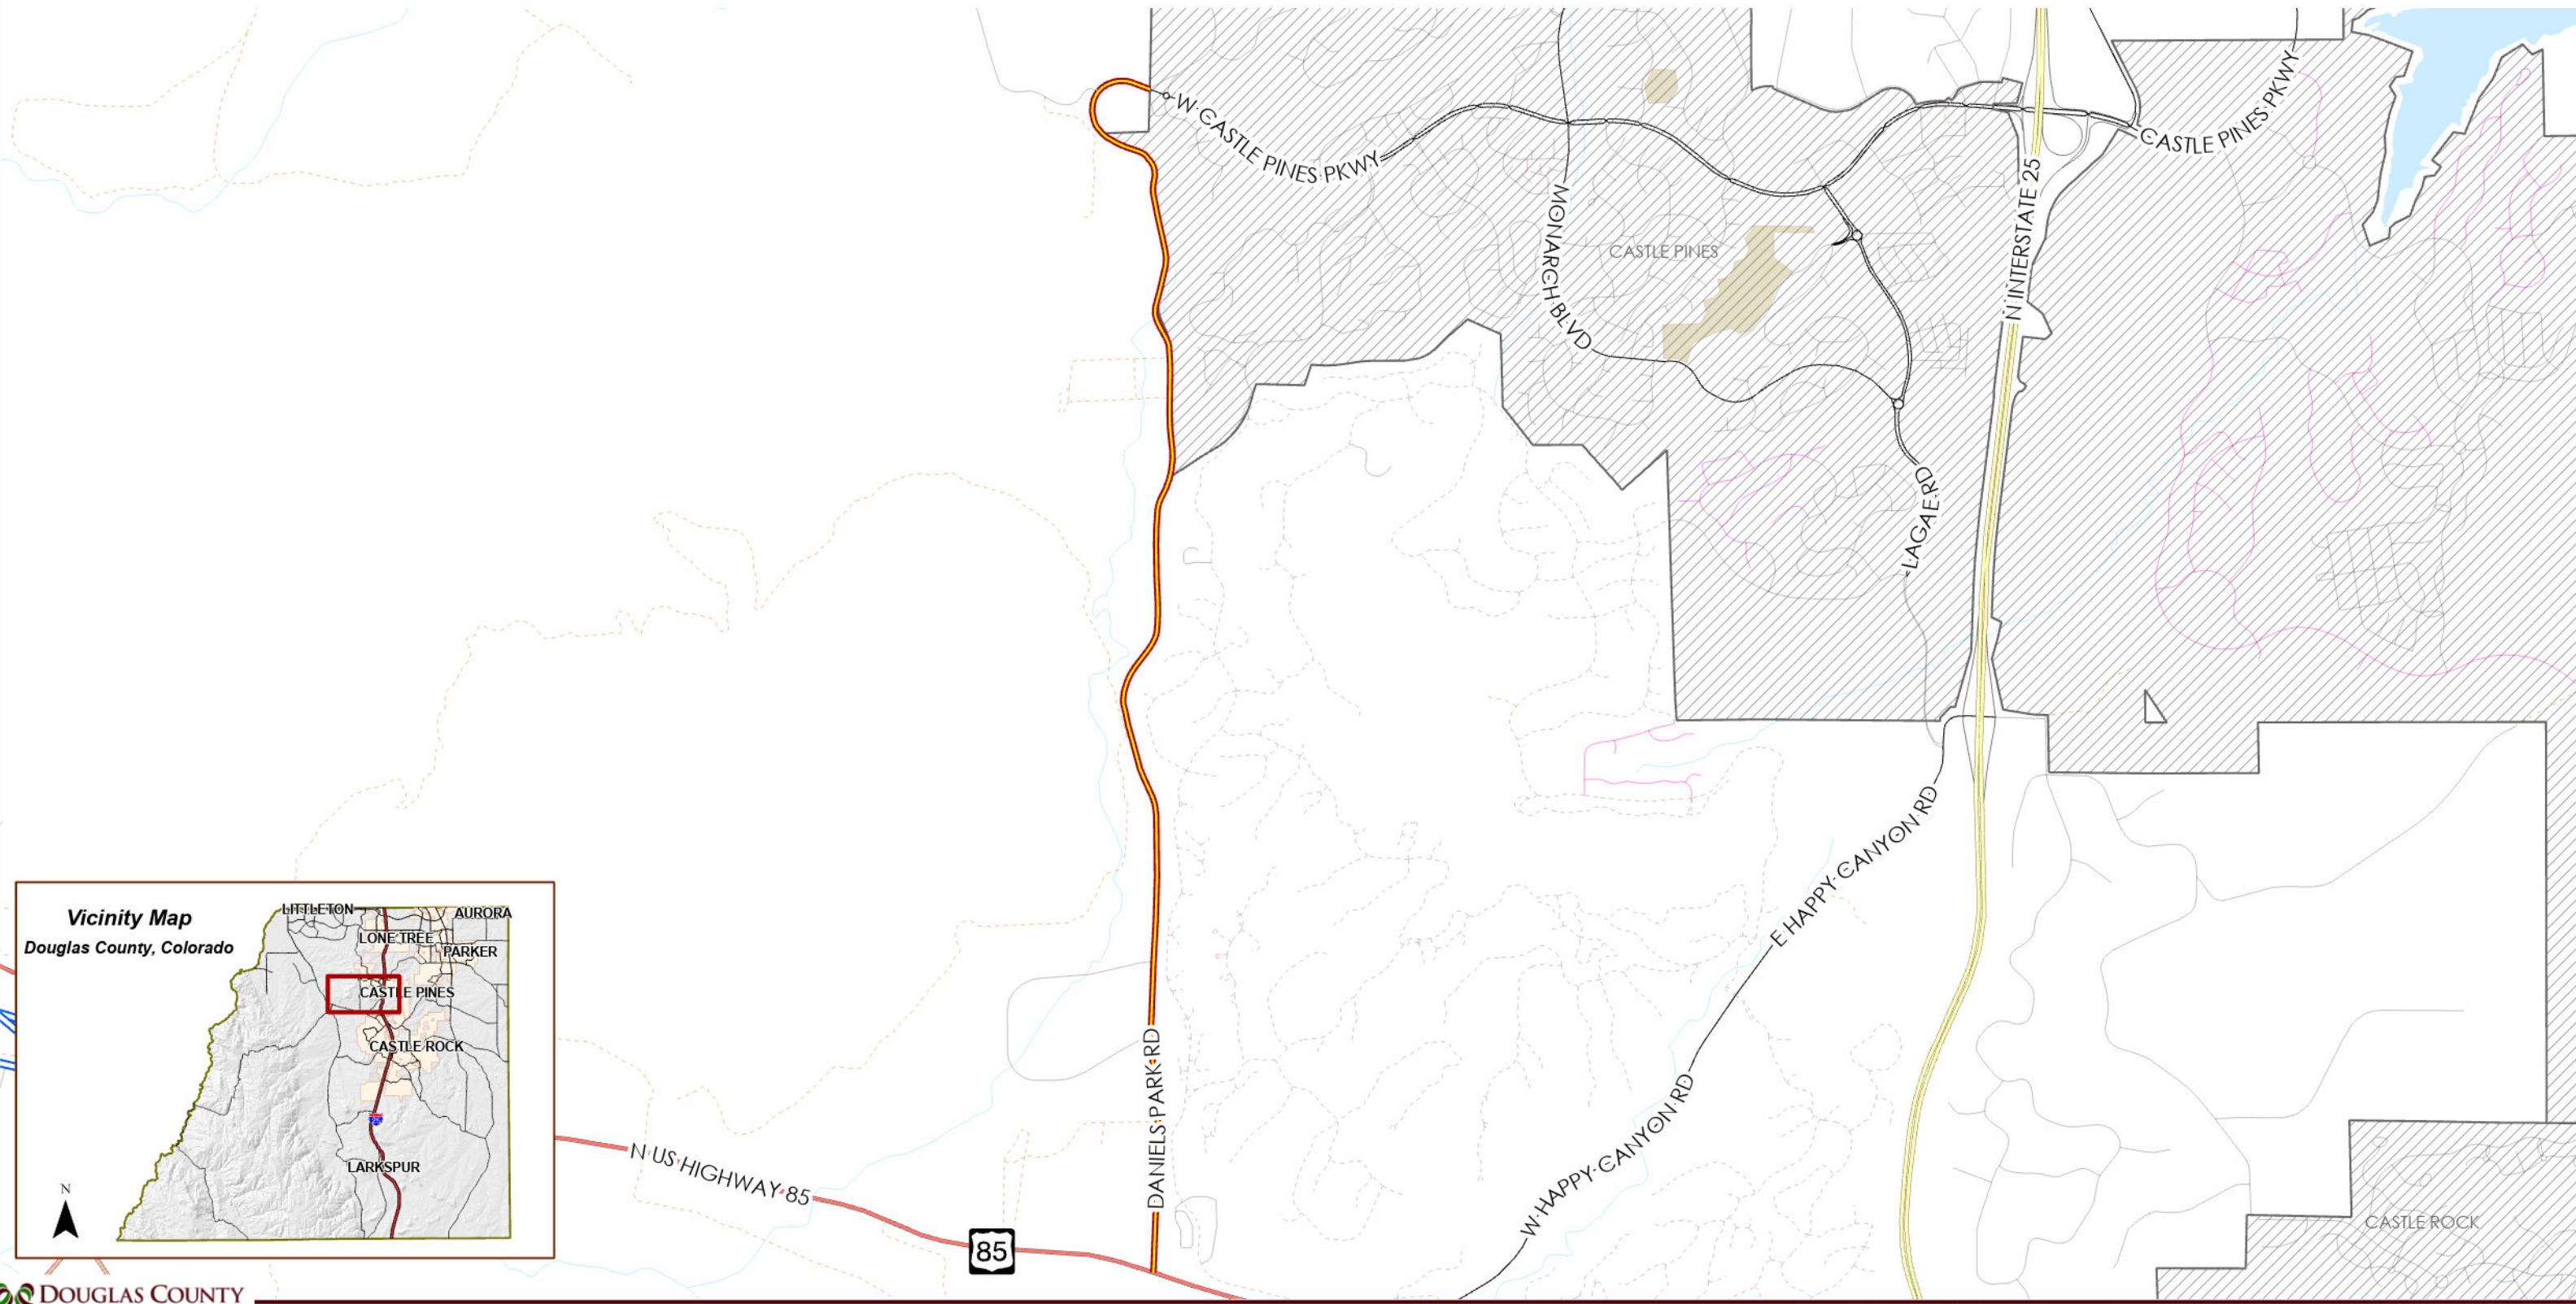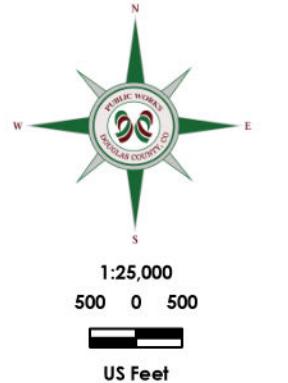


**As Built
2022 Contract Maintenance Projects
Douglas County, Colorado**

- Asphalt Full Depth
- County Boundary
- Municipalities
- Parks
- Intermittent Lakes
- Streams
- Roads
- Major Road
- Local Road
- Private
- State Highway
- Platted Not Built

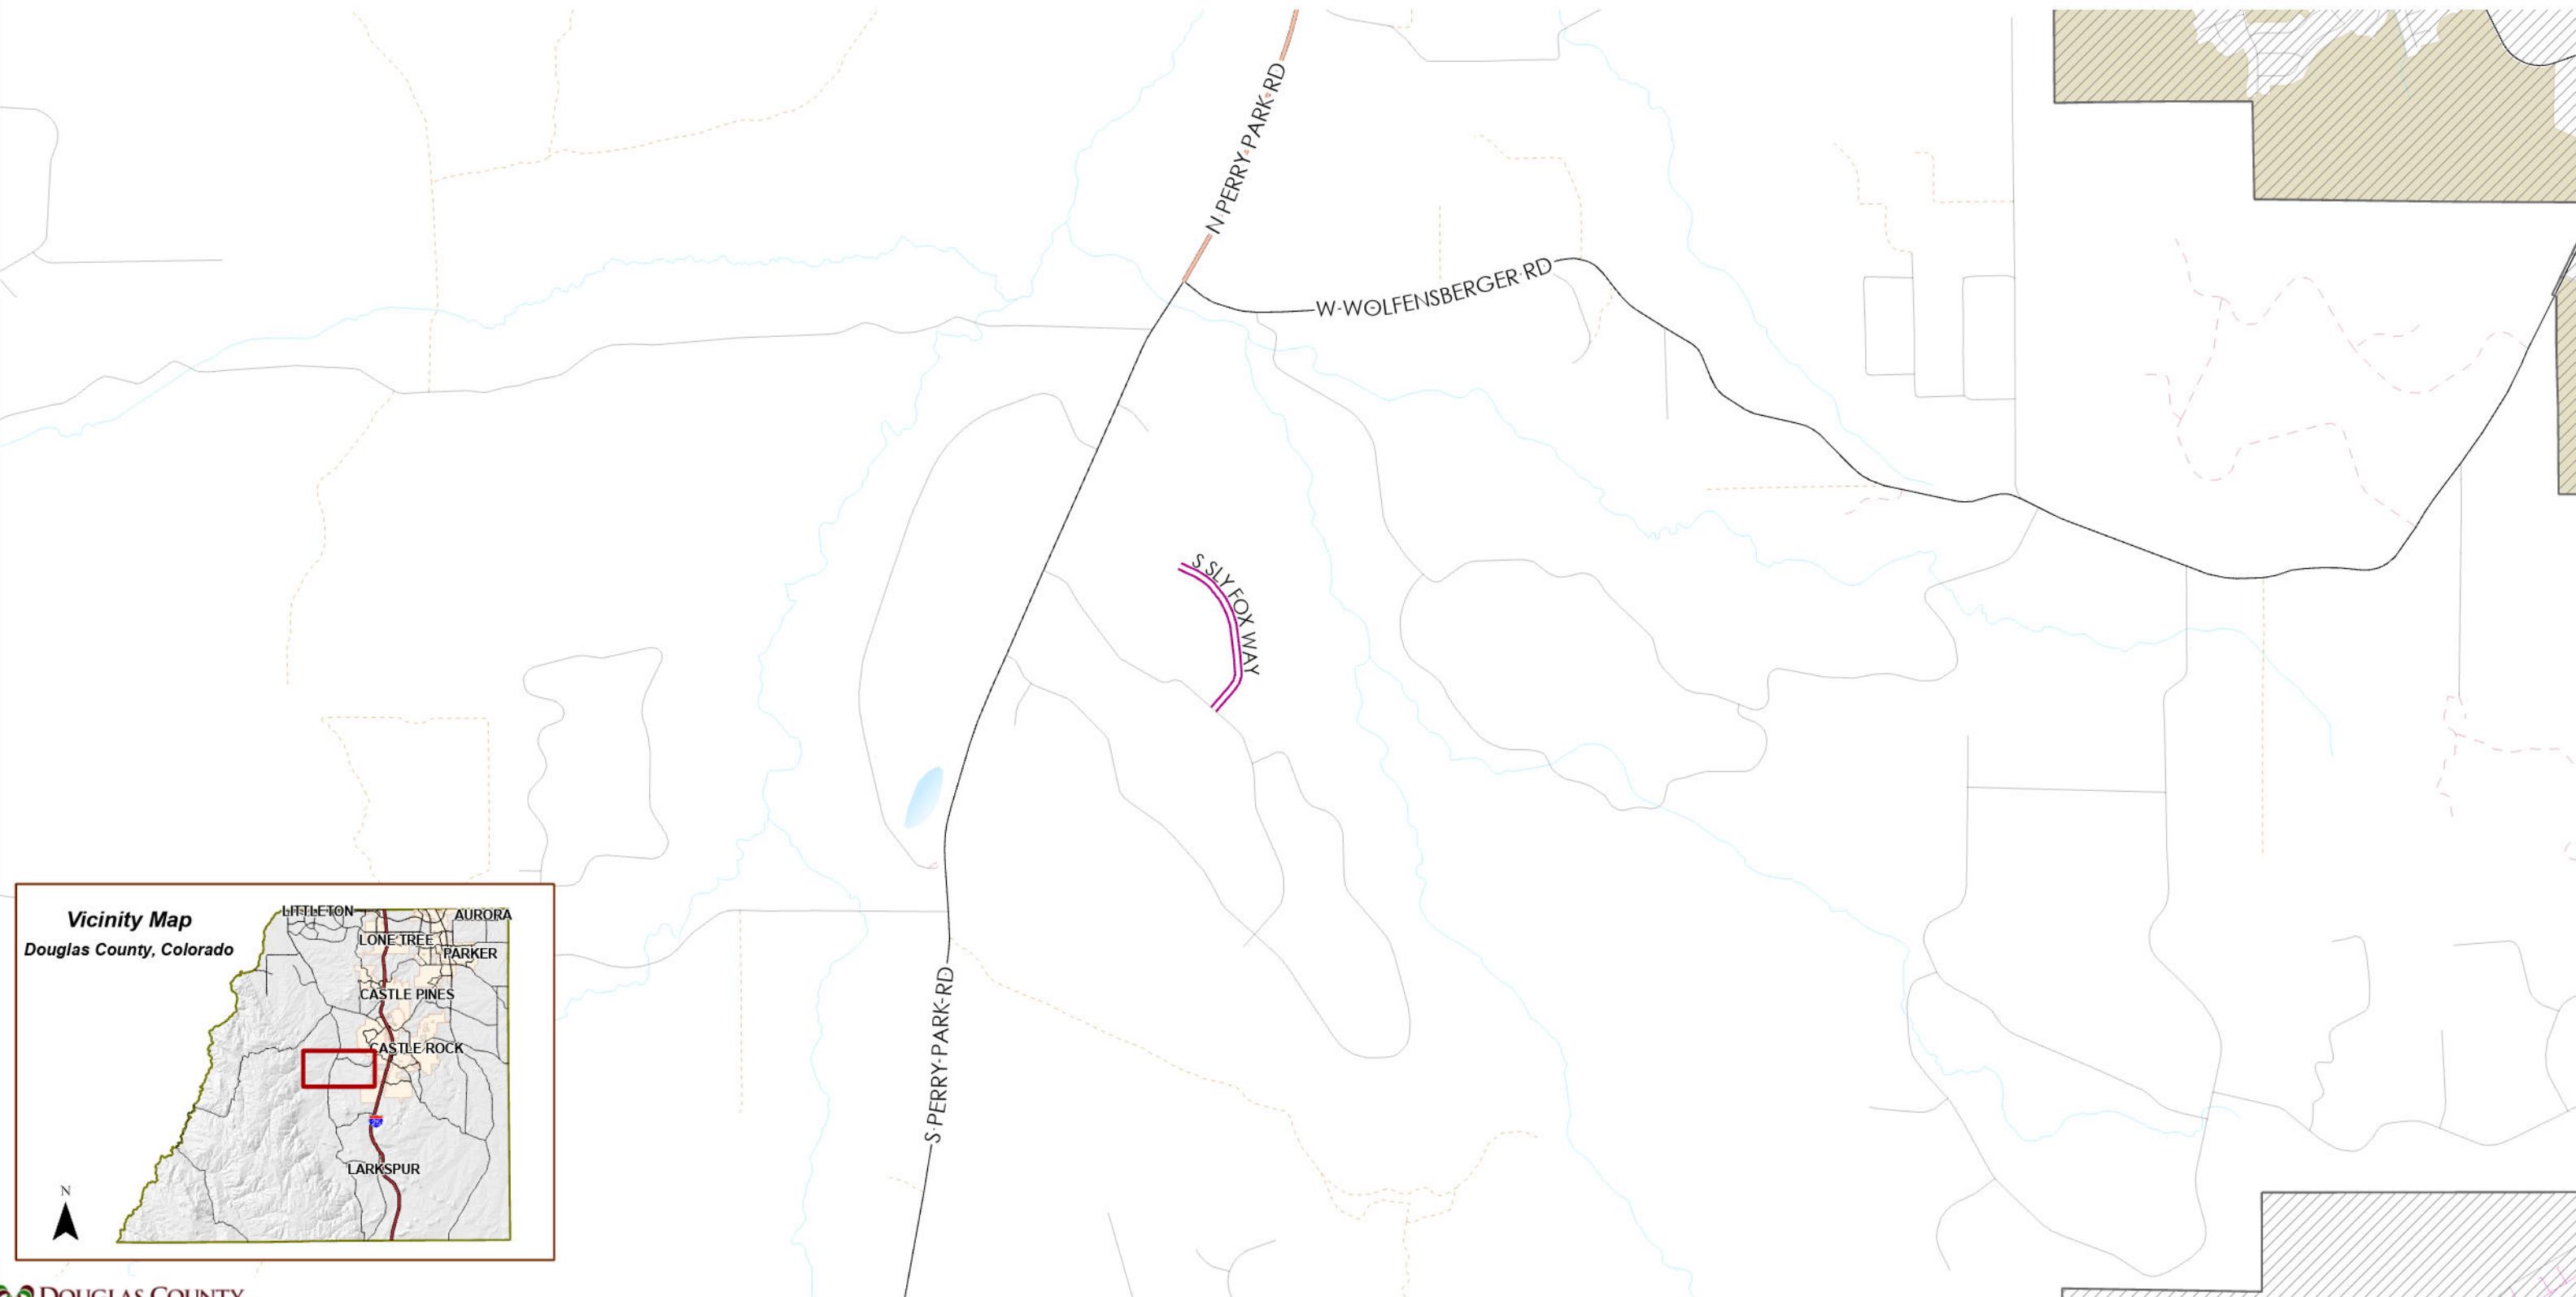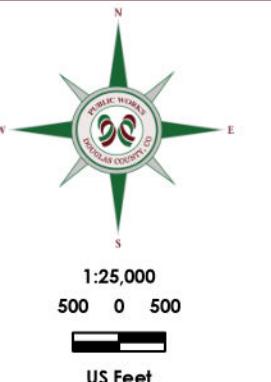



**As Built
2022 Contract Maintenance Projects
Douglas County, Colorado**

- Asphalt Full Depth
- Roads
- County Boundary
- State Highway
- Parks
- Major Road
- Intermittent Lakes
- Local Road
- Streams
- Private
- Platted Not Built
- Gated Community



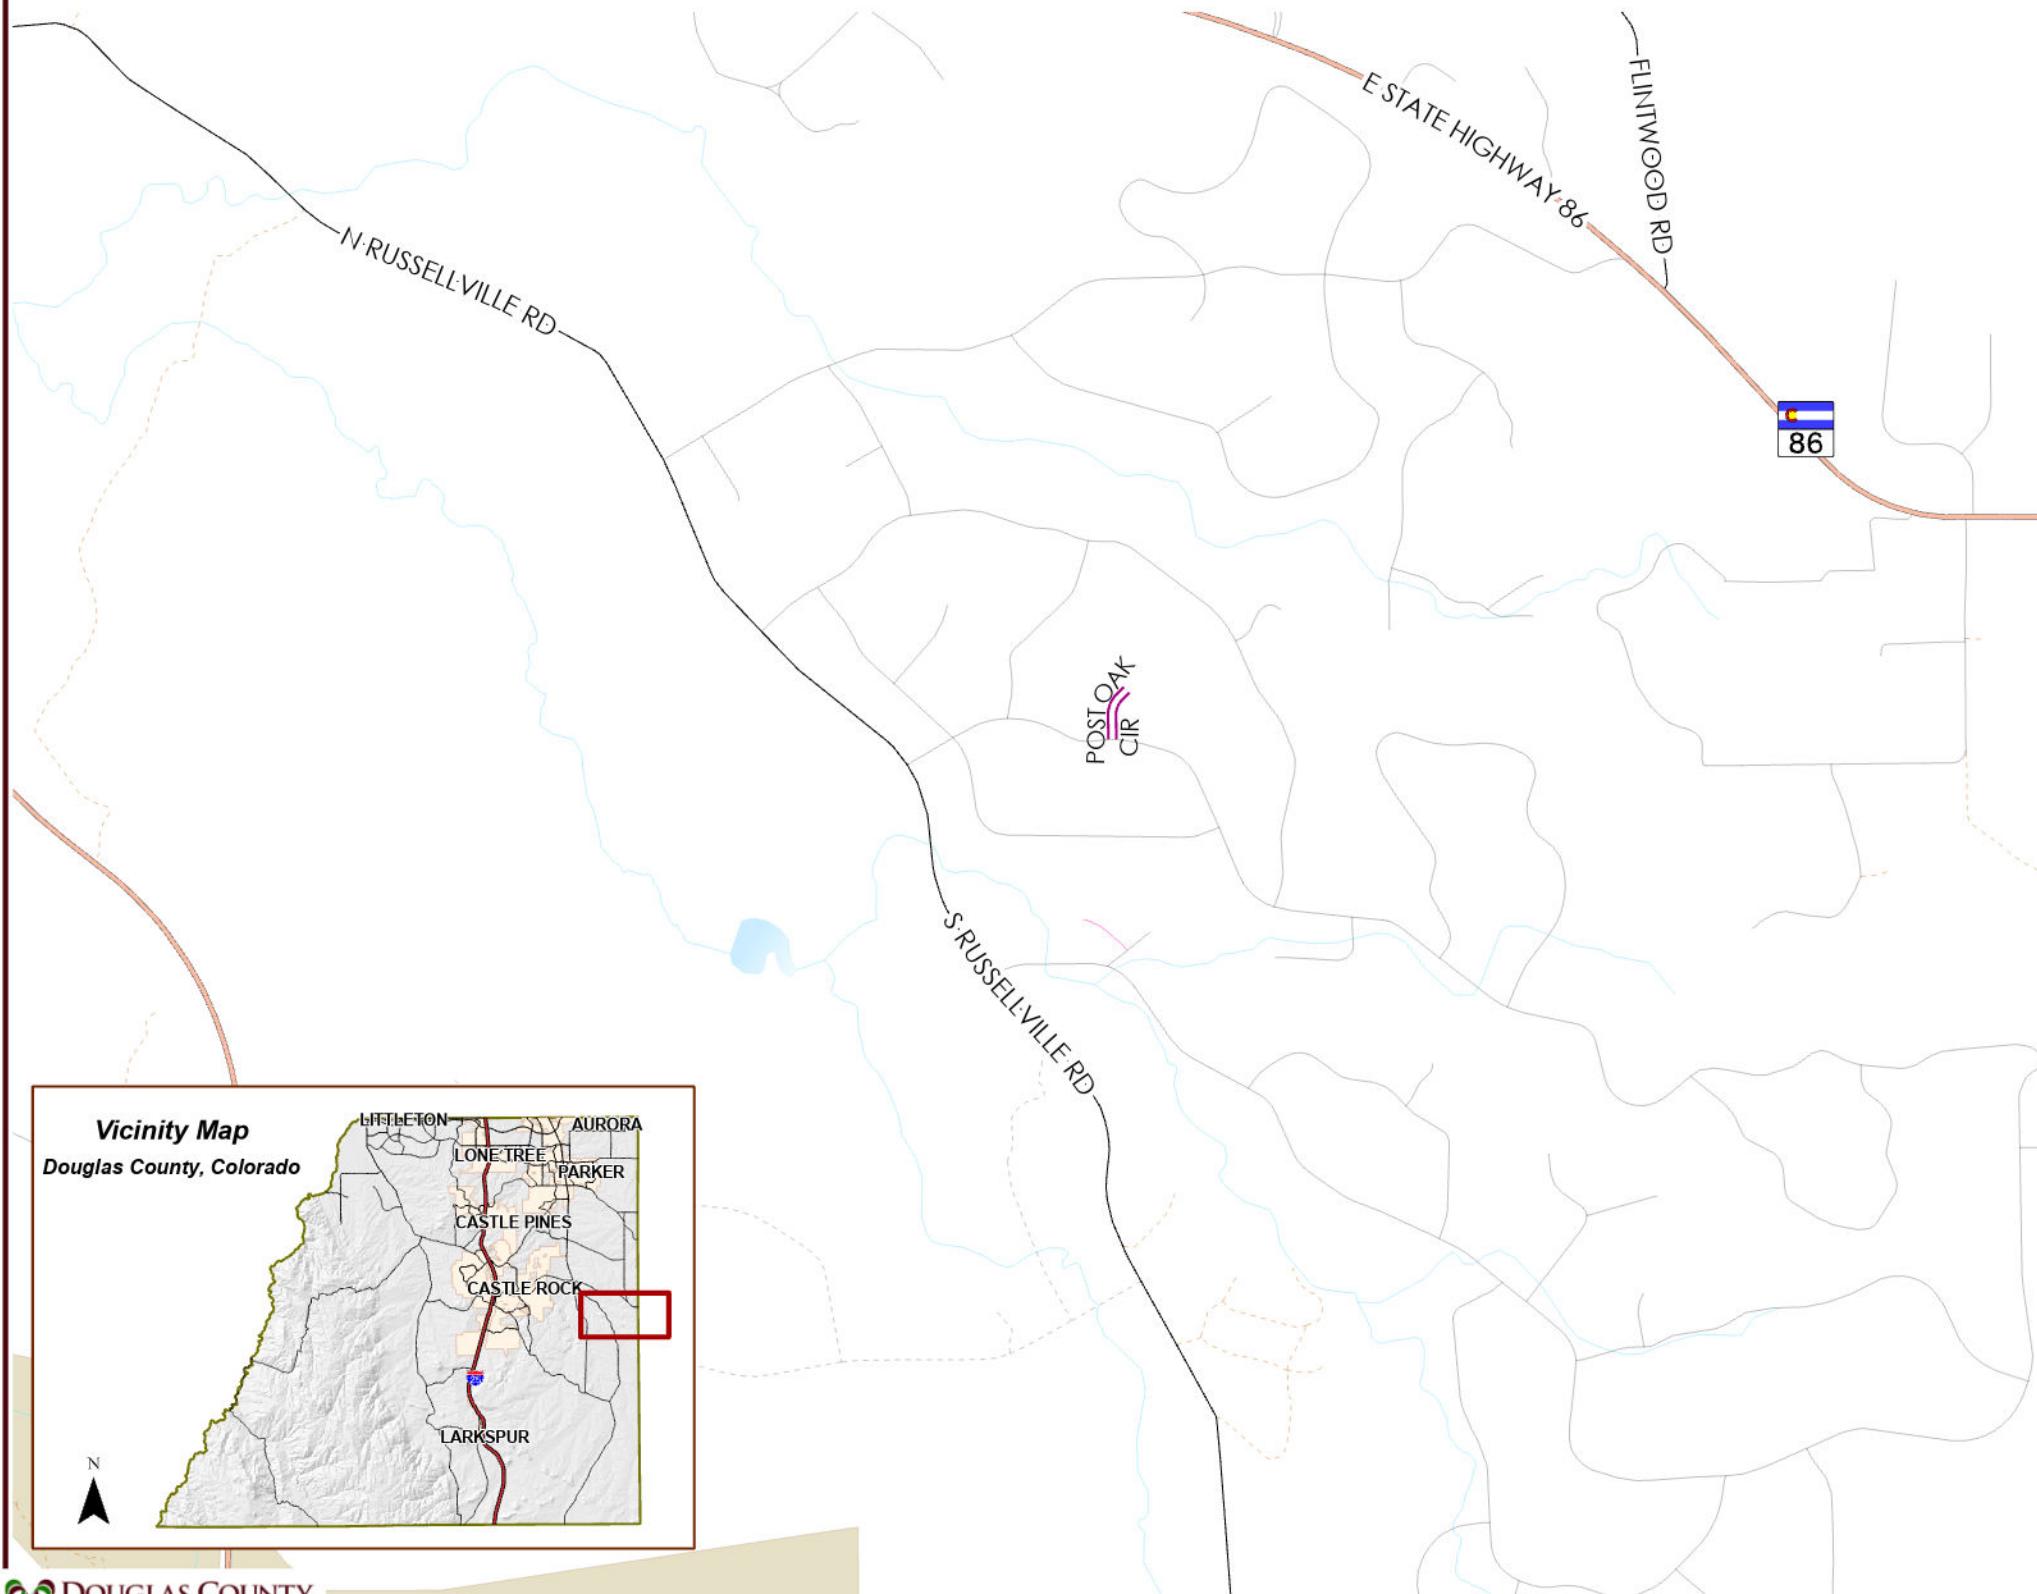


**As Built
2022 Contract Maintenance Projects
Douglas County, Colorado**

	Asphalt Full Depth		Lakes		Major Road		Access Easement
	County Boundary		Streams		Local Road		Entrance/Exit Ramp
	Municipalities		Roads		Private		Platted Not Built
	Parks		Interstate		Gated Community		
	Pike National Forest						

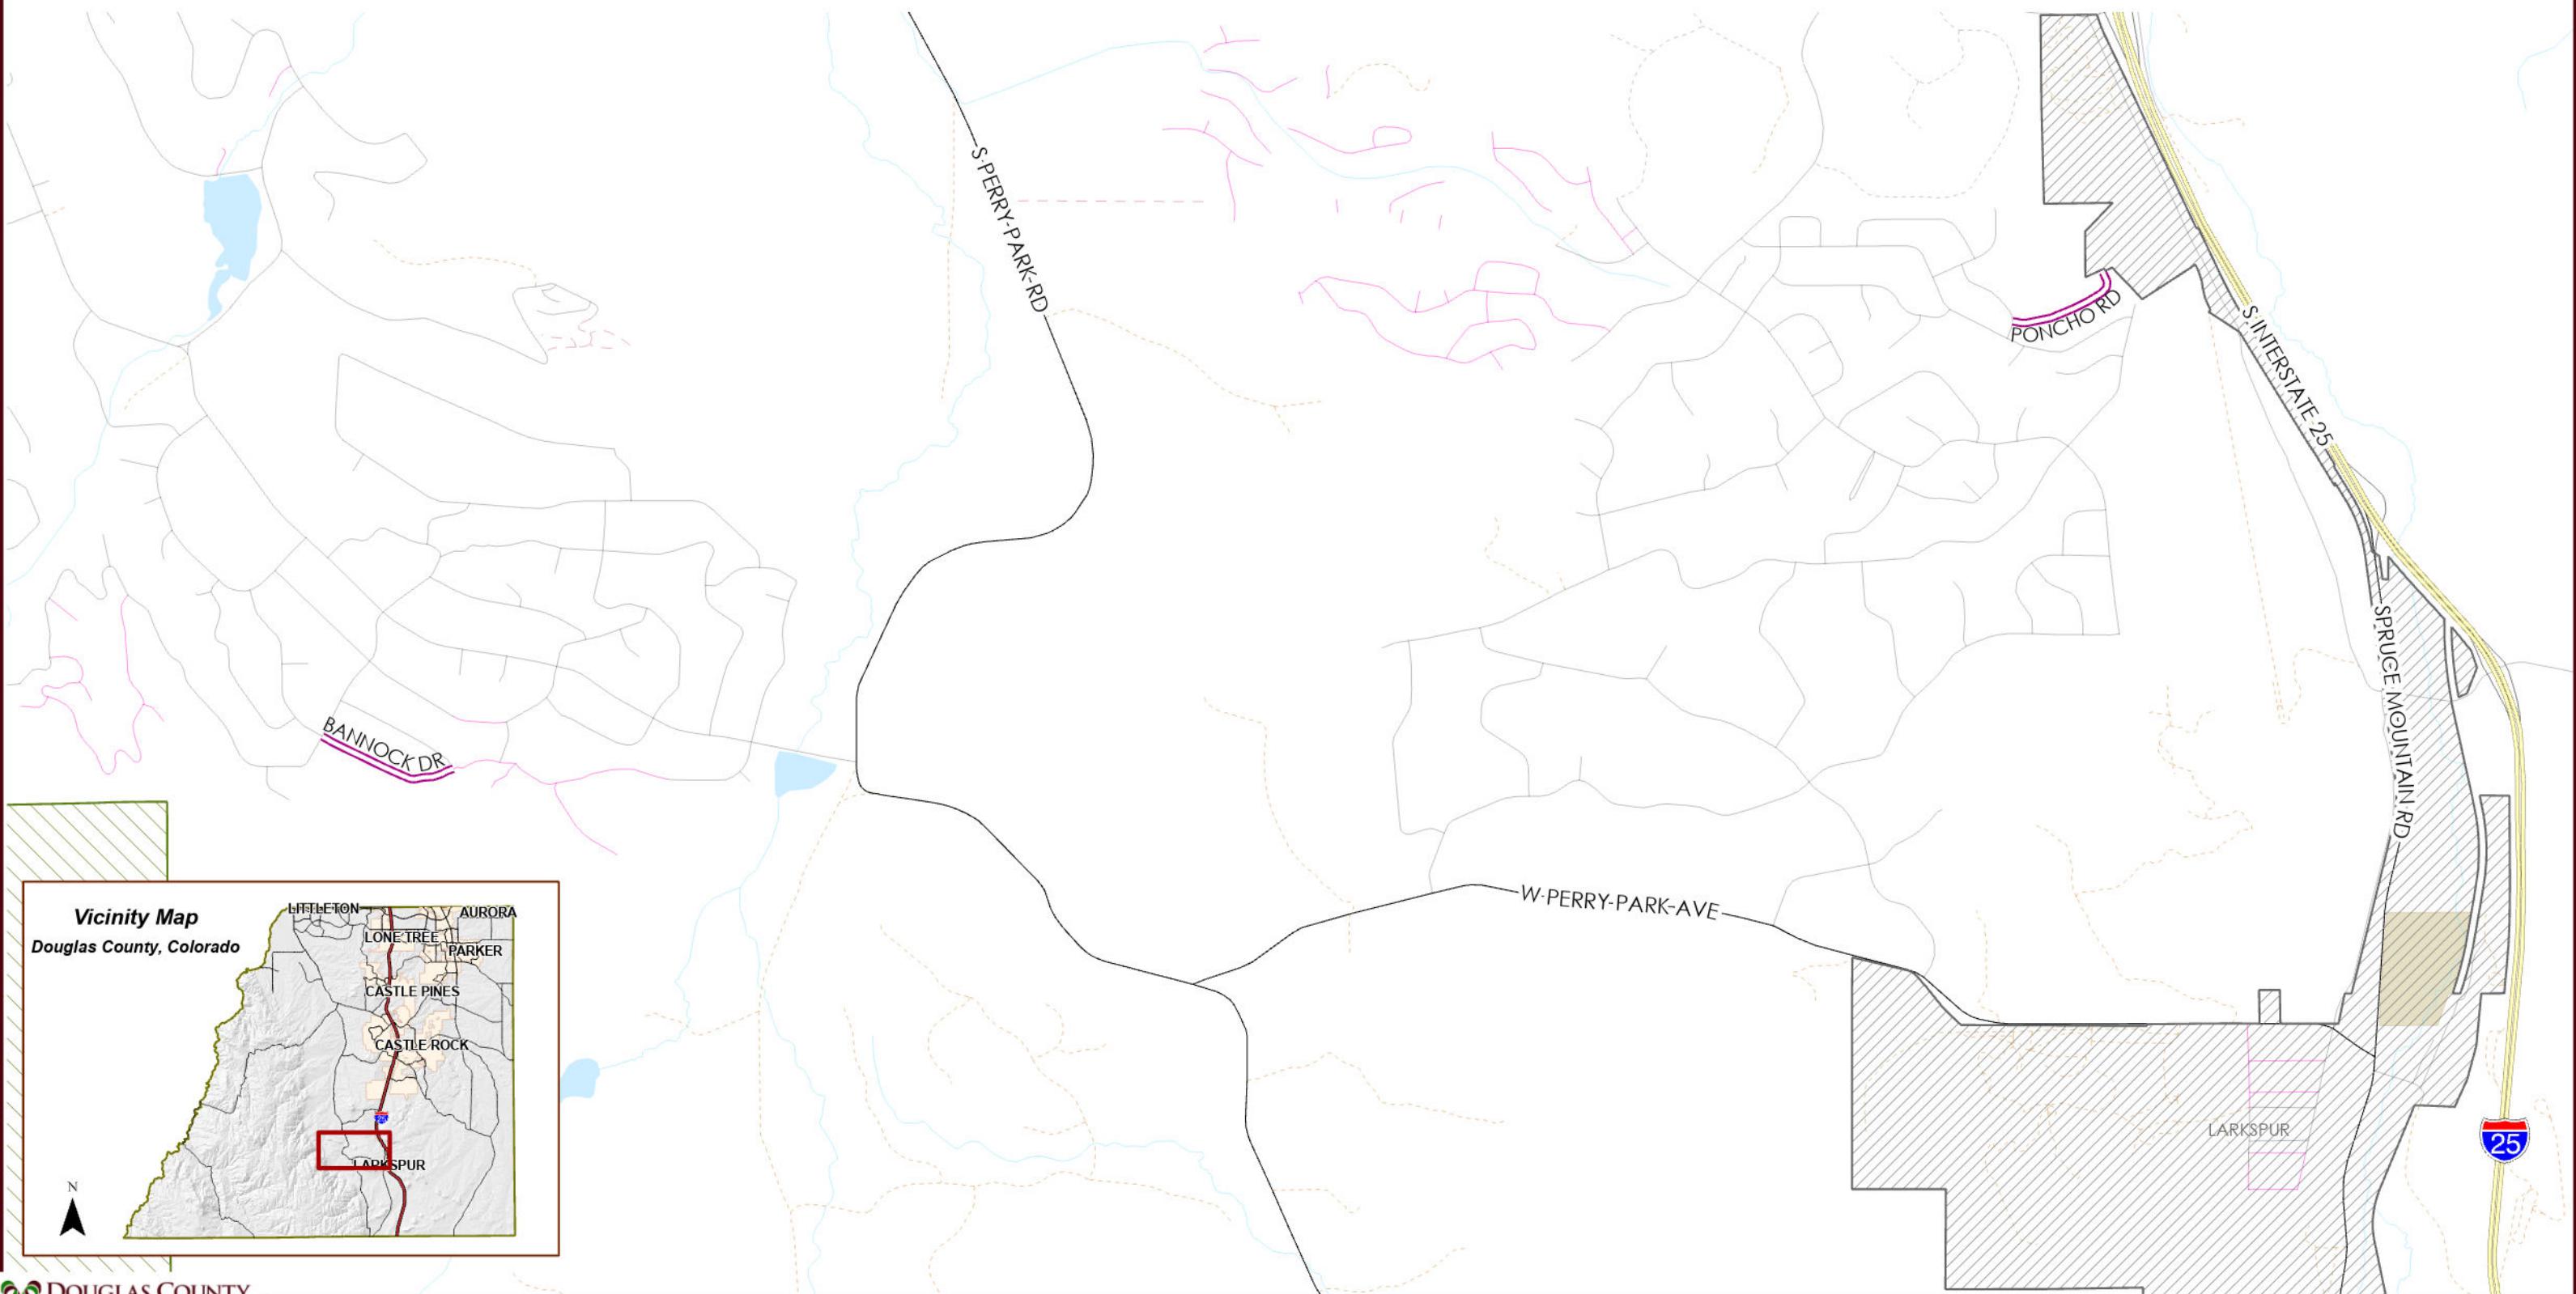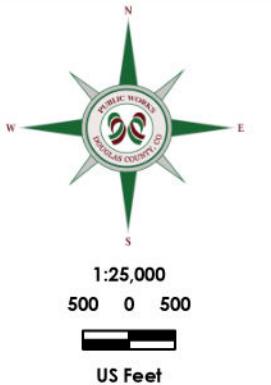

**As Built
2022 Contract Maintenance Projects
Douglas County, Colorado**

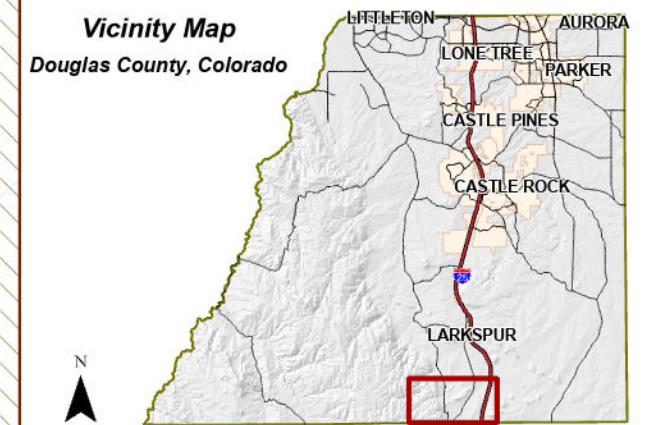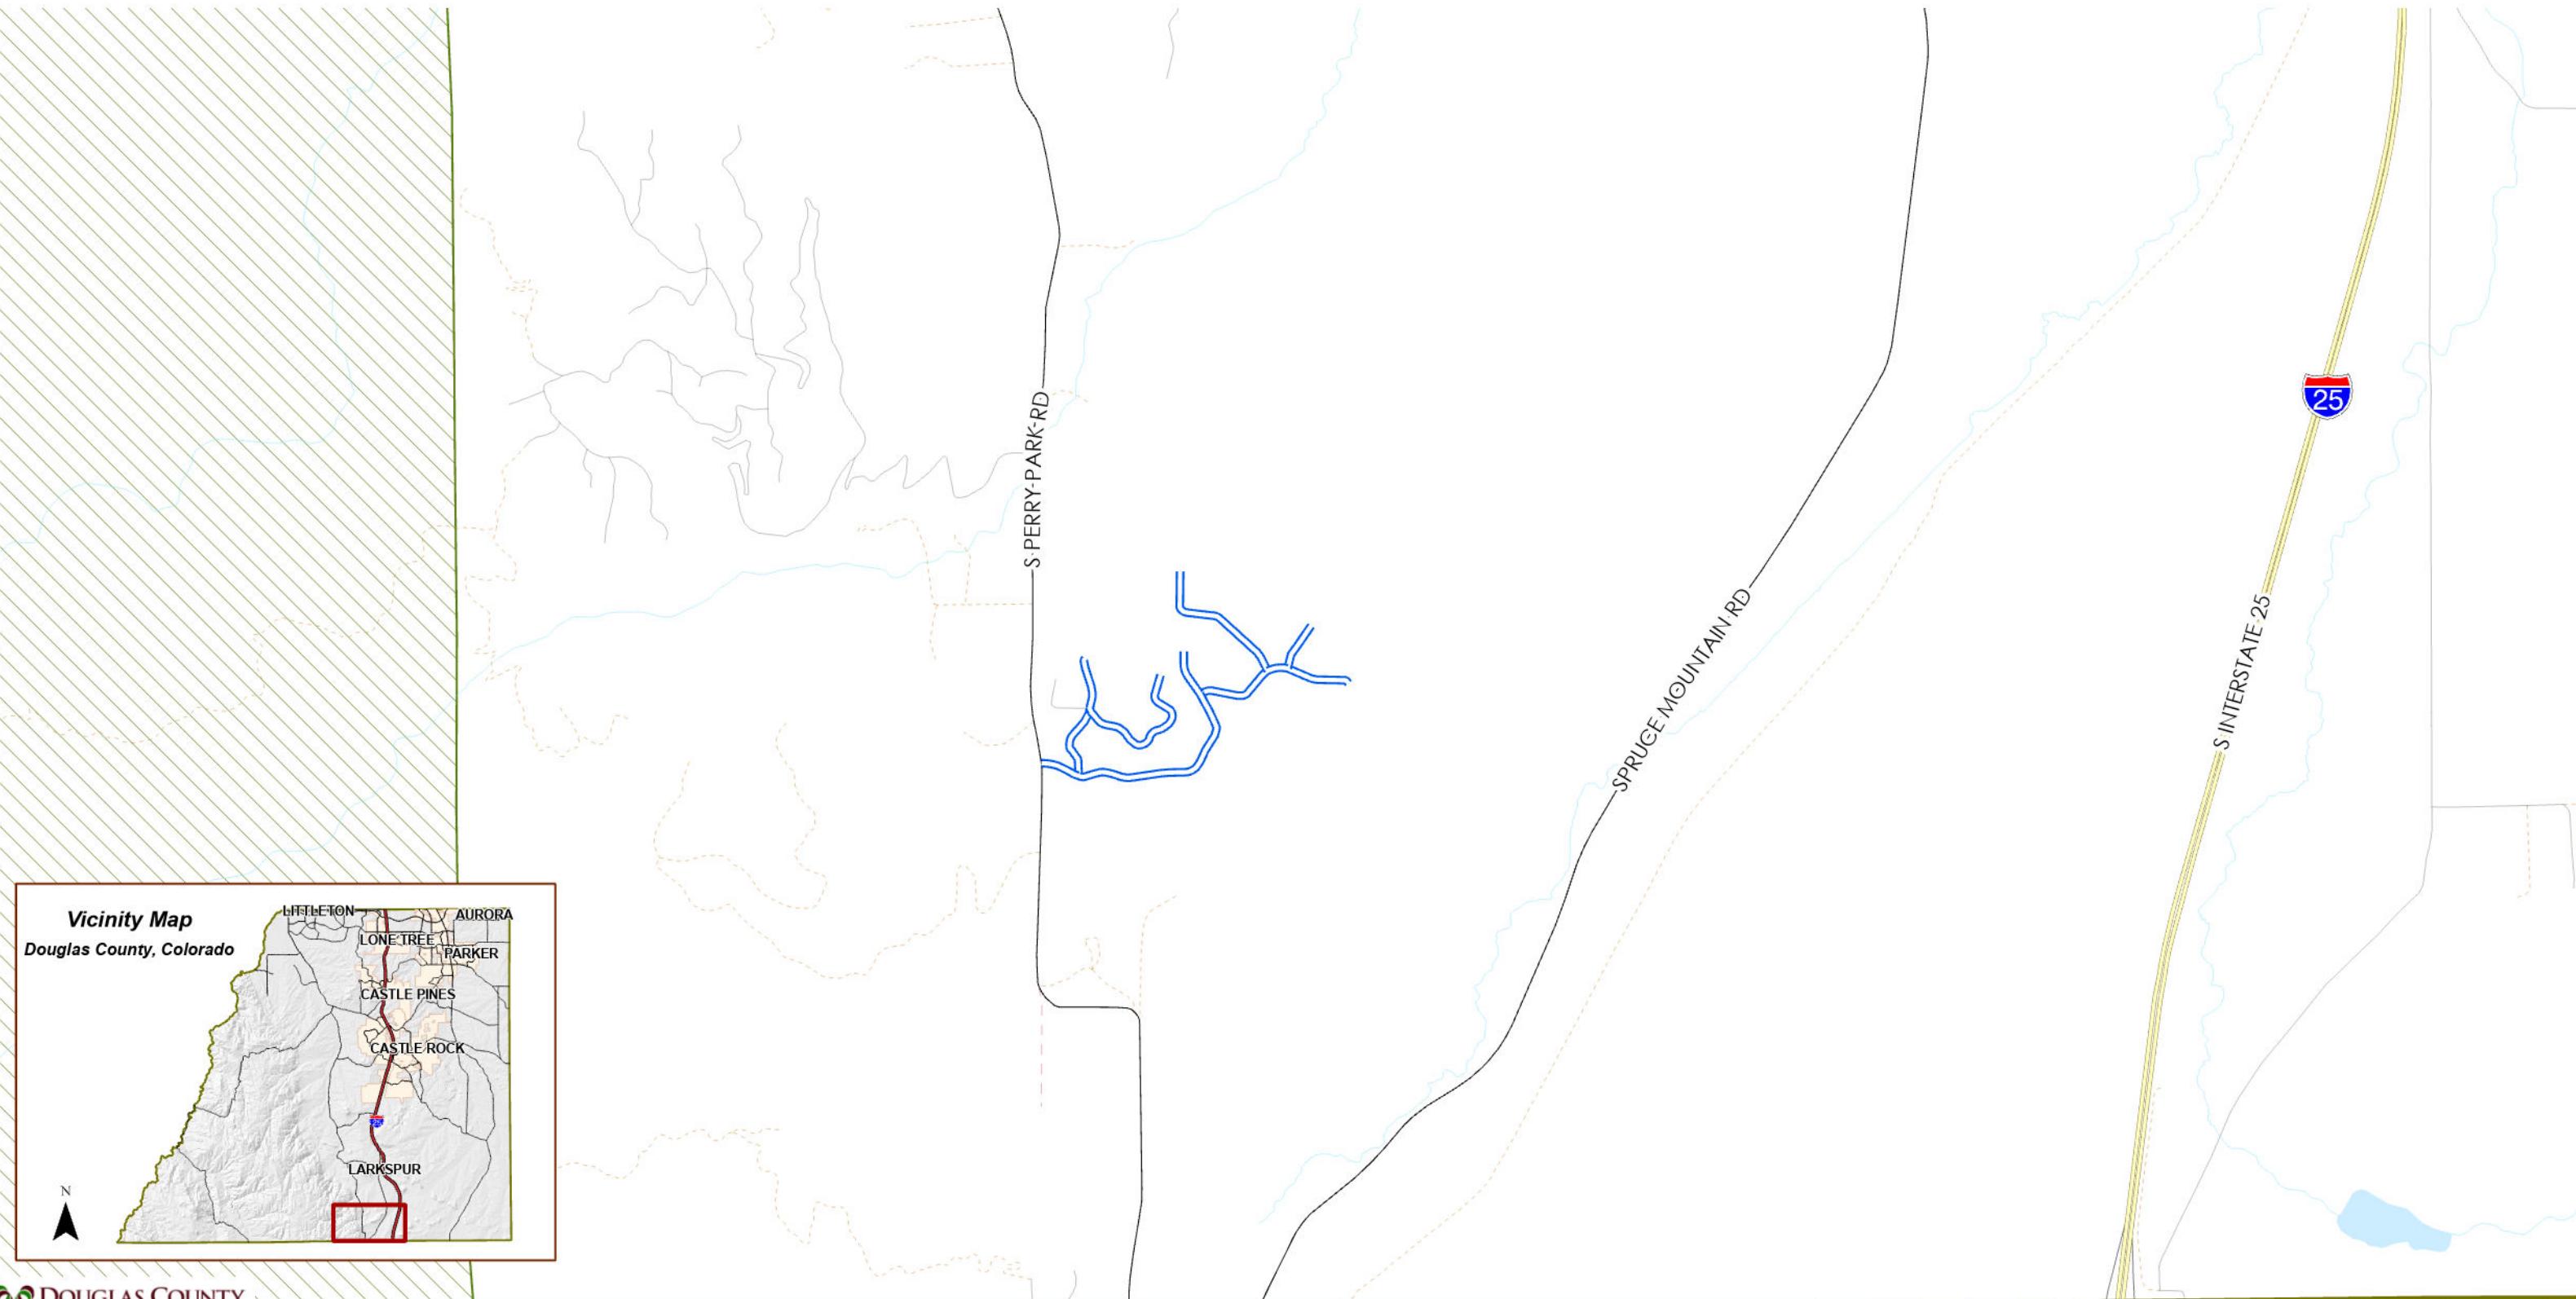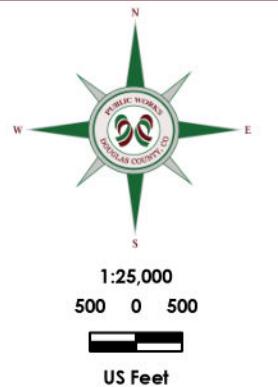

**As Built
2022 Contract Maintenance Projects
Douglas County, Colorado**

- Asphalt Full Depth — Roads
- County Boundary — State Highway
- Lakes — Local Road
- Intermittent Lakes — Private
- Streams

